MUNICIPAL ENGINEERING SUBDIVISIONS CITY AND FARM SURVEYS

D. D. ANDRUS & ASSOCIATES

STATE OF OHIO

REGISTERED { PROFESSIONAL ENG. / SURVEYOR

CIVIL ENGINEERS AND SURVEYORS

405 ELYRIA BLOCK

ELYRIA, OHIO

TELEPHONES FA 2-9828
FA 2-1466

M. W. JACKSON
SECRETARY

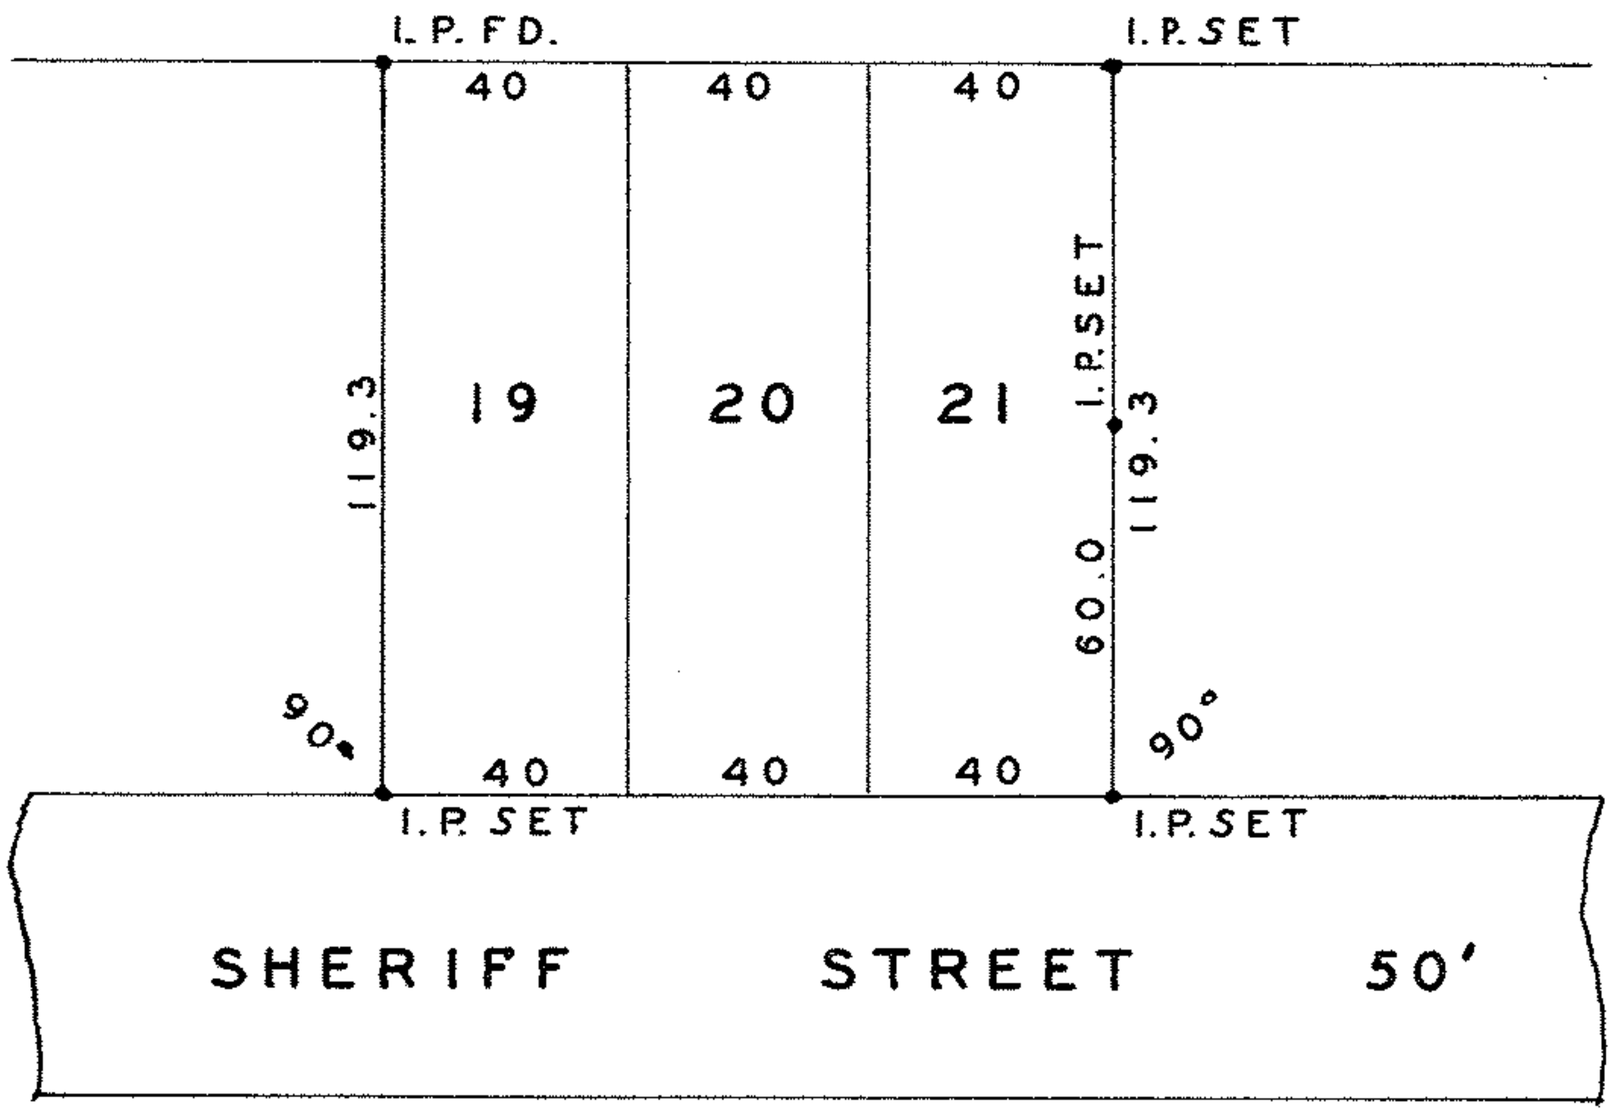

SURVEY FOR
DESSIE L. HOLLOWAY
190 Sheriff Street
LOTS 19-20-21 MAPLE RIDGE ALLOT
MAP VOL 6 PG 43 - 48
ELYRIA CITY, LORAIN CO. OHIO
SCALE 1" = 40' DEC. 1, 1966

Map Pg 6-61

PPN 06-24-036-107-018 019 020

200837