MAP OF SURVEY MADE FOR

Harshaw - Fuller - and Goodwin Co.

part of lots 544 & 545

Part of Block 98 Heman Ely's Addn. Vol. 1, Pg 35

Courses are assumed for descriptive purposes

Lorain County, Ohio

Distances are given in feet and decimal parts

Scale, 1 in. = 30 Feet

Elyria, O., Feb. 12, 1929

Order No.,

F. B. L.L. Pg.,

200190 A

Warden & Laundon, C. E.
403 ELYRIA BLOCK

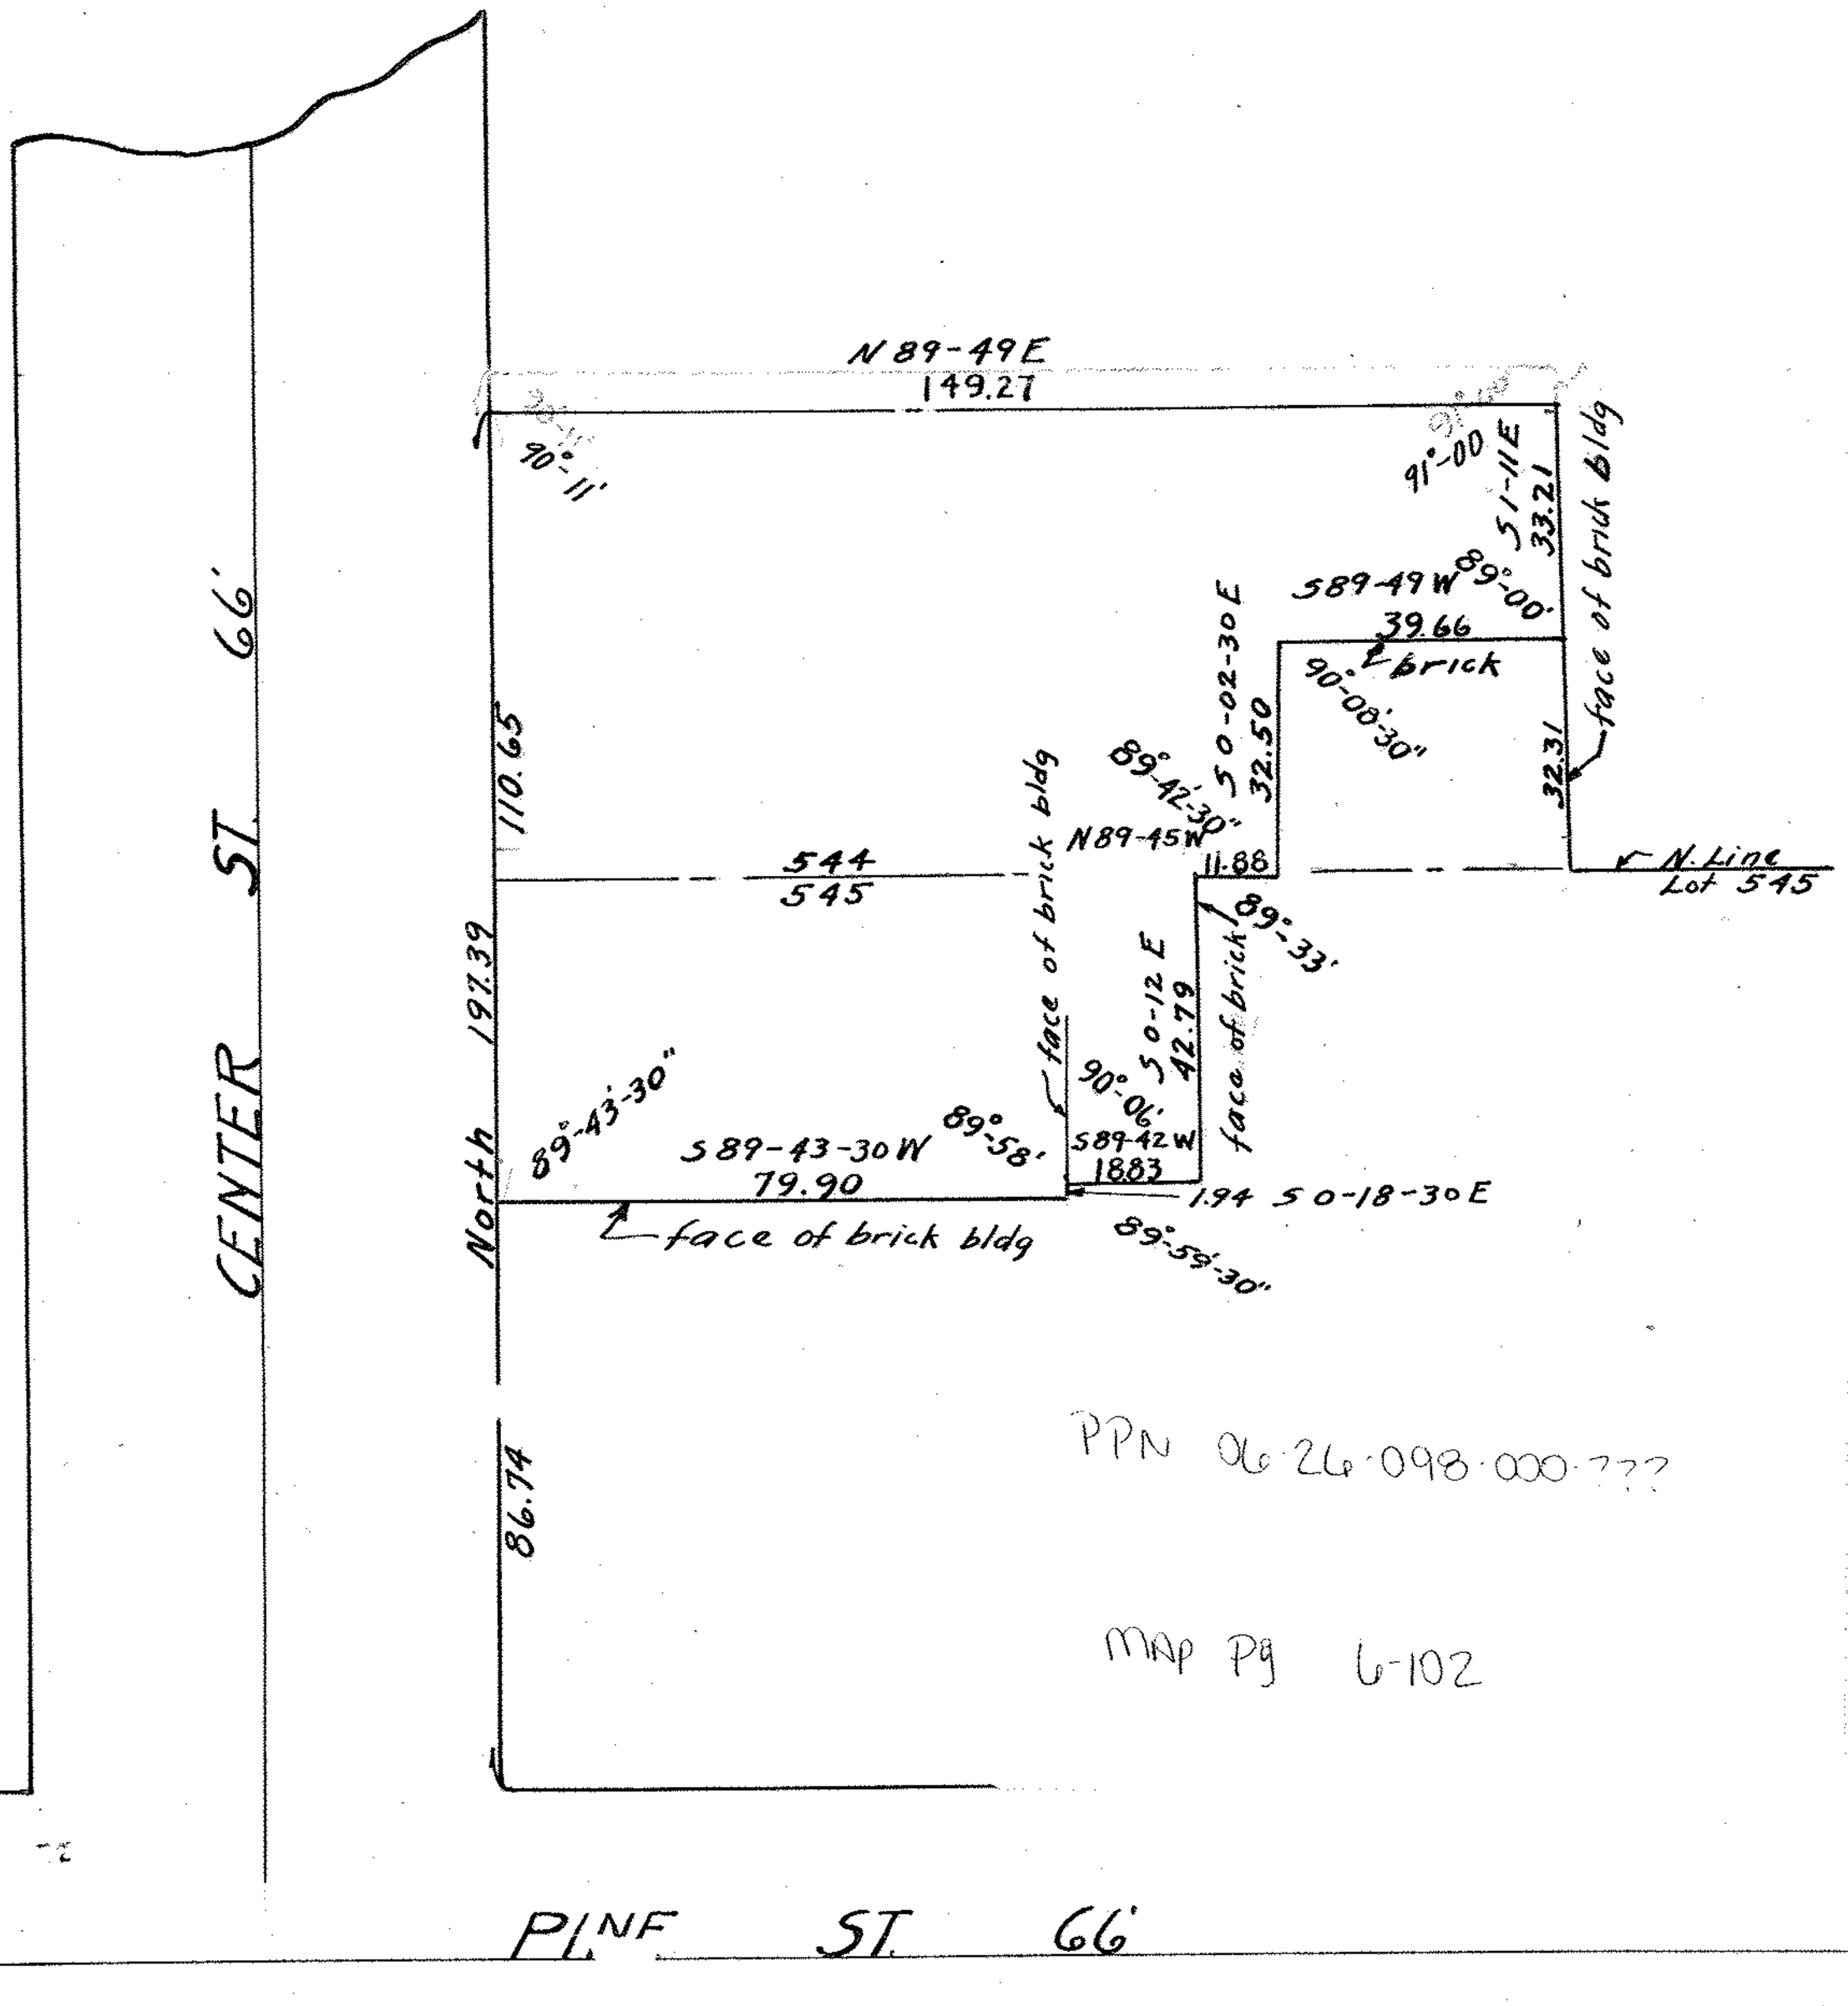

PPN 06-26-098-000-???

MAP Pg 6-102