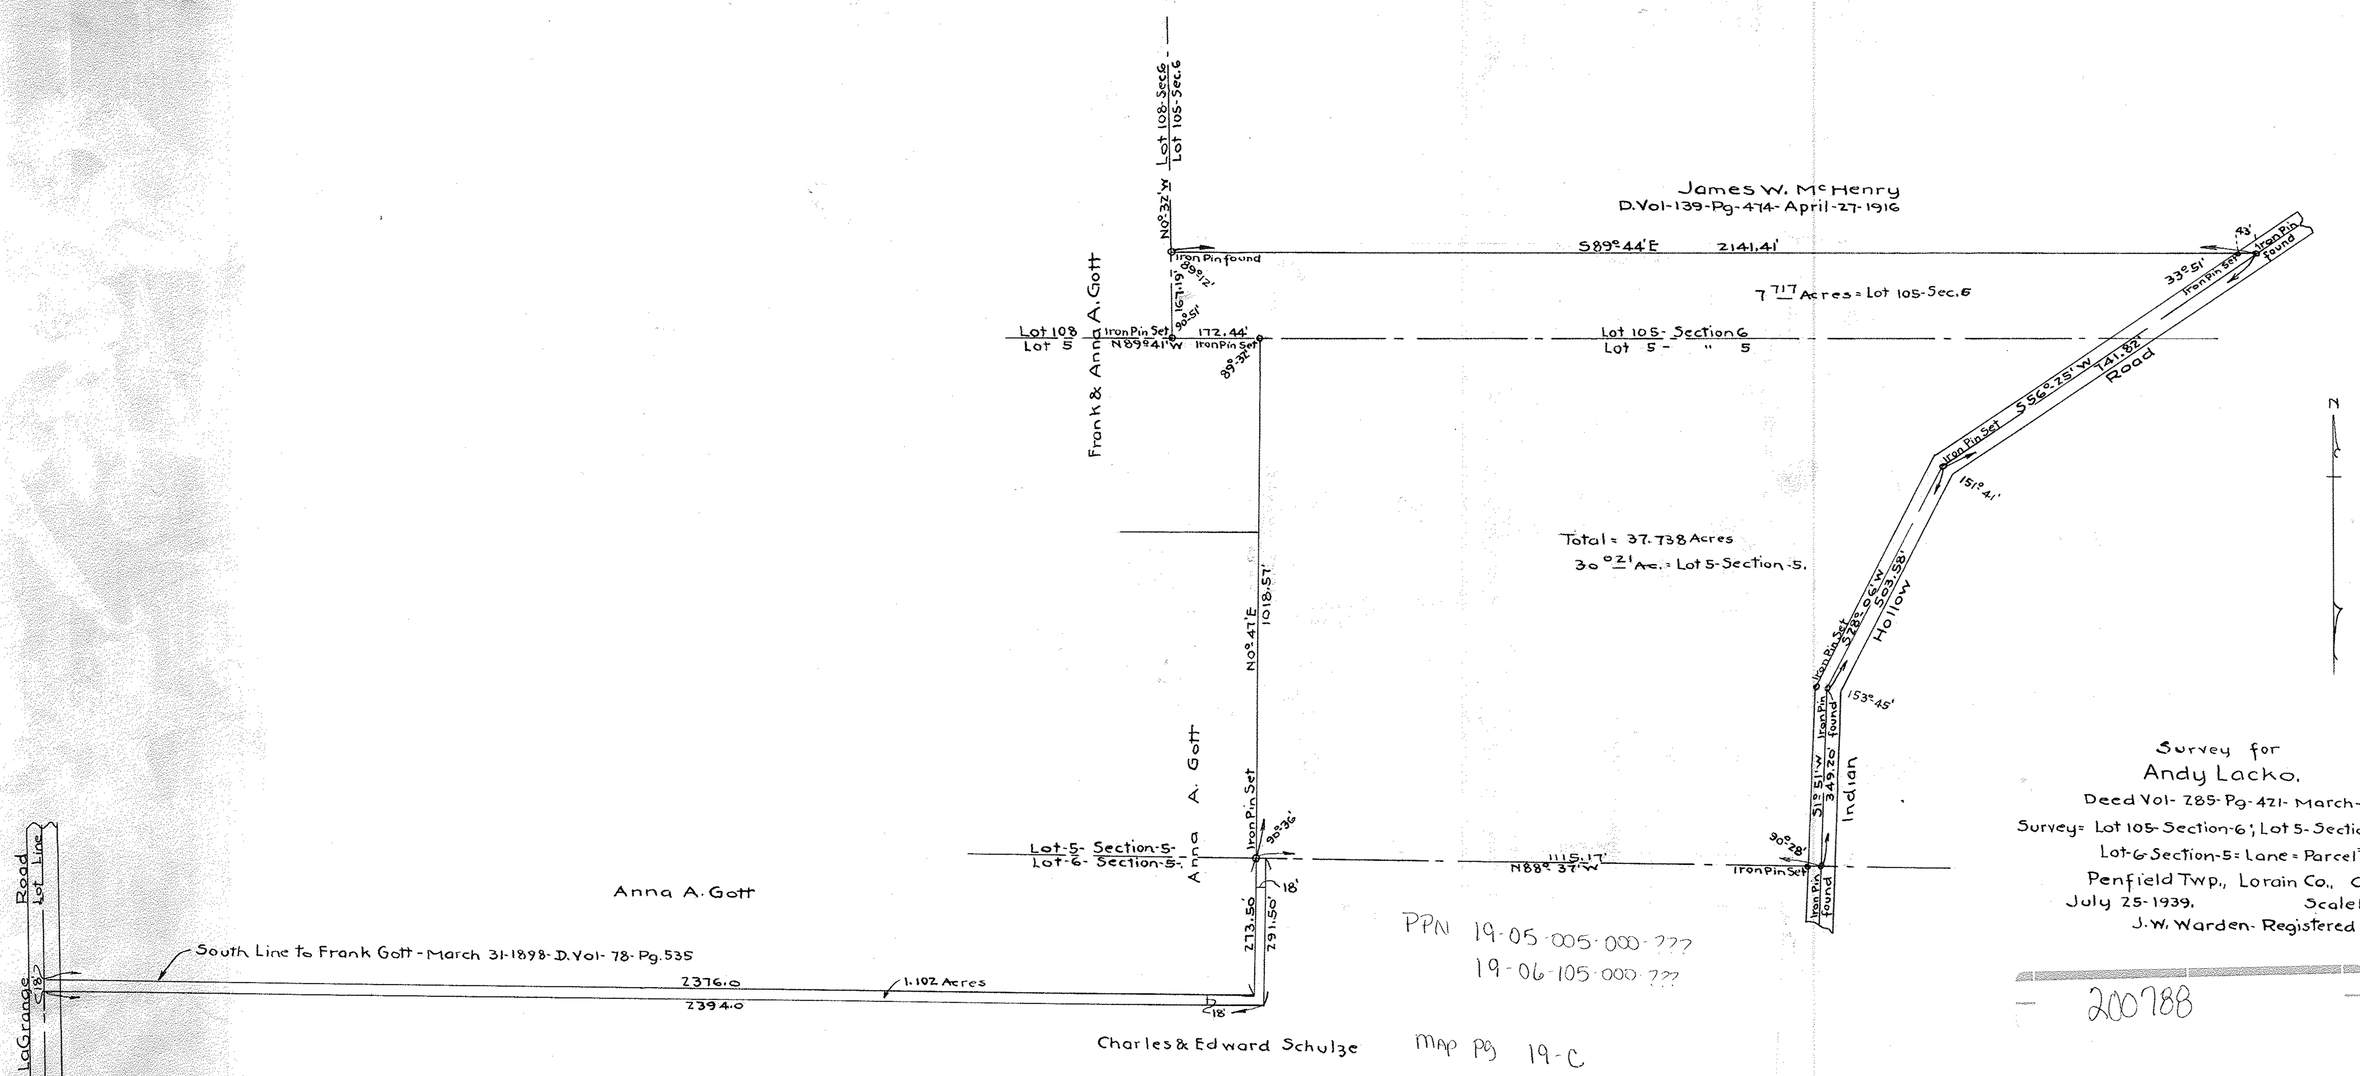
James W. McHenry
D.Vol-139-Pg-474-April-27-1916
Lot 108-Sec.6
Lot 105-Sec.6
N0°32'W
Iron Pin found
S89°44'E 2141.41'
7 7/17 Acres = Lot 105-Sec.6
Lot 108
Lot 5
Frank & Anna A. Gott
Iron Pin Set
N89°41'W
172.44'
Iron Pin Set
Lot 105- Section 6
Lot 5 - " 5
Total = 37.738 Acres
30 0/21 Ac. = Lot 5-Section-5.
N0°41'E
1018.51'
Anna A. Gott
Iron Pin Set
Lot-5- Section-5-
Lot-6- Section-5-
N88°37'W
1115.17'
Iron Pin Set
Anna A. Gott
South Line to Frank Gott - March 31-1898- D.Vol- 78- Pg.535
2376.0
2394.0
1.102 Acres
273.50'
291.50'
18'
Charles & Edward Schulze
Map Pg 19-C
PPN 19-05-005-000-???
19-06-105-000-???
LaGrange Road
Lot Line
Iron Pin found
33°51'
Iron Pin Set
Iron Pin found
Road
S56°25'W
741.82'
Iron Pin Set
151°41'
Iron Pin Set
S28°06'W
503.58'
Hollow
153°45'
Iron Pin found
S1°51'W
349.20'
Indian
90°28'
Iron Pin Set
Iron Pin found
N
Survey for
Andy Lacko.
Deed Vol- 285- Pg- 421- March-2-1937.
Survey= Lot 105-Section-6; Lot 5-Section-5- Parcel #1.
Lot-6 Section-5= Lane = Parcel #2.
Penfield Twp., Lorain Co., Ohio.
July 25-1939. Scale 1" = 200ft.
J.W. Warden- Registered Surveyor.
200788