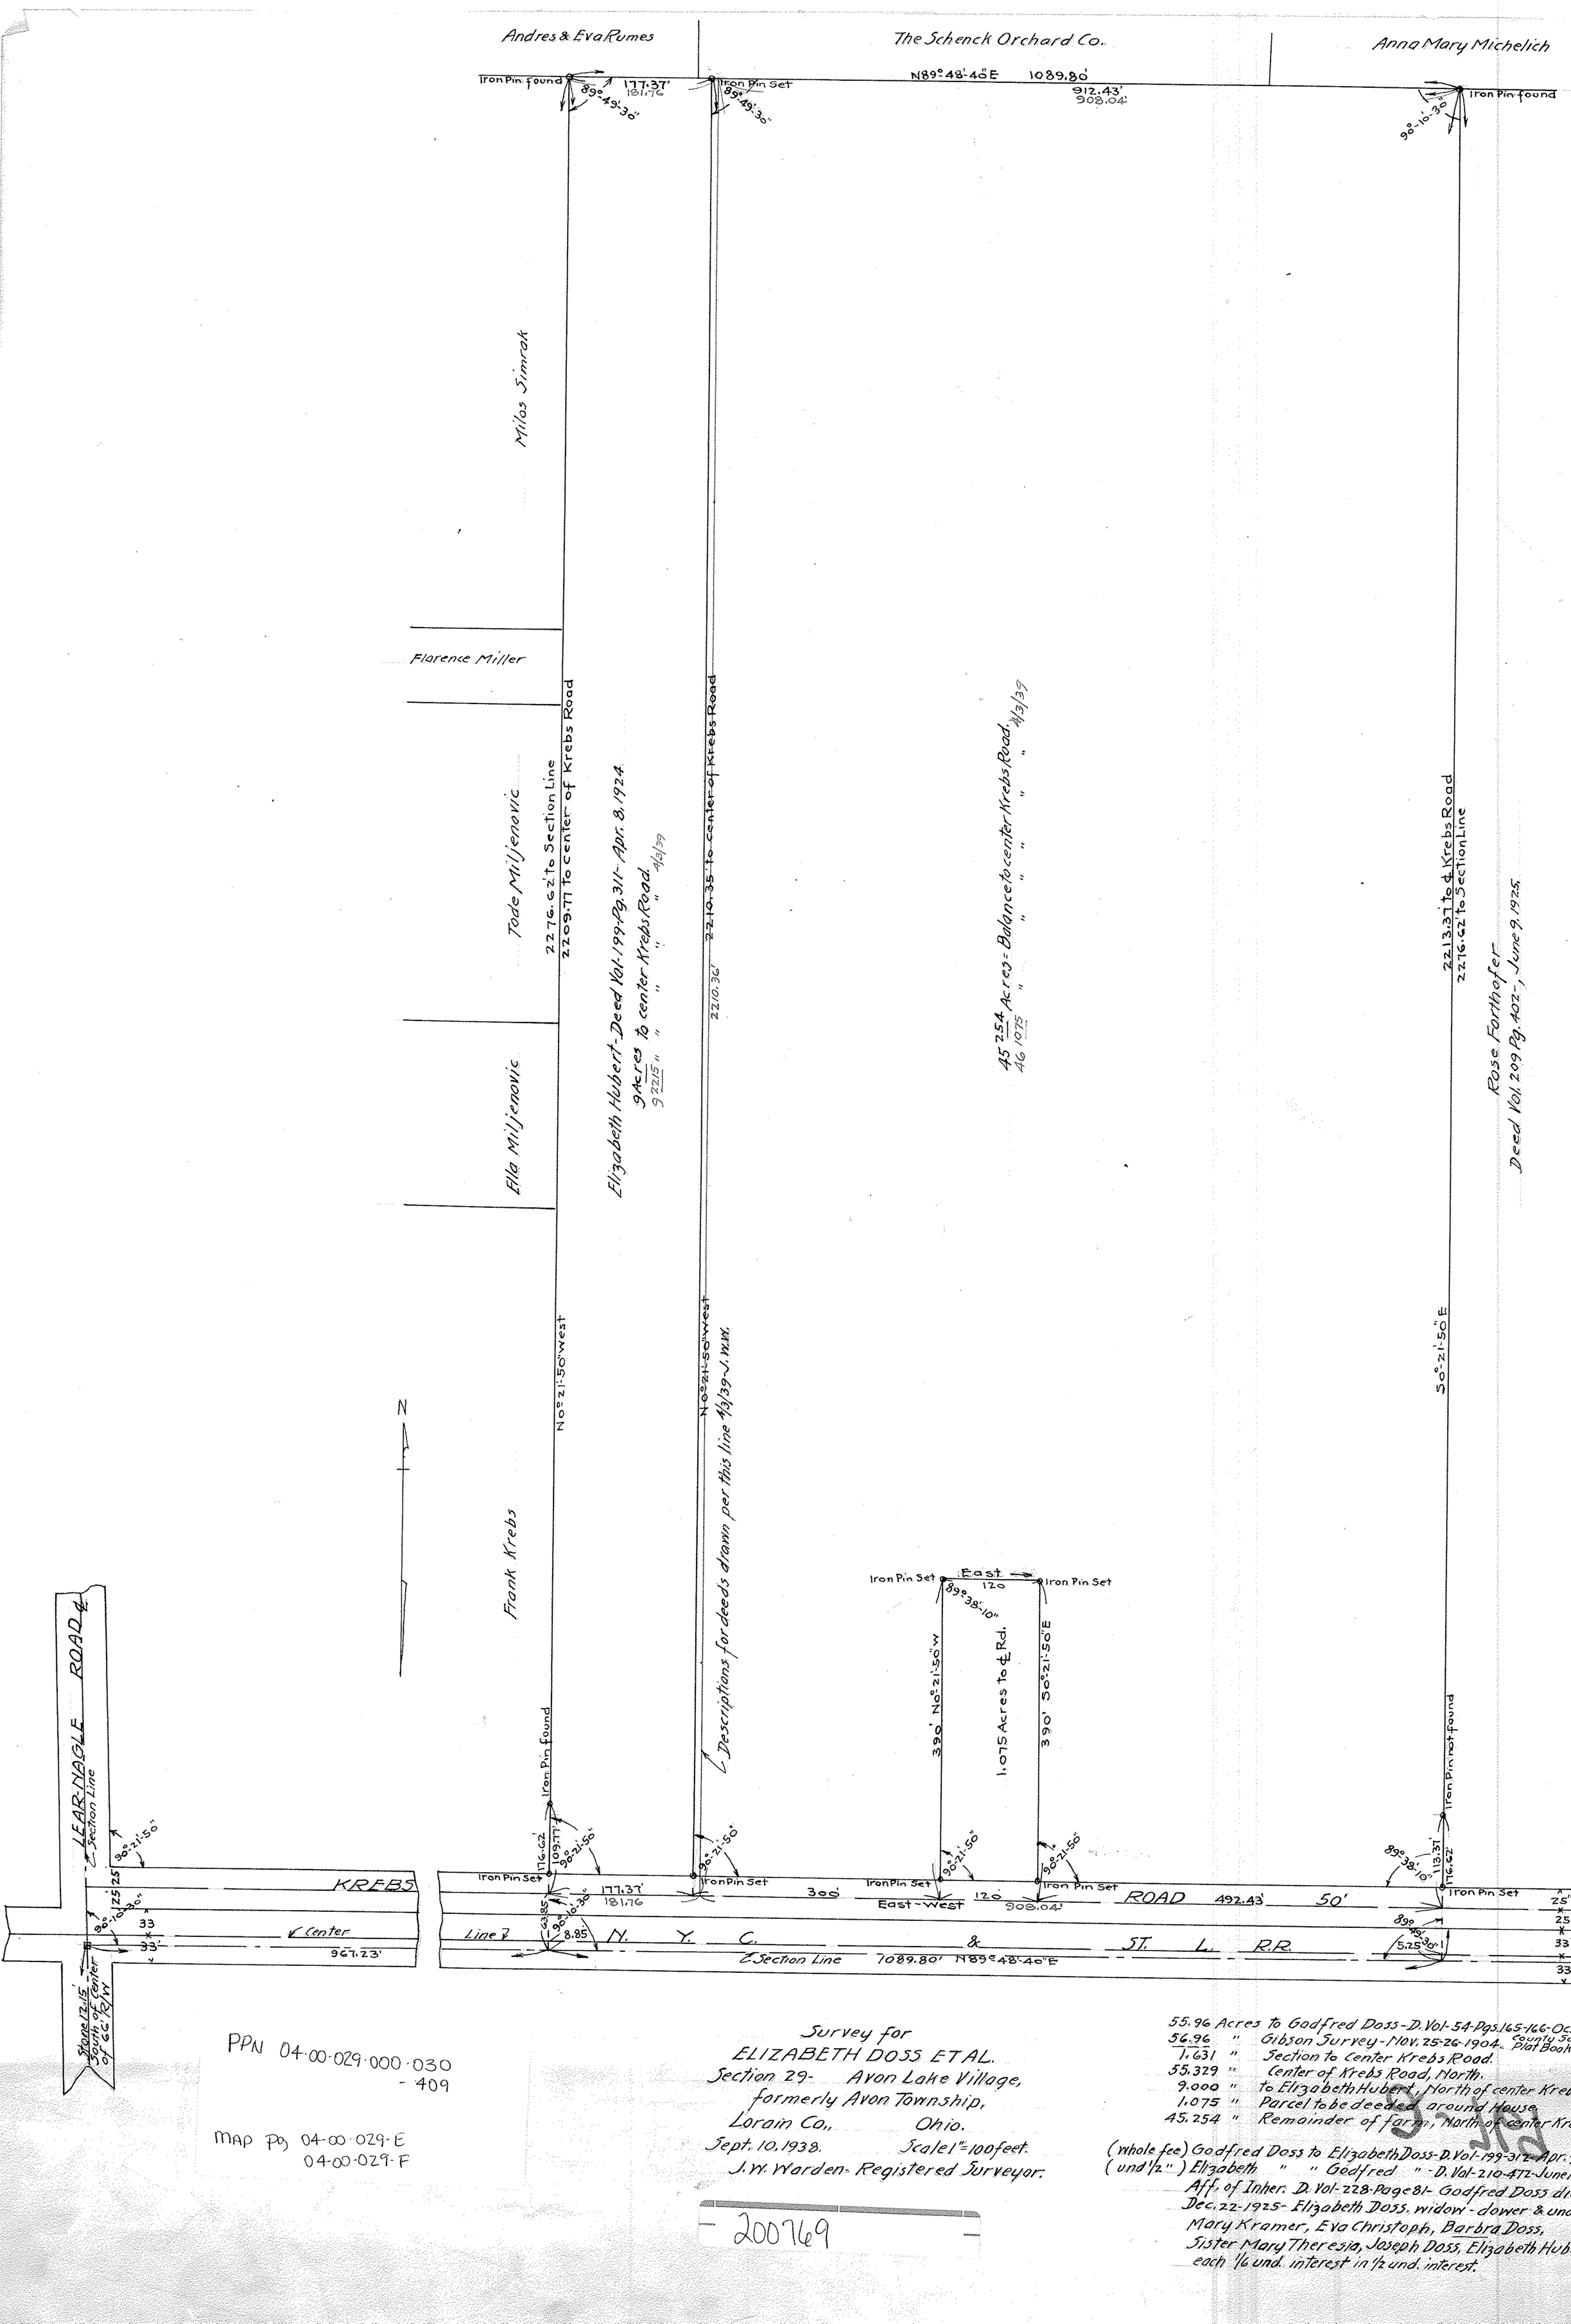

PPN 04-00-029-000-030
- 409

MAP PG 04-00-029-E
04-00-029-F

Survey for
ELIZABETH DOSS ET AL.
Section 29- Avon Lake Village,
formerly Avon Township,
Lorain Co., Ohio.
Sept. 10, 1938. Scale 1" = 100 feet.
J. W. Warden - Registered Surveyor.

- 200769 -

55.96 Acres to Godfred Doss - D. Vol-54-Pgs. 165-166-Oct. 10, 1883.
56.96 " Gibson Survey - Nov. 25-26-1904. County Surveyors Plat Book-3-Pg. 29.
1.631 " Section to Center Krebs Road.
55.329 " Center of Krebs Road, North.
9.000 " to Elizabeth Hubert, North of center Krebs Road.
1.075 " Parcel to be deeded around House.
45.254 " Remainder of farm, North of center Krebs Road.

(whole fee) Godfred Doss to Elizabeth Doss - D. Vol-199-312 - Apr. 9, 1924.
(und 1/2 ") Elizabeth " " Godfred " - D. Vol-210-472 - June 11, 1925.
Aff. of Inher. D. Vol-228-Page 81 - Godfred Doss died Dec. 22-1925 - Elizabeth Doss, widow - dower & und. 1/2 int.
Mary Kramer, Eva Christoph, Barbra Doss, Sister Mary Theresia, Joseph Doss, Elizabeth Hubert, each 1/6 und. interest in 1/2 und. interest.