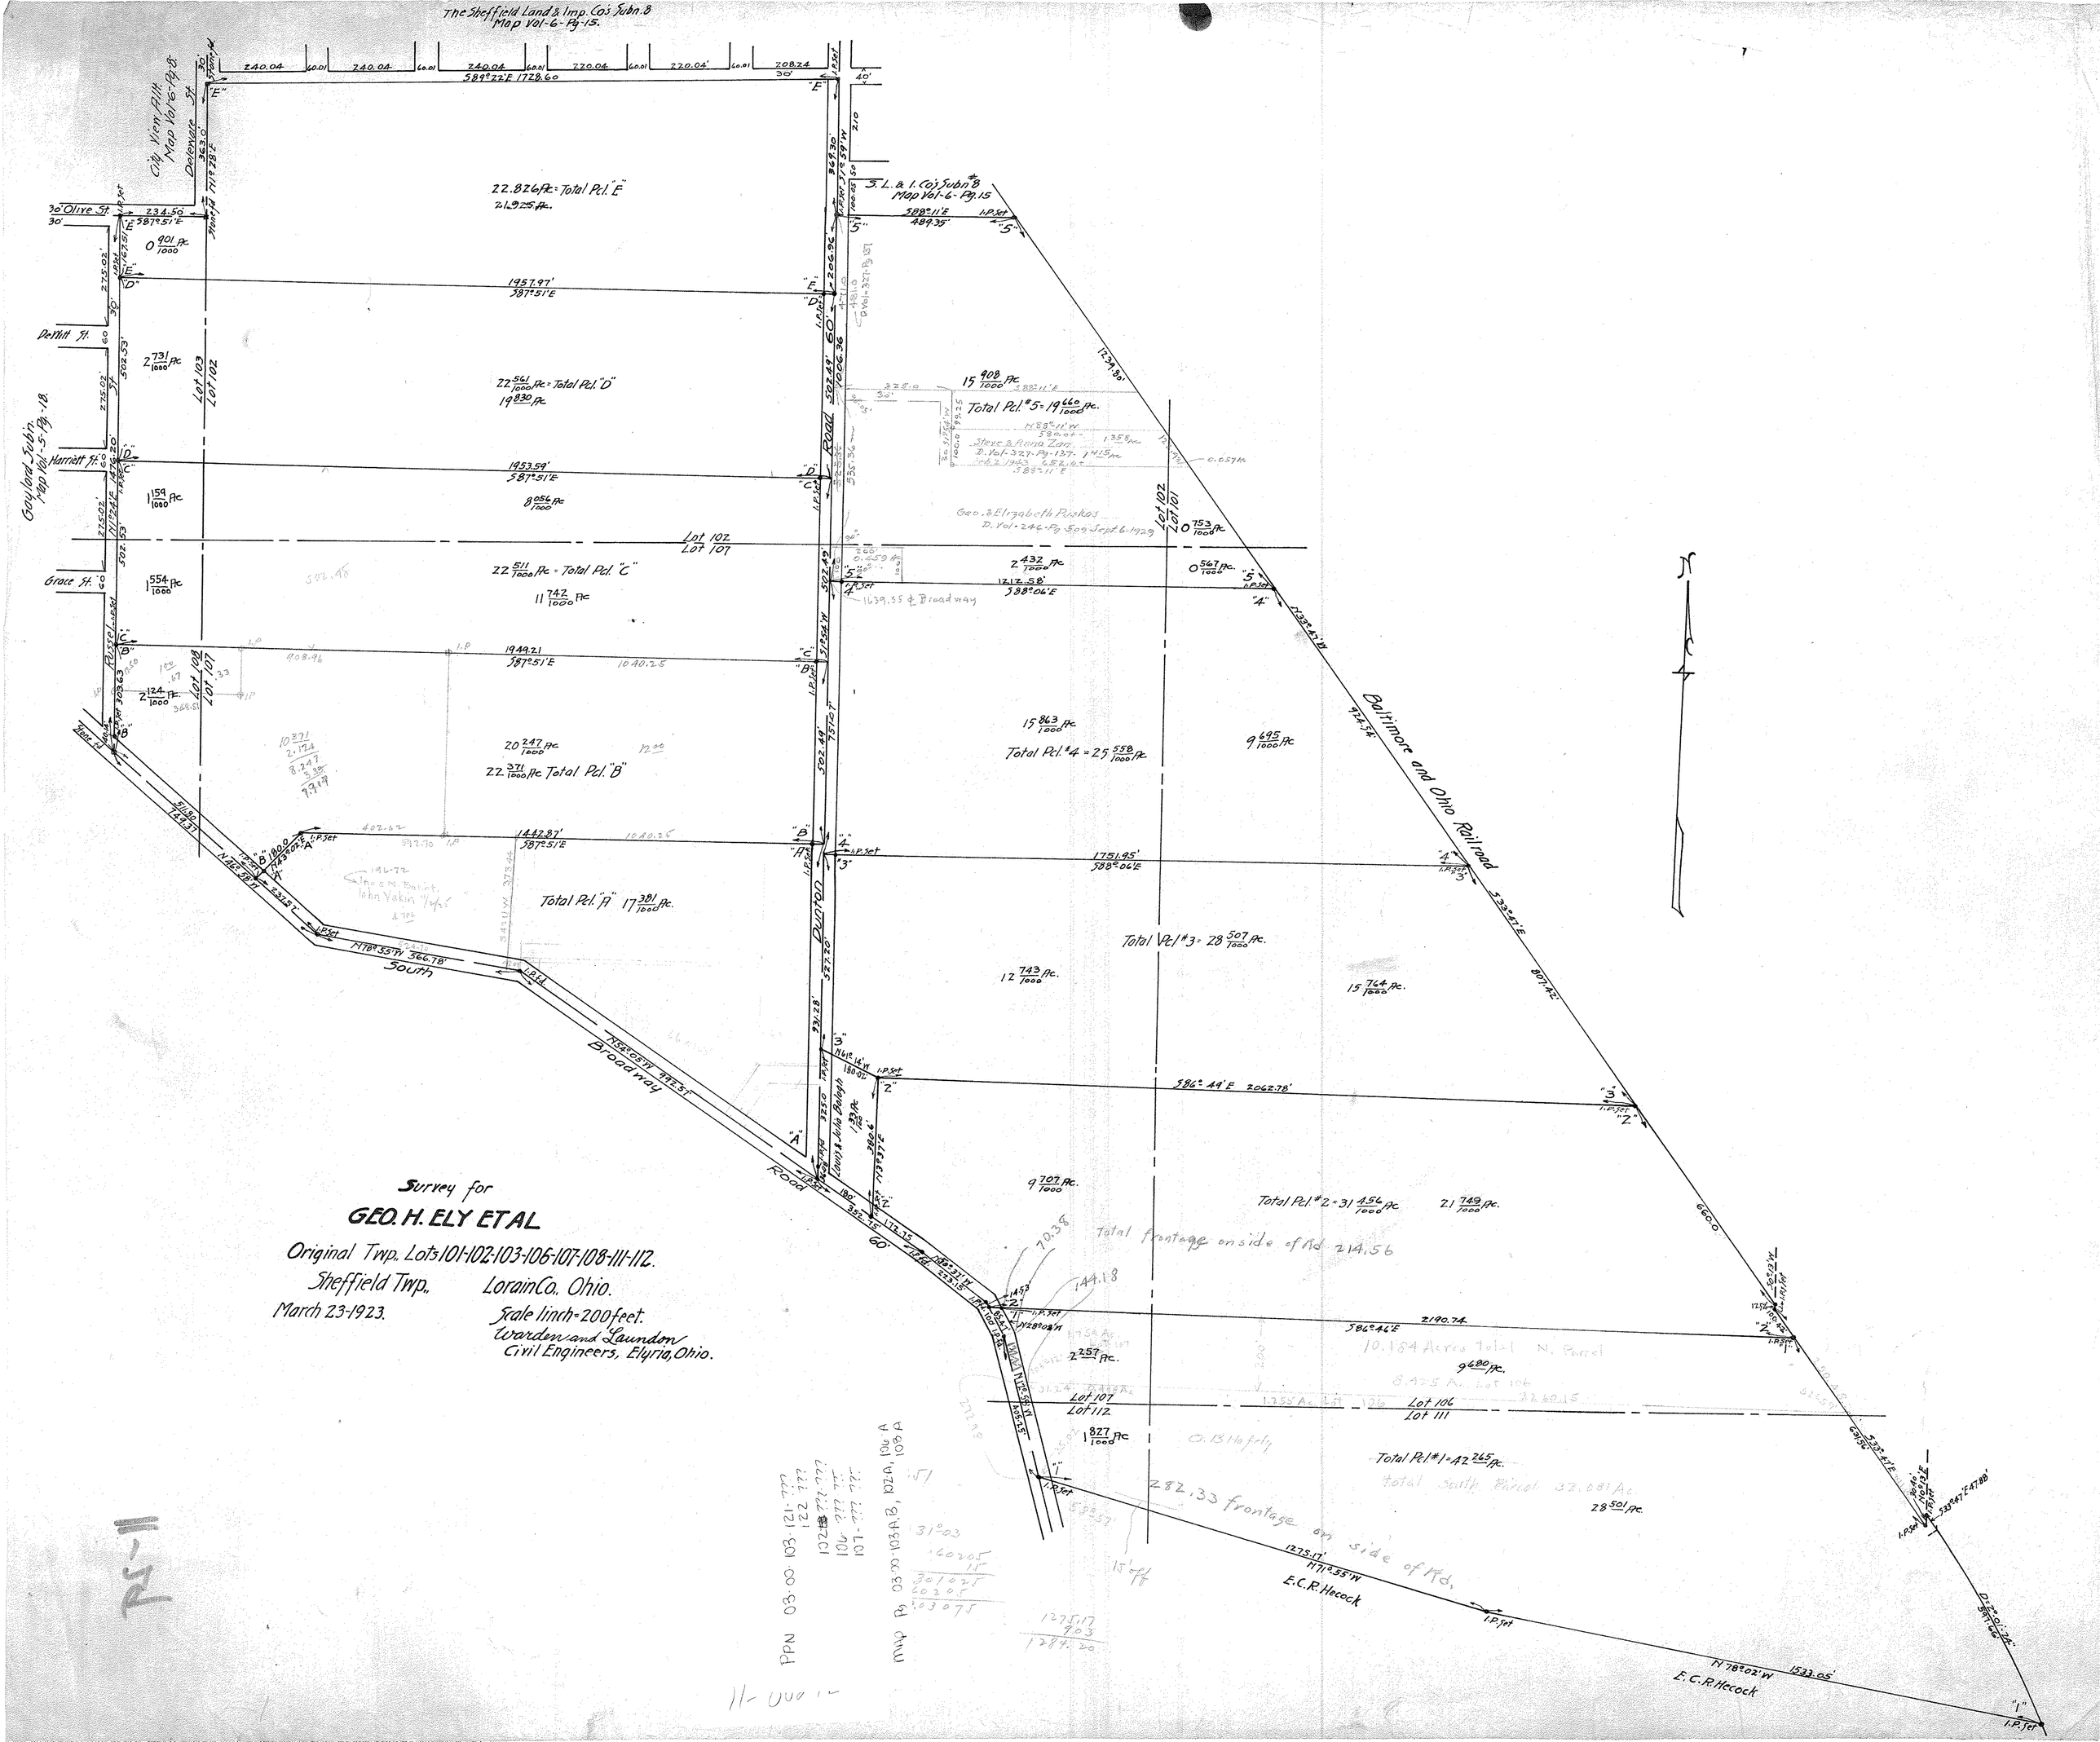
The Sheffield Land & Imp. Co's Subn. 8
Map Vol-6-Pg-15.
City View Plat
Map Vol-6-Pg-8
Delevan St.
Olive St.
DeWitt St.
Harriett St.
Grace St.
Russel St.
Gaylord Subn.
Map Vol-5-Pg-18.
S. L. & I. Co's Subn #8
Map Vol-6-Pg.15
22.826 Ac = Total Pcl. "E"
21.925 Ac.
22 561/1000 Ac = Total Pcl. "D"
19 830 Ac.
22 511/1000 Ac = Total Pcl. "C"
11 742/1000 Ac
20 247/1000 Ac
22 371/1000 Ac Total Pcl. "B"
Total Pcl. "A" 17 381/1000 Ac.
Total Pcl. #5 = 19 660/1000 Ac.
Total Pcl. #4 = 25 558/1000 Ac.
Total Pcl. #3 = 28 507/1000 Ac.
Total Pcl. #2 = 31 456/1000 Ac
Total Pcl. #1 = 42 265/1000 Ac.
Steve & Anna Zore
D. Vol-327-Pg-137
Geo. & Elizabeth Piskos
D. Vol-246-Pg-509 Sept 6-1929
Lot 101
Lot 102
Lot 103
Lot 106
Lot 107
Lot 108
Lot 111
Lot 112
Duxton
Broadway
Road
South
Baltimore and Ohio Railroad
Louis & Julia Balogh
E.C.R. Hecock
Total frontage on side of Rd 214.56
282.33 frontage on side of Rd.
Survey for
GEO. H. ELY ET AL
Original Twp., Lots 101-102-103-106-107-108-111-112.
Sheffield Twp., Lorain Co., Ohio.
March 23-1923.
Scale 1 inch = 200 feet.
Warden and Launder
Civil Engineers, Elyria, Ohio.