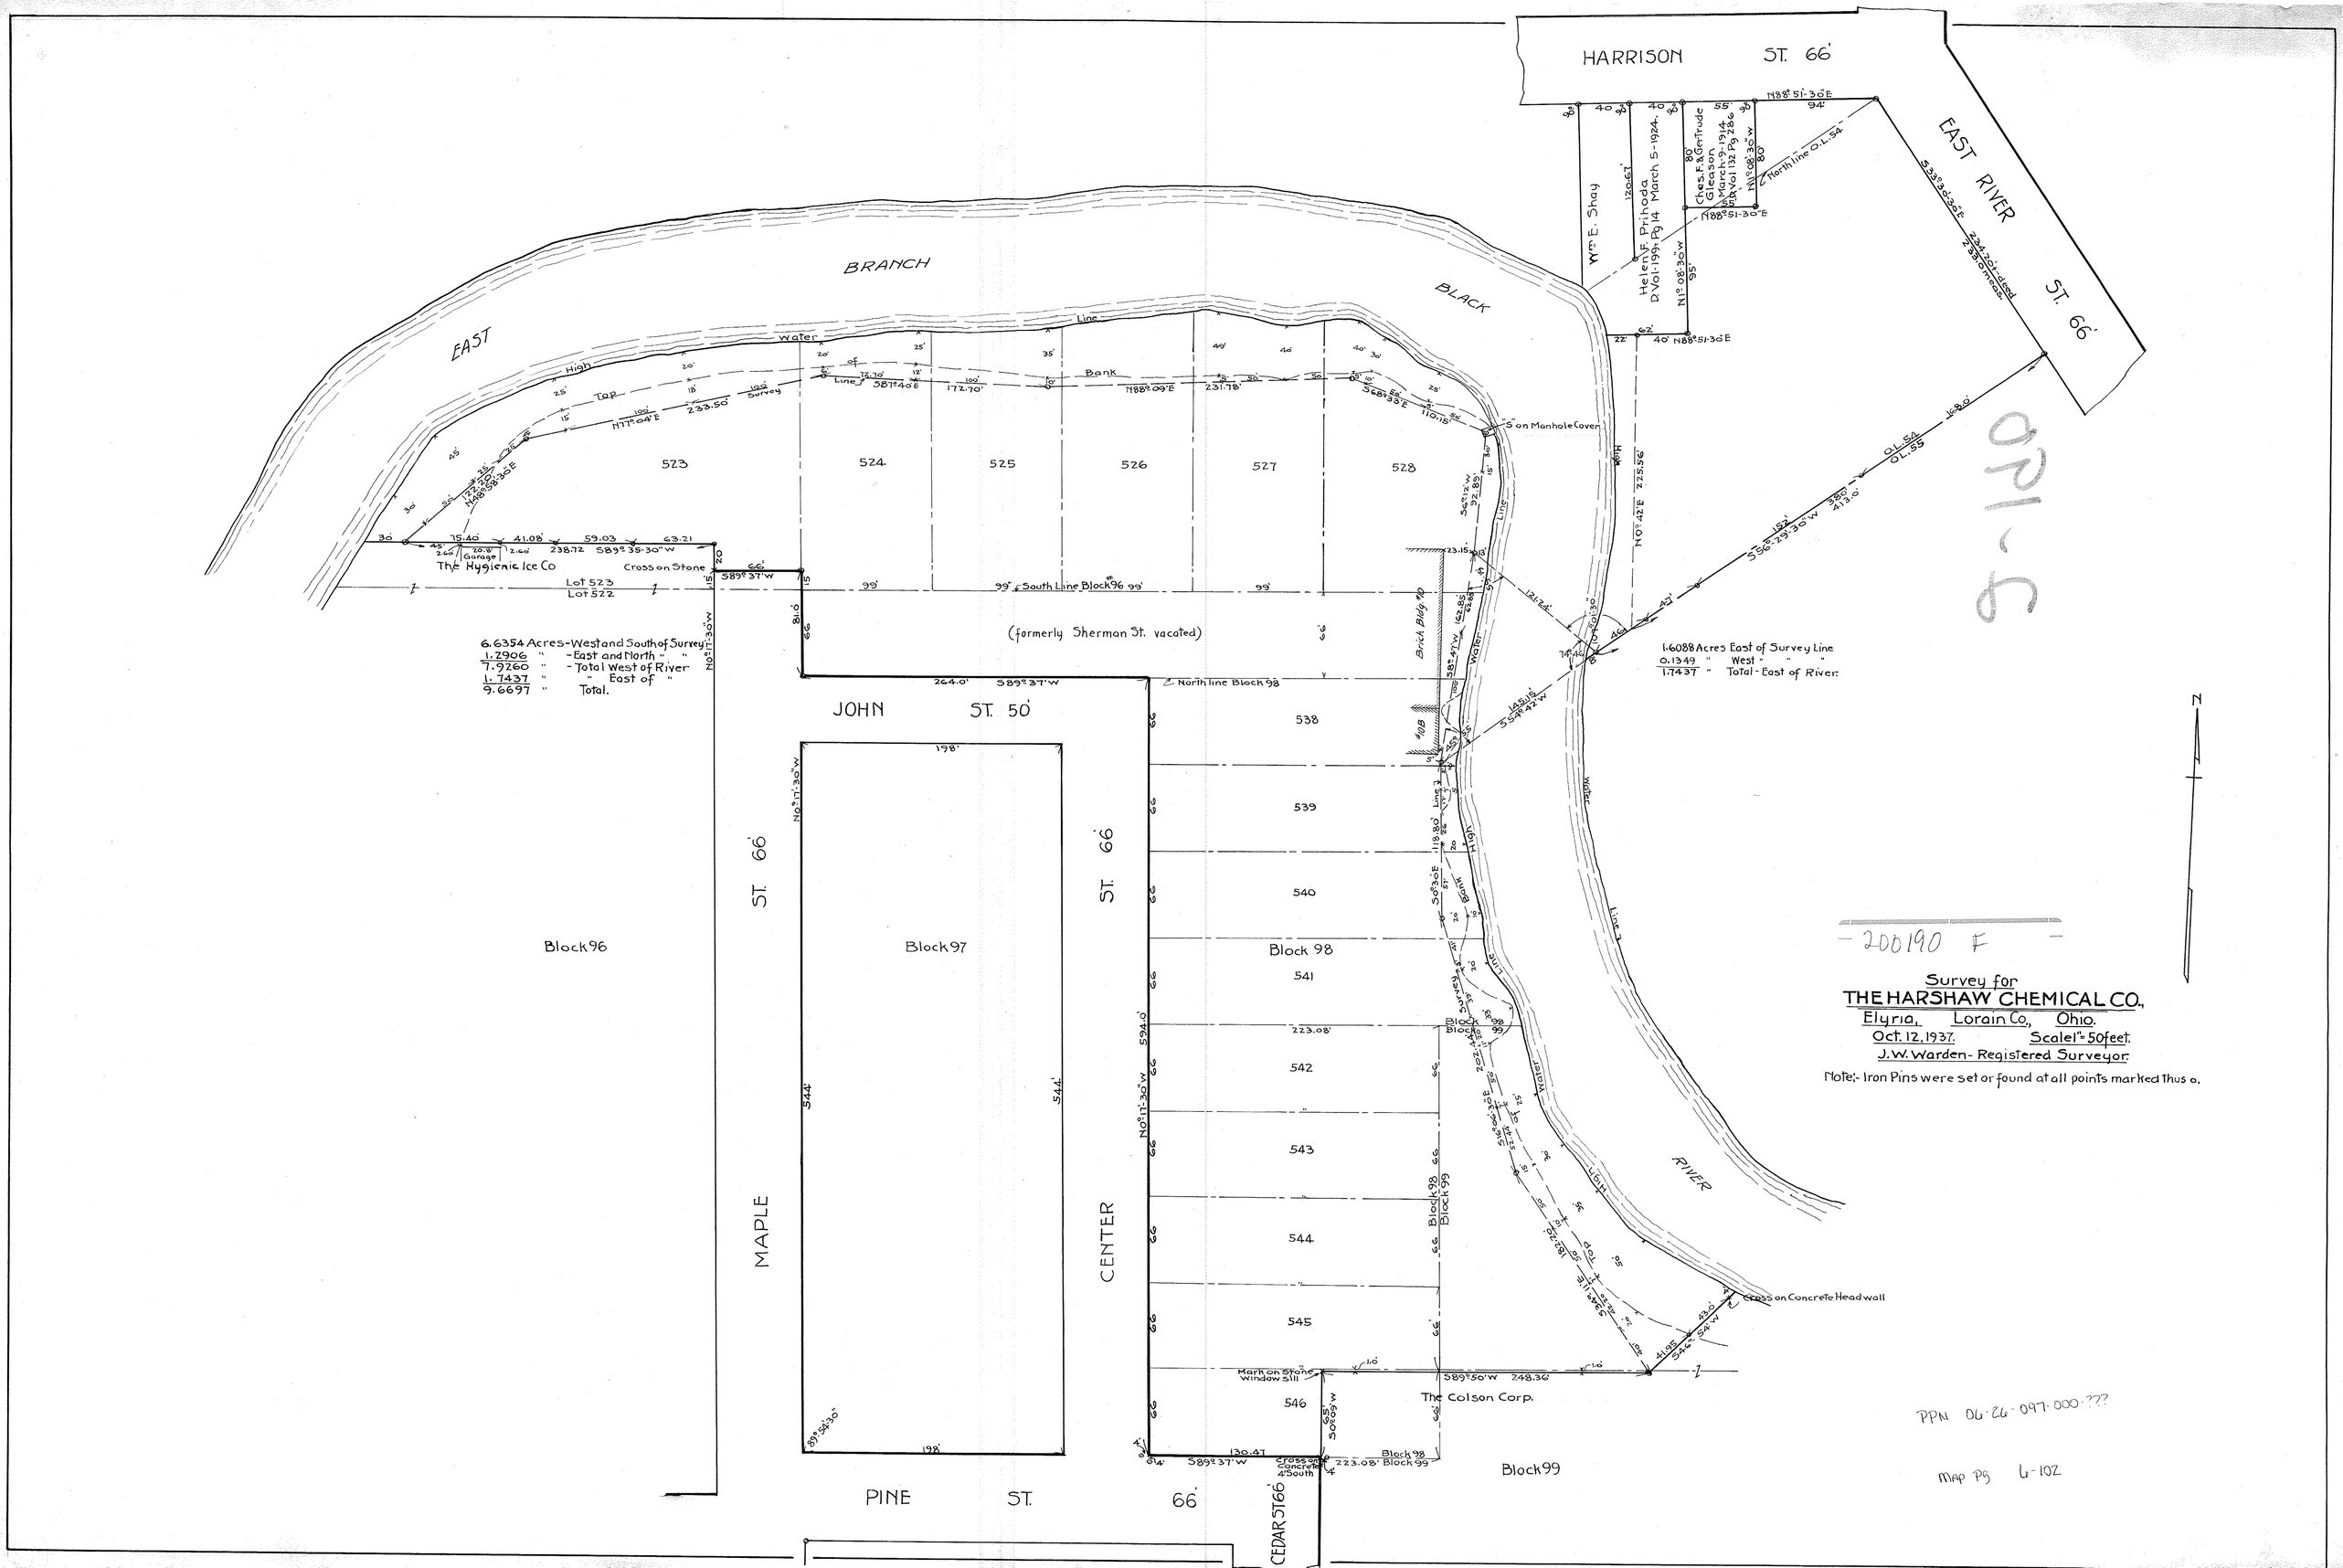
HARRISON ST. 66'
EAST RIVER ST. 66'
EAST BRANCH BLACK RIVER
High Water Line
Top of Bank
Survey Line
Wm. E. Shay
Helen F. Prihoda D. Vol. 199 Pg 14 March 5-1924.
Chas. F. & Gertrude Gleason G.R. Vol 132 Pg 286 March 9-1914
North line O.L. 54
O.L. 54
O.L. 55
523
524
525
526
527
528
The Hygienic Ice Co
Garage
Cross on Stone
Lot 523
Lot 522
South Line Block 96
(formerly Sherman St. vacated)
Brick Bldg.
Water
6.6354 Acres-West and South of Survey
1.2906 " - East and North " "
7.9260 " - Total West of River
1.7437 " " East of "
9.6697 " Total.
1.6088 Acres East of Survey Line
0.1349 " West " "
1.7437 " Total - East of River.
JOHN ST. 50'
North line Block 98
538
539
540
541
542
543
544
545
546
Block 98
Block 99
Block 96
Block 97
MAPLE ST. 66'
CENTER ST. 66'
PINE ST. 66'
CEDAR ST. 66'
544'
198'
Mark on Stone Window Sill
The Colson Corp.
Cross on Concrete Headwall
Cross on Concrete 4' South
Line 3
Line 4
Line