


2-811-1e

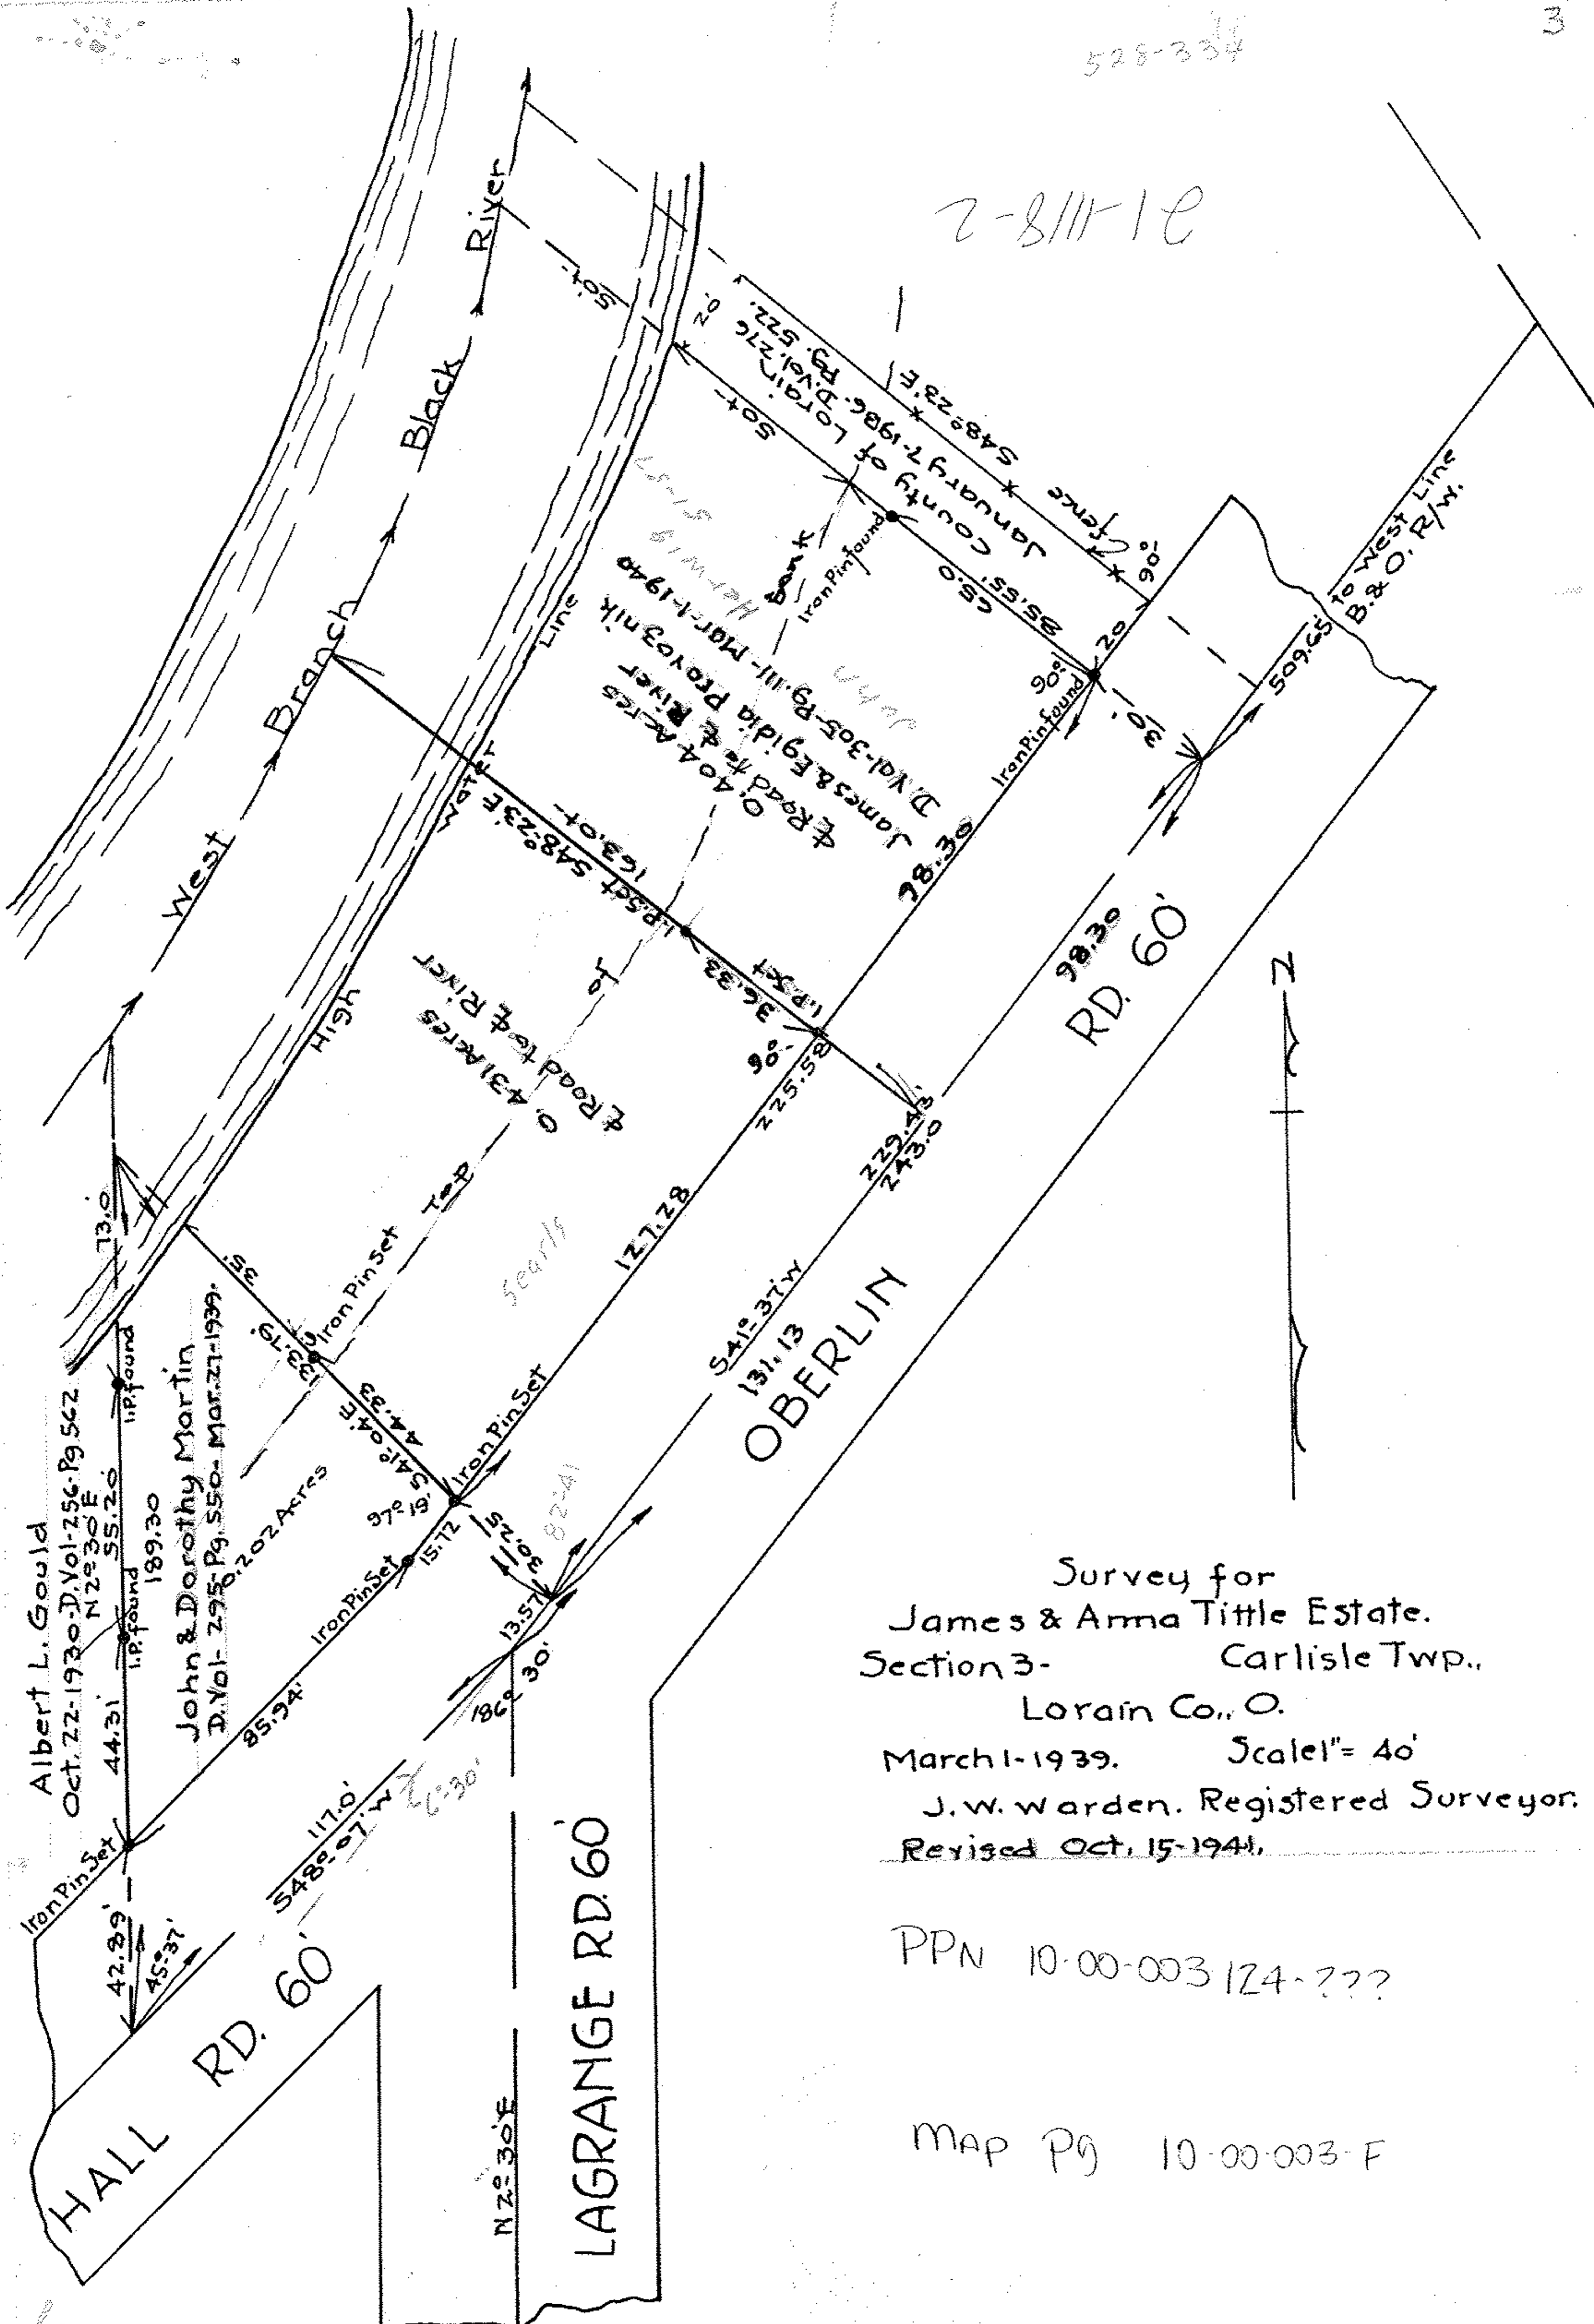

Survey for
 James & Arma Tittle Estate.
 Section 3- Carlisle Twp.,
 Lorain Co., O.
 March 1-1939. Scale 1" = 40'
 J. W. Warden, Registered Surveyor.
 Revised Oct. 15-1941.

PPN 10-00-003 124-???

MAP Pg 10-00-003-F

See Warden Blk-1-Pg 18.
 " W.&L. " 24-Pg 26. 44