31-133

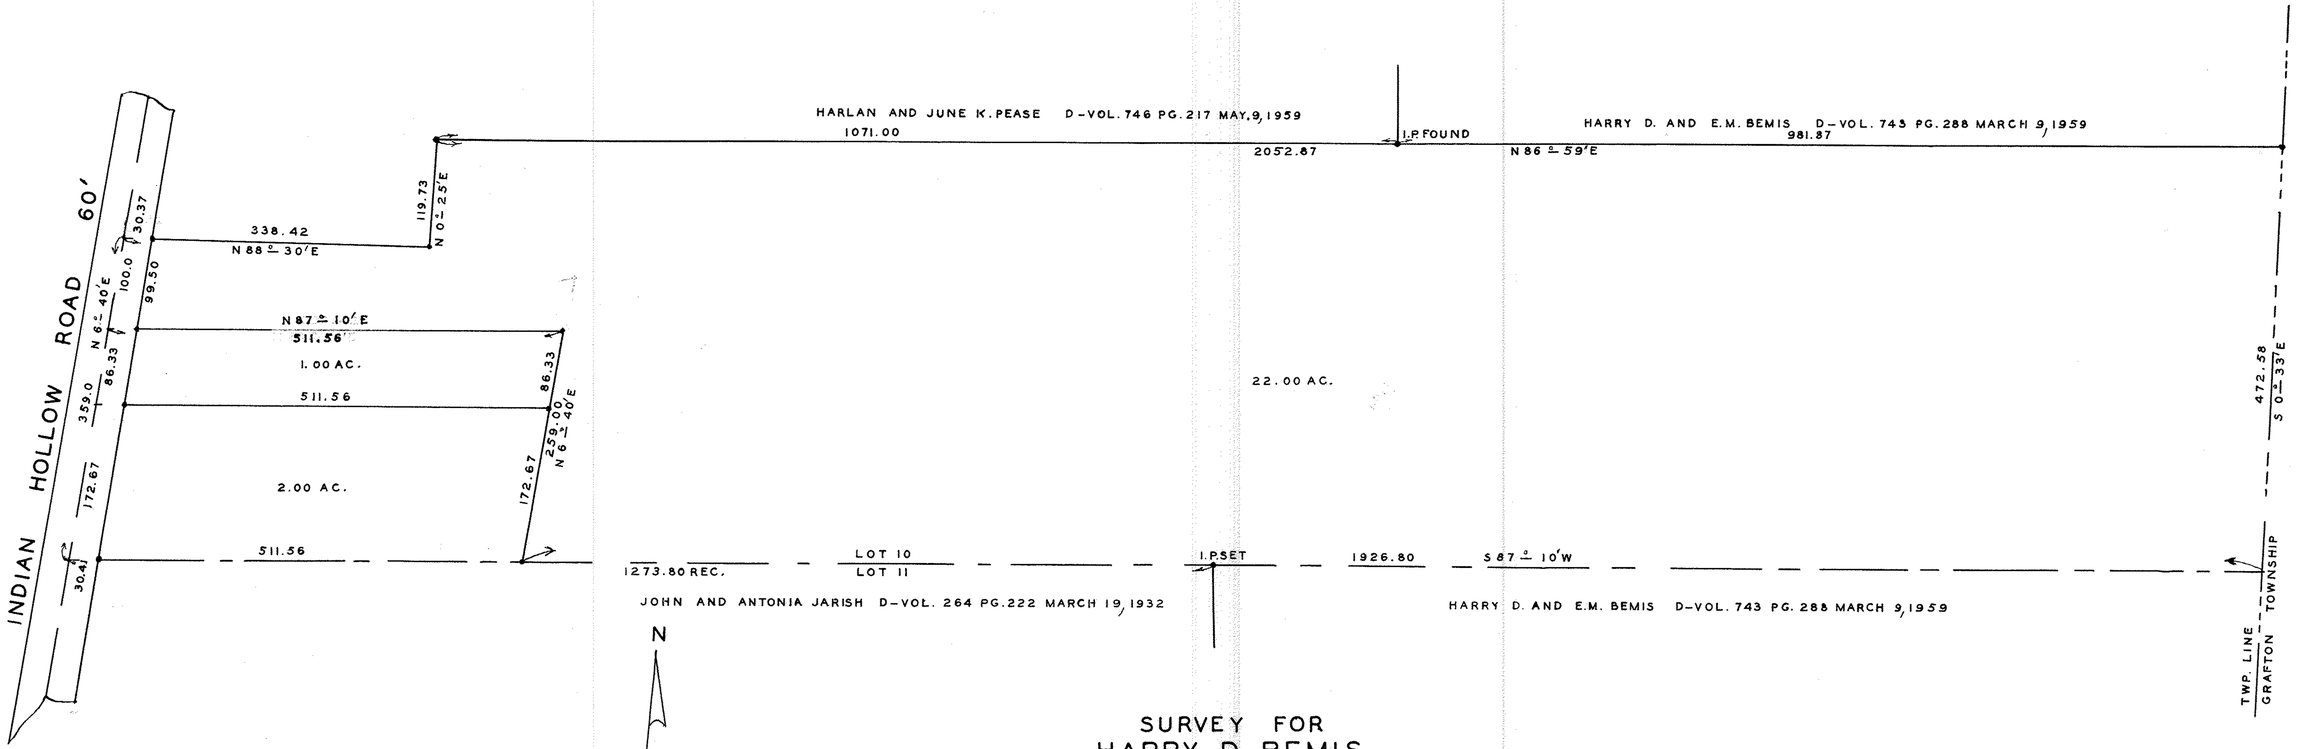

SURVEY FOR
HARRY D. BEMIS
PROPERTY OF
GERSHEN N. KLEIN
D.-VOL. 533 PG. 134 DEC. 5, 1951
LOT 10 LA-GRANGE TWP.
LORAIN COUNTY OHIO
J.W. WARDEN AND ASSOCIATES REG. SURVEYORS

NOTE - IRON PINS FOUND OR SET AT ALL POINTS SHOWEN THUS ●

BY - D.D. ANDRUS

PPN 15-00-010-000-013
014

MAP PG 15-D

SCALE 1" = 100'
NOV. 23, 1962