Map 65 5-21
PPN 12-00-048-000-222

SURVEY FOR
HARRY C. STINCHCOMB

D-VOL. 287 PG. 113 JULY 8, 1937
O.L. 48 COLUMBIA TWP.
LORAIN COUNTY OHIO
SCALE 1" = 50' MAY 14, 1963
J.W. WARDEN AND ASSOCIATES REG. SURVEYORS
REV. MARCH 11, 1965

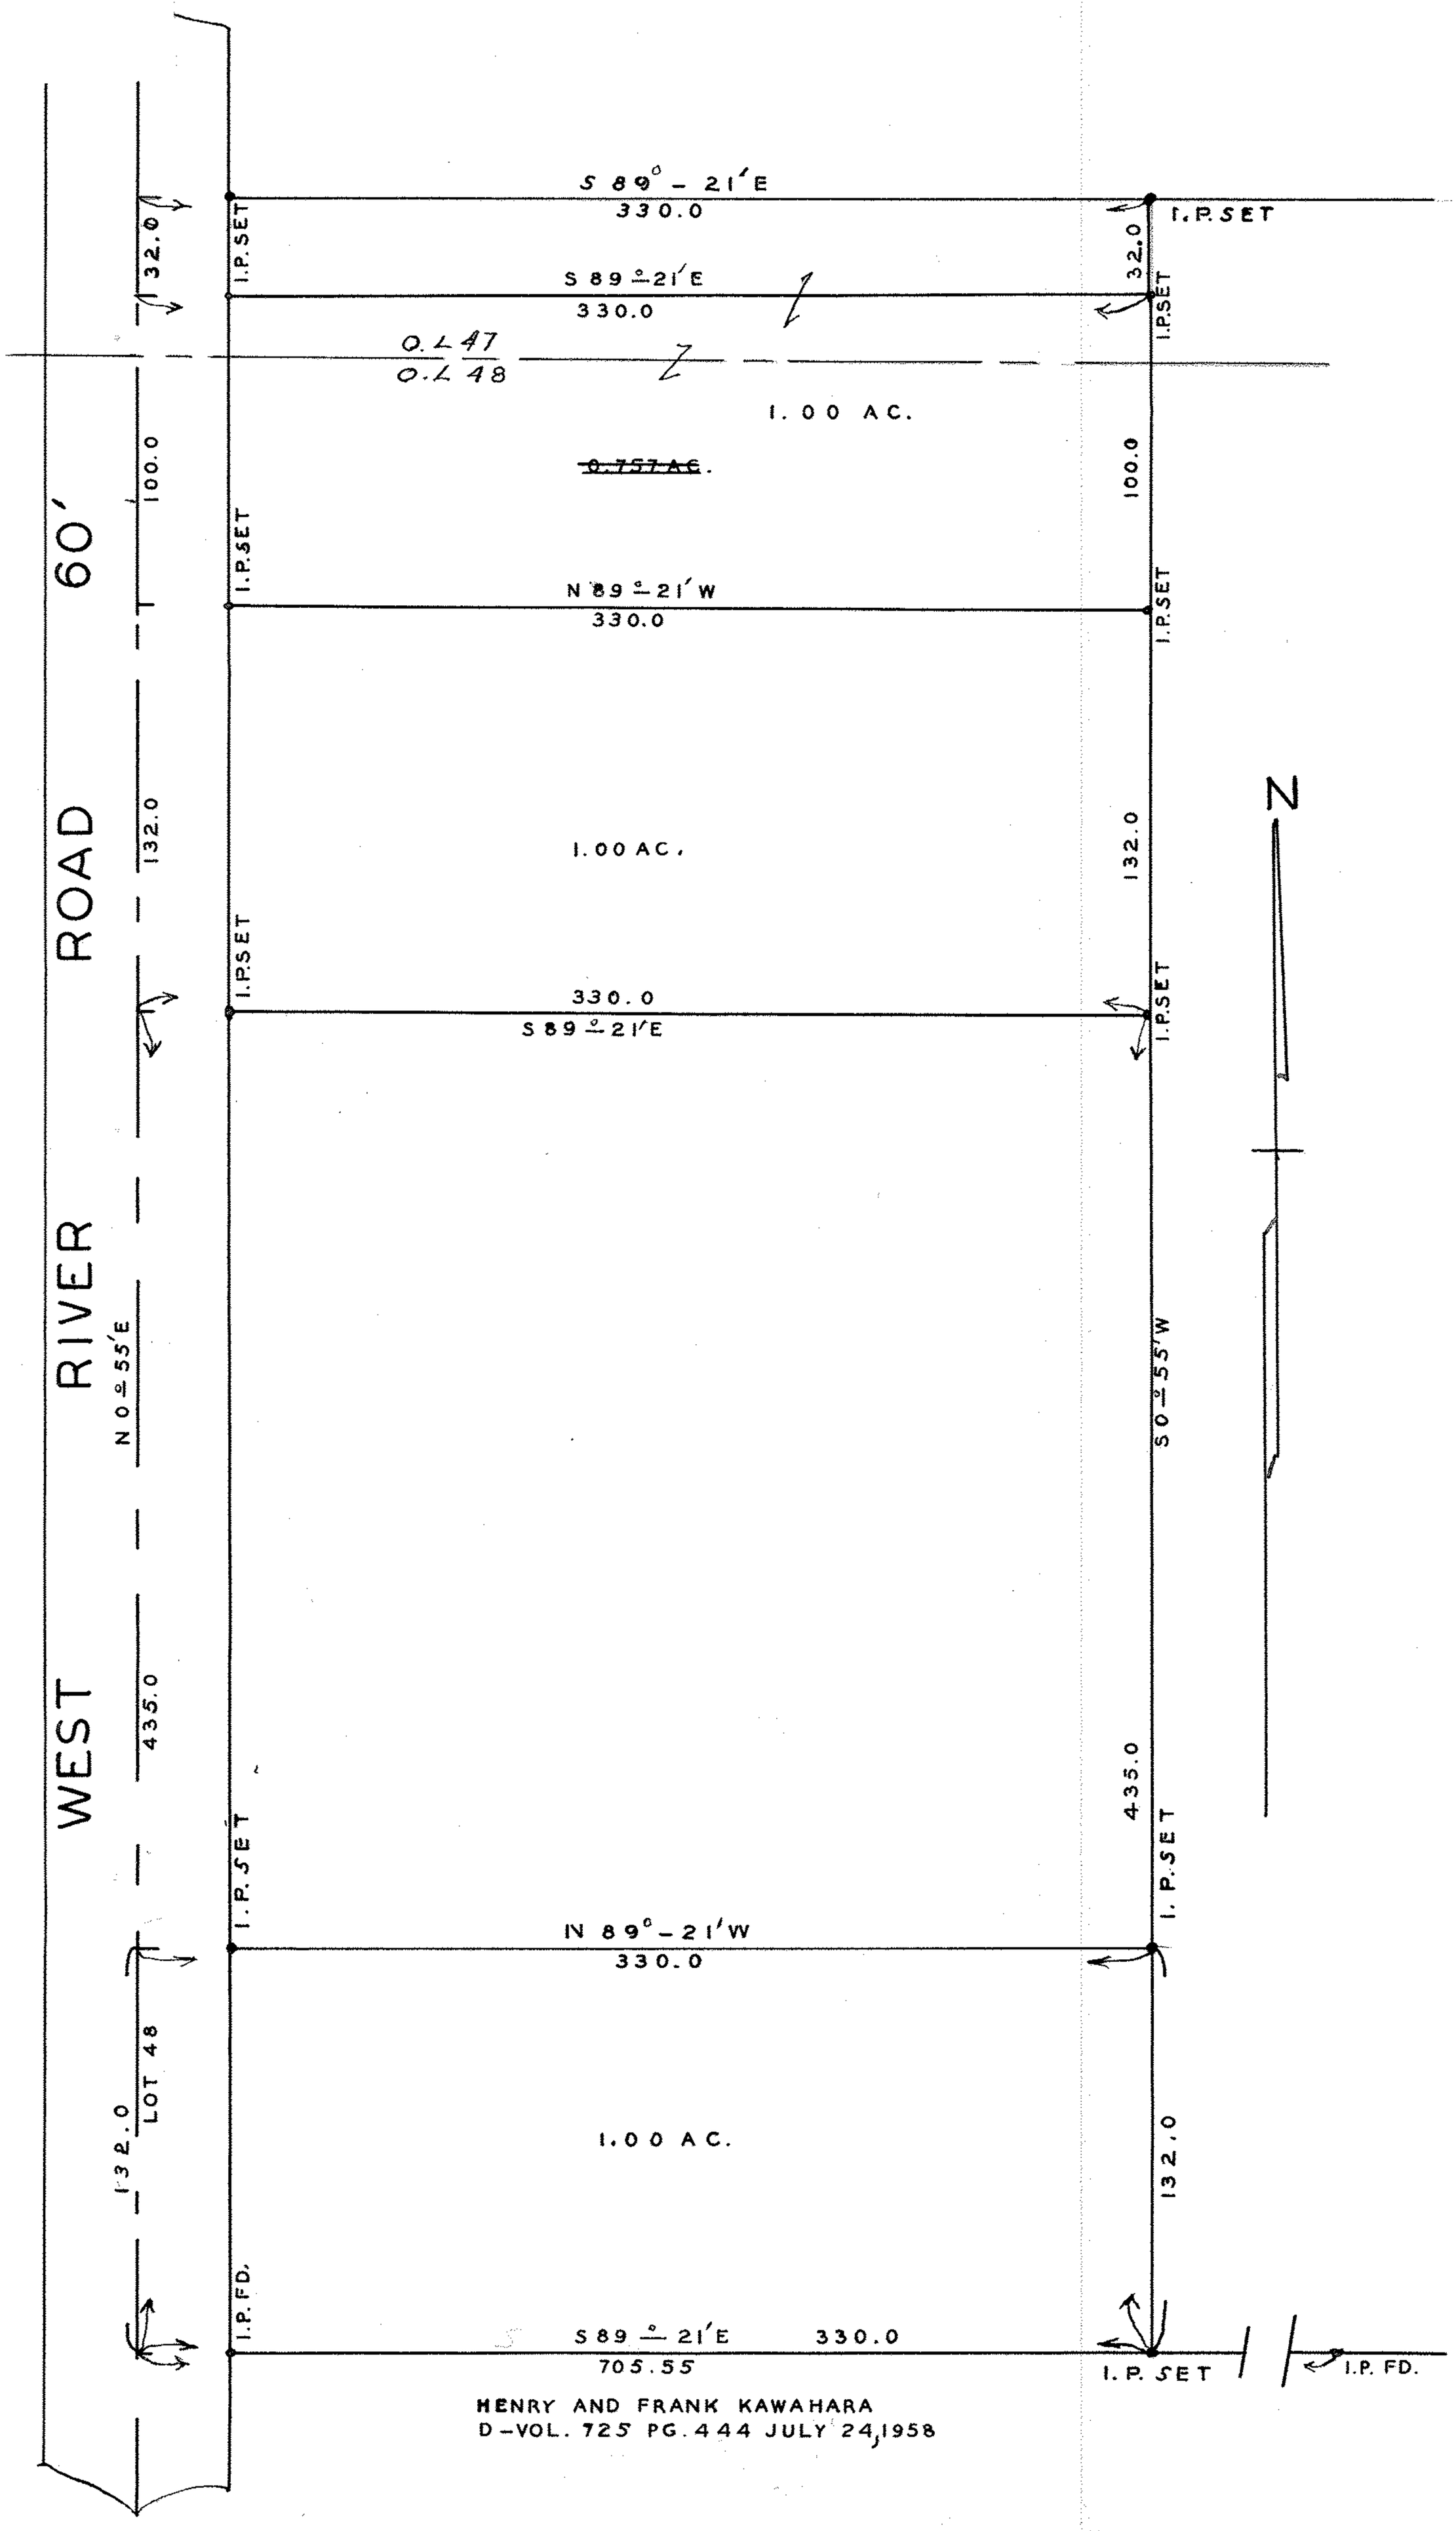

HENRY AND FRANK KAWAHARA
D-VOL. 725 PG. 444 JULY 24, 1958

14-1402 A

SOM-M