MAP OF SURVEY MADE FOR

Katherina Gold

Sec. 3 Carlisle Twp.

Lorain County, Ohio

Distances are given in feet and decimal parts

Scale, 1 in. = 50 Feet

Elyria, O., August 1928

Order No.,

F. B. 24 Pg., 46

Warden & Laundon, C. E.
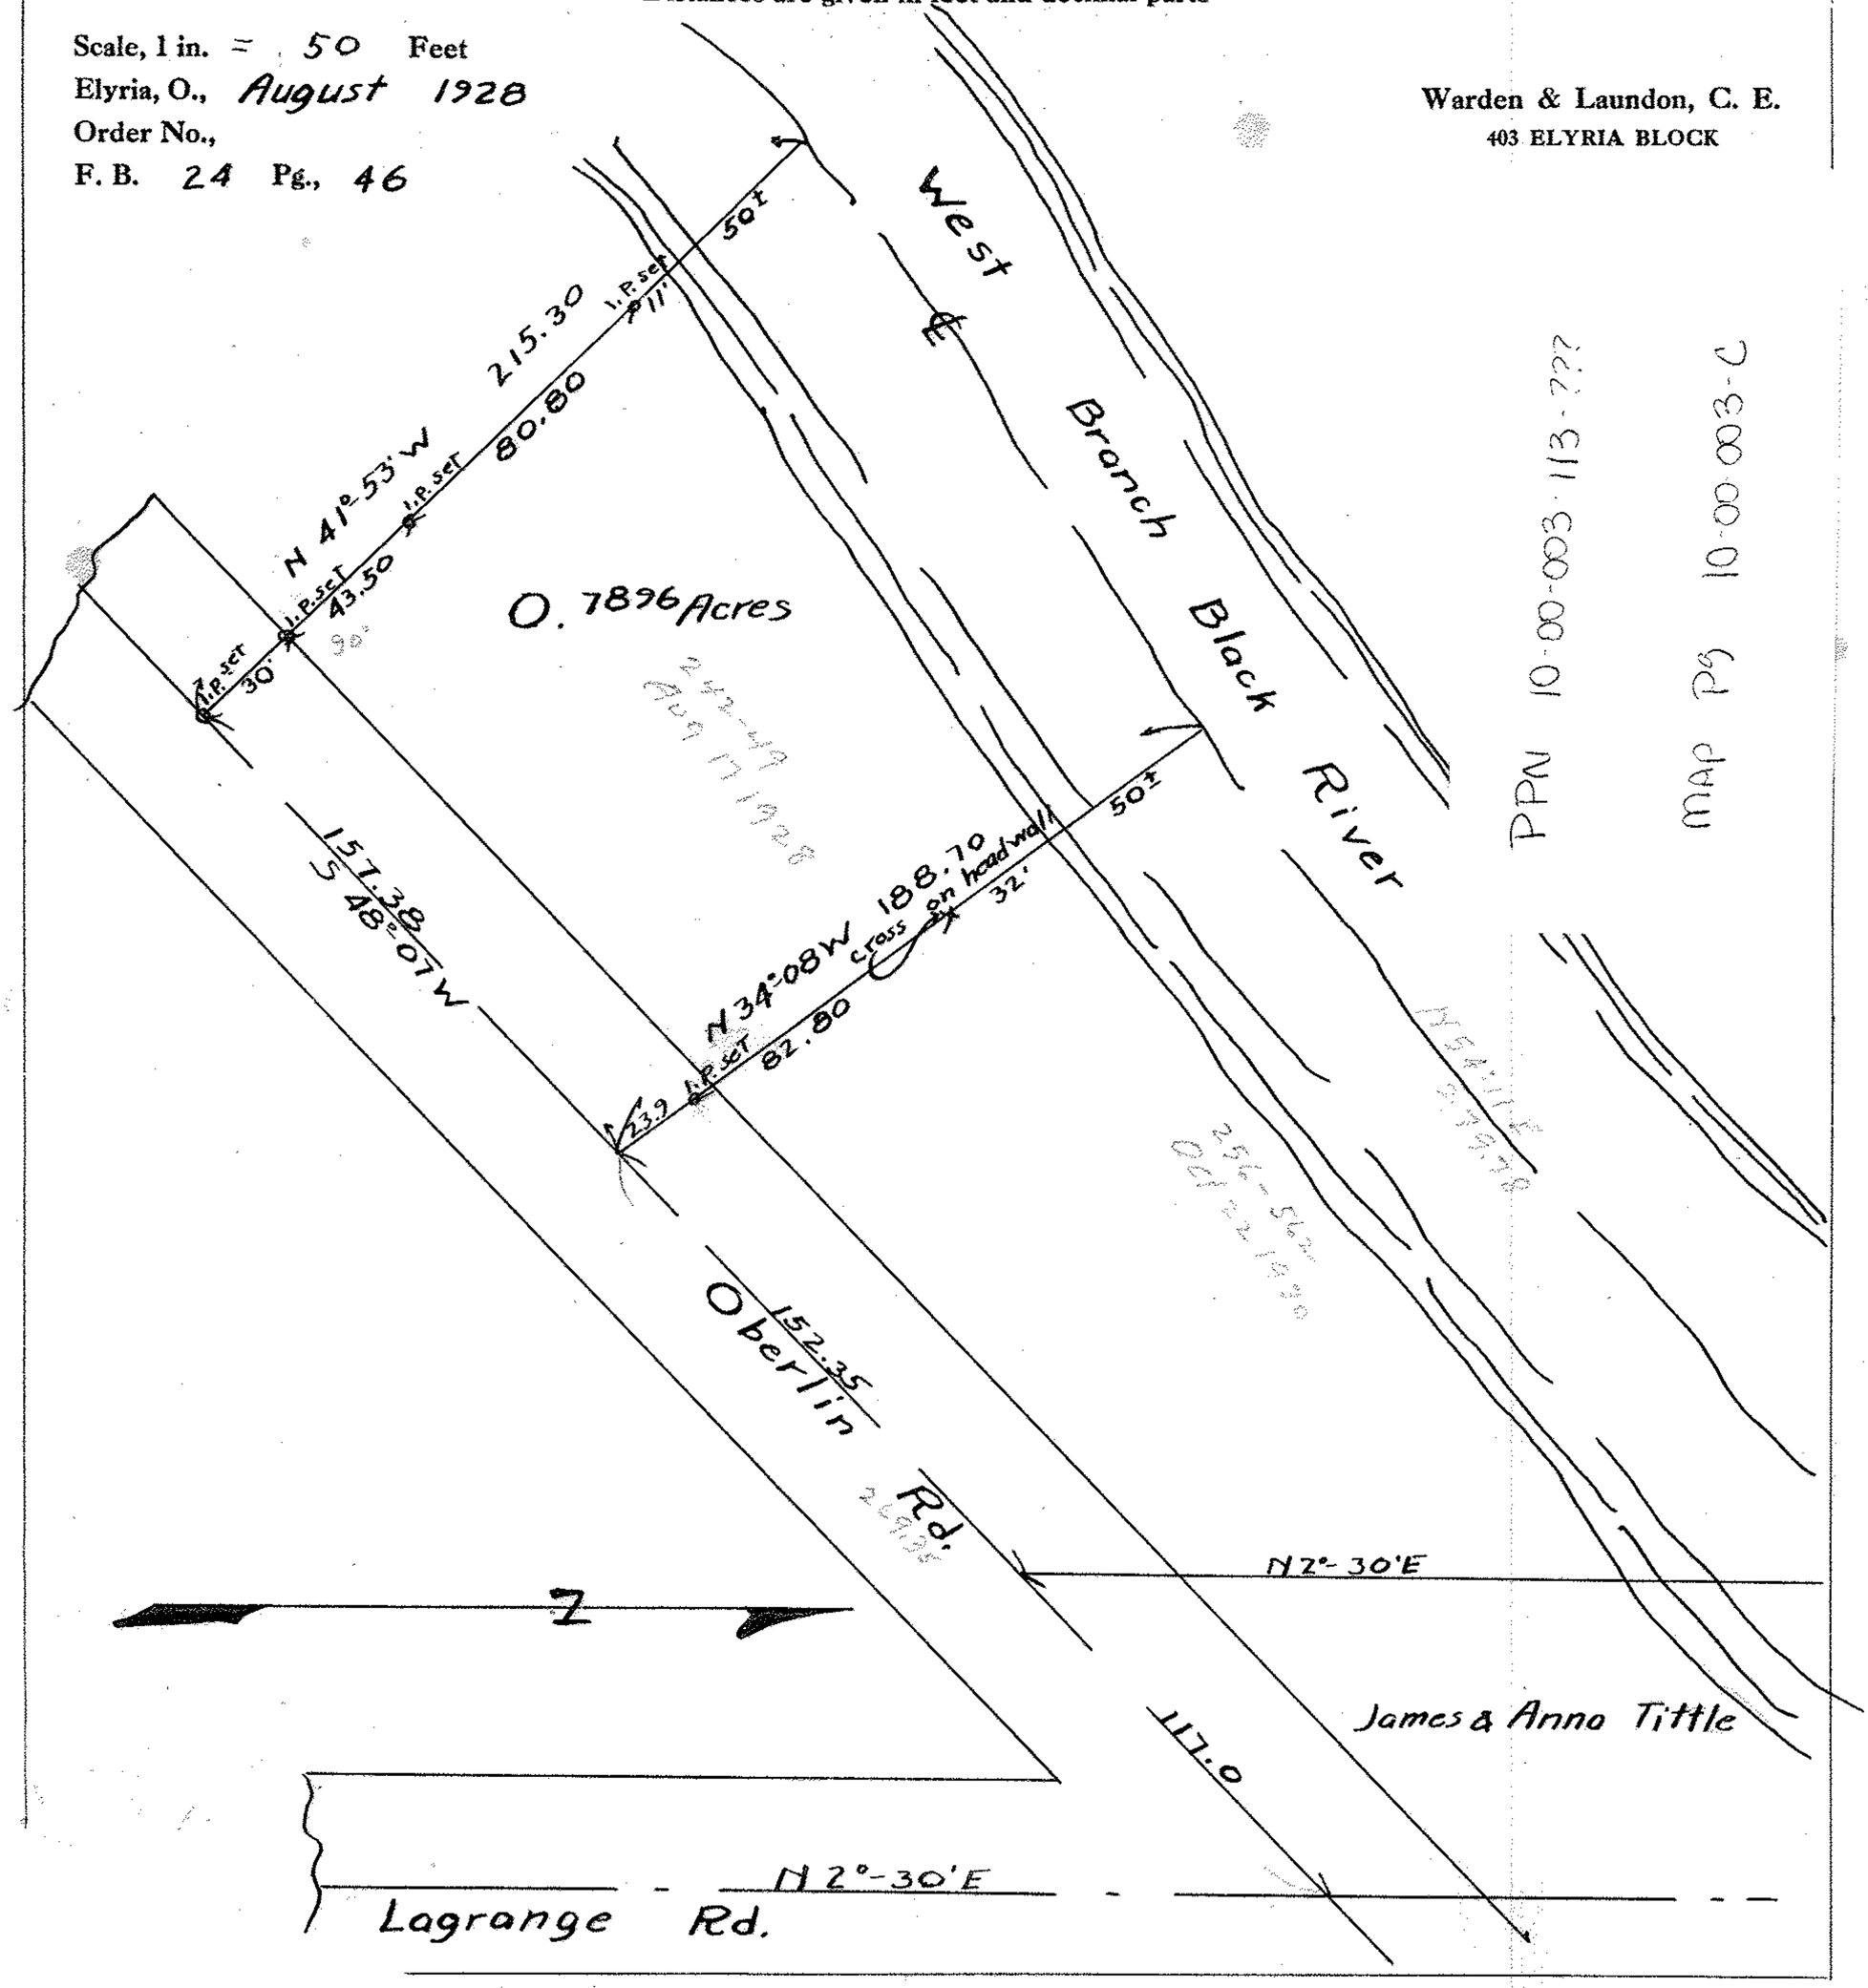
403 ELYRIA BLOCK