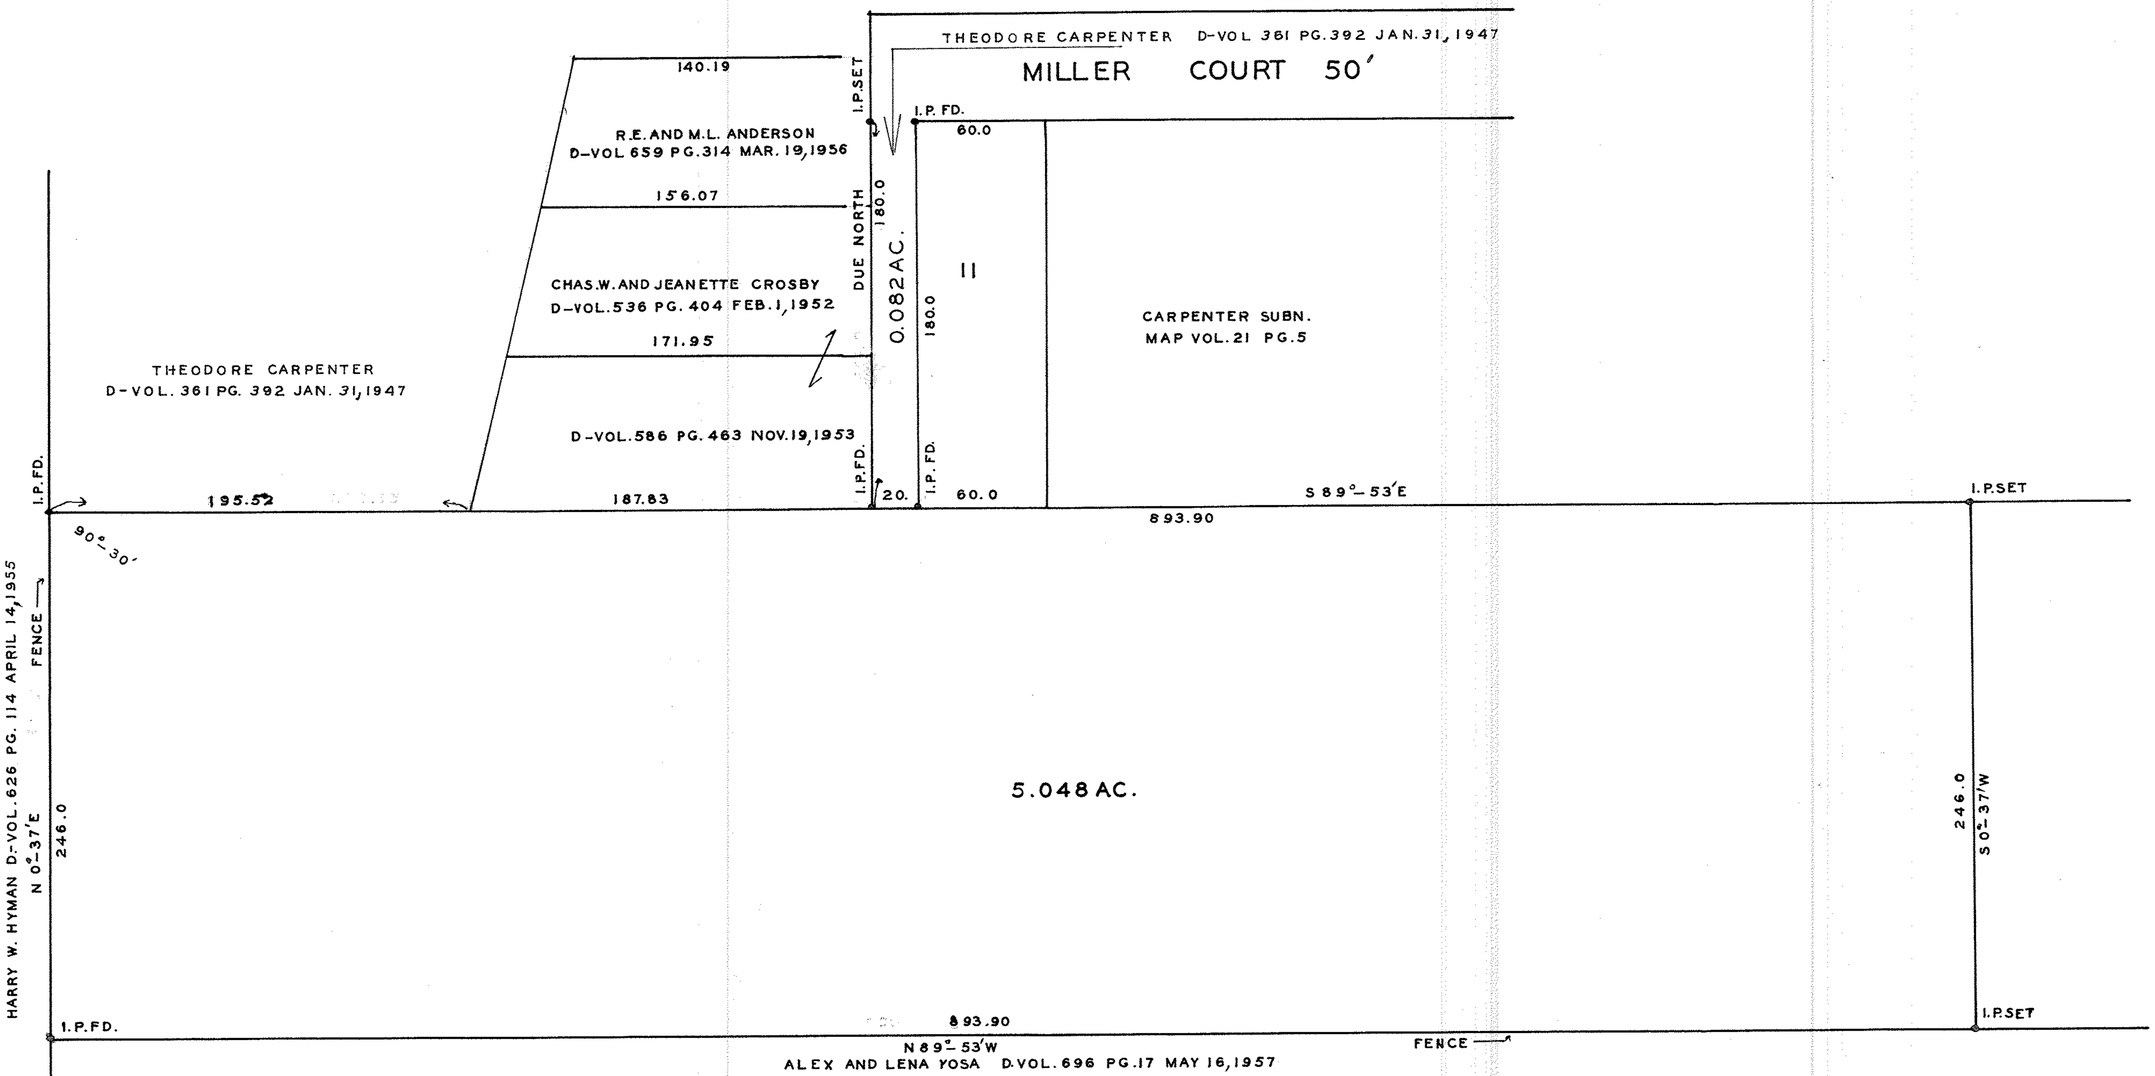

SURVEY FOR
THEODORE CARPENTER
D-VOL.266 PG.15 OCT.21,1932
SECTION 4 CARLISLE TWP.
LORAIN COUNTY OHIO
SCALE 1"= 50' OCT.17, 1960
J.W. WARDEN AND ASSOCIATES REG. SURVEYORS

PPN 10-00-004-125.045

MAP PG 10-00.004-G

21-1356.

91-1328