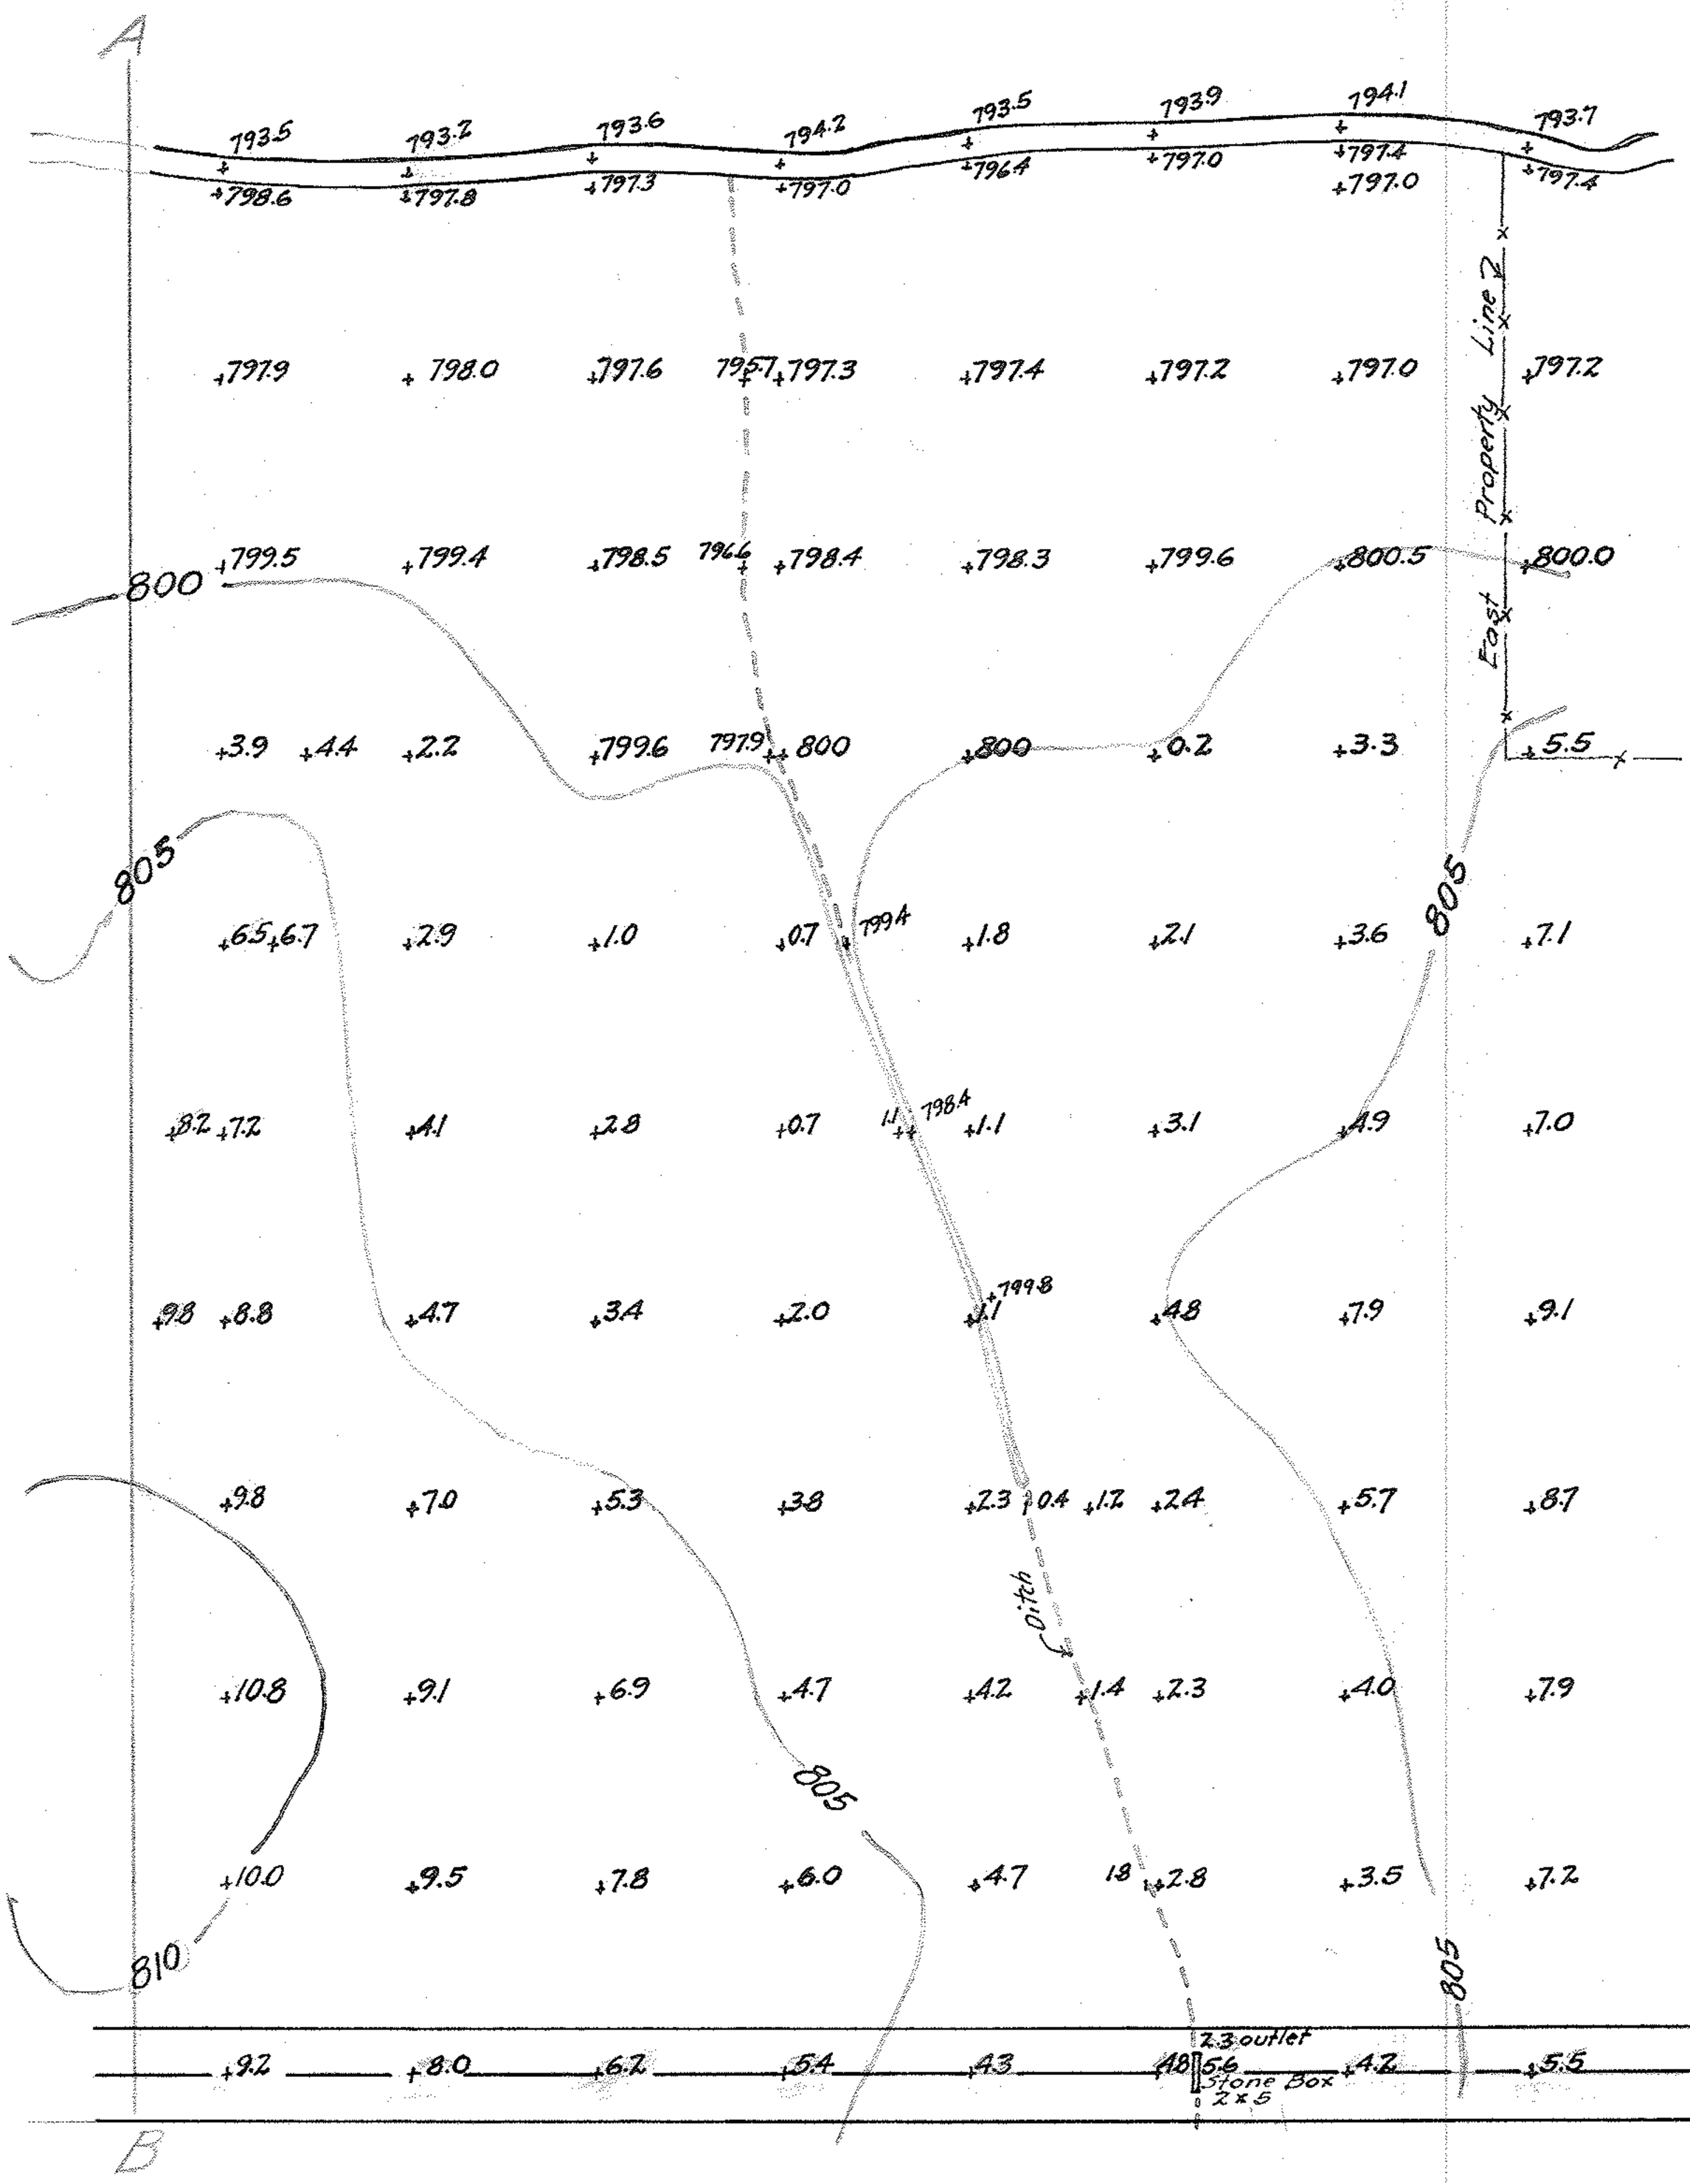
A
B
793.5
793.7
793.6
794.2
793.5
793.9
794.1
793.7
798.6
797.8
797.3
797.0
796.4
797.0
797.4
797.0
797.4
797.9
798.0
797.6
795.7
797.3
797.4
797.2
797.0
797.2
Property Line
East
800
799.5
799.4
798.5
796.6
798.4
798.3
799.6
800.5
800.0
3.9
4.4
2.2
799.6
797.9
800
800
0.2
3.3
5.5
805
6.5
6.7
2.9
1.0
0.7
799.4
1.8
2.1
3.6
7.1
8.2
7.2
4.1
2.8
0.7
1.1
798.4
1.1
3.1
4.9
7.0
9.8
8.8
4.7
3.4
2.0
1.1
799.8
4.8
7.9
9.1
9.8
7.0
5.3
3.8
2.3
0.4
1.2
2.4
5.7
8.7
Ditch
10.8
9.1
6.9
4.7
4.2
1.4
2.3
4.0
7.9
10.0
9.5
7.8
6.0
4.7
1.8
2.8
3.5
7.2
810
9.2
8.0
6.2
5.4
4.3
4.8
2.3 outlet
5.6
Stone Box
2 x 5
4.2
5.5