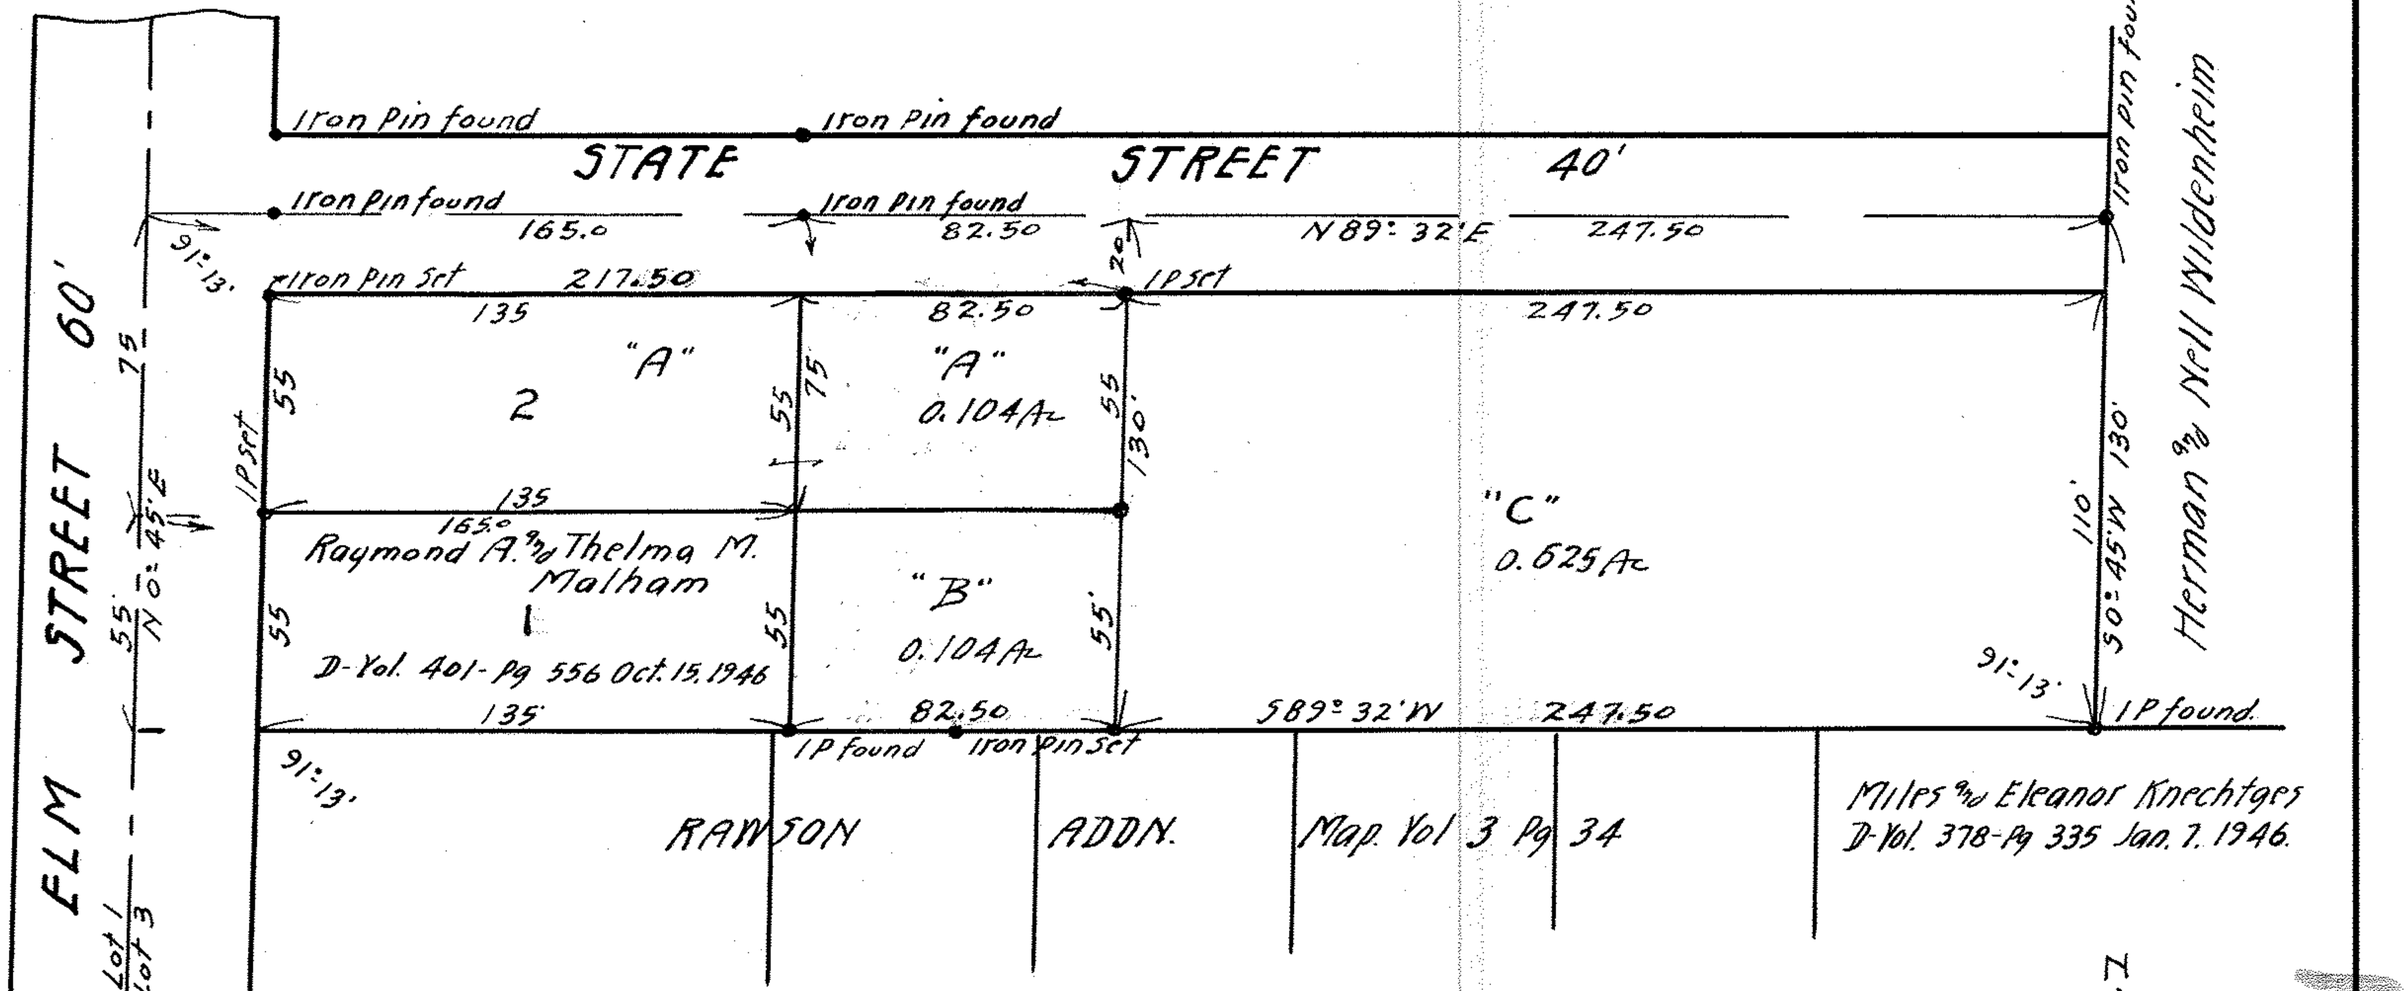

Survey for

JONATHAN WOODINGS ESTATE

Sub. Lot 2 Bennington Addition Map Vol. 4 - Pg. 7.
Original Lot 3 Grafton Township
Grafton Village Lorain County Ohio
Scale 1" = 50' Sept. 14, 1949.
J. W. Warden. Registered Surveyor.

16-1096