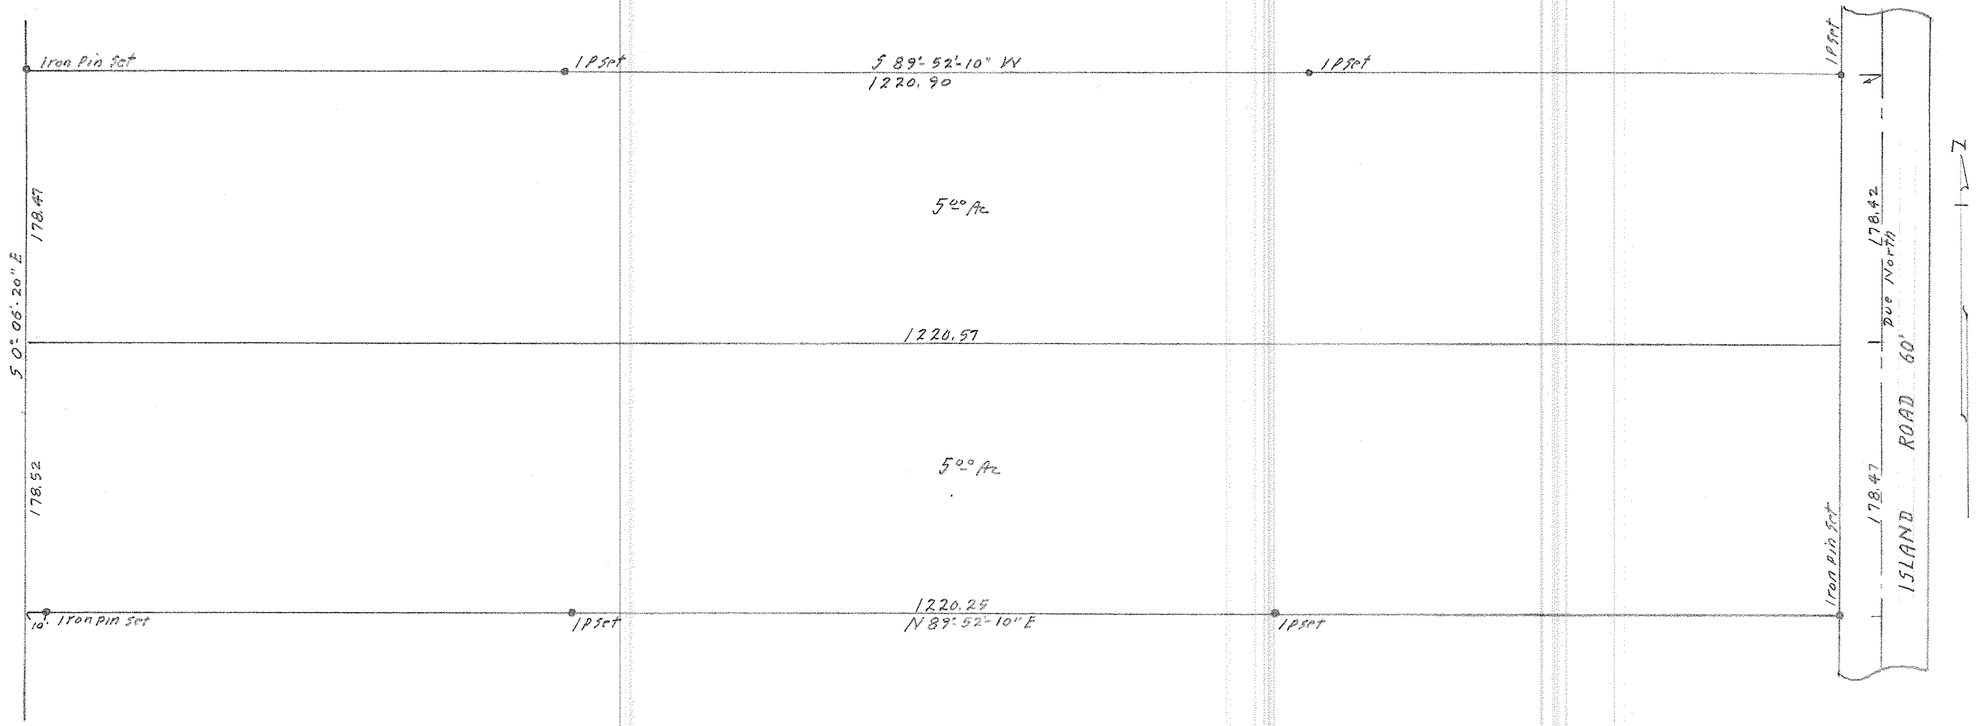

SURVEY FOR
JOSEPH F HUMPHERY
Lot 40 Eaton Township
Lorain County Ohio
Scale 1" = 60' Aug 11 1968
D. D. Andrus & Associates Reg Sur.

PPN 11-00-040-000-???

map pg 11-00-040-B

Parcel-01