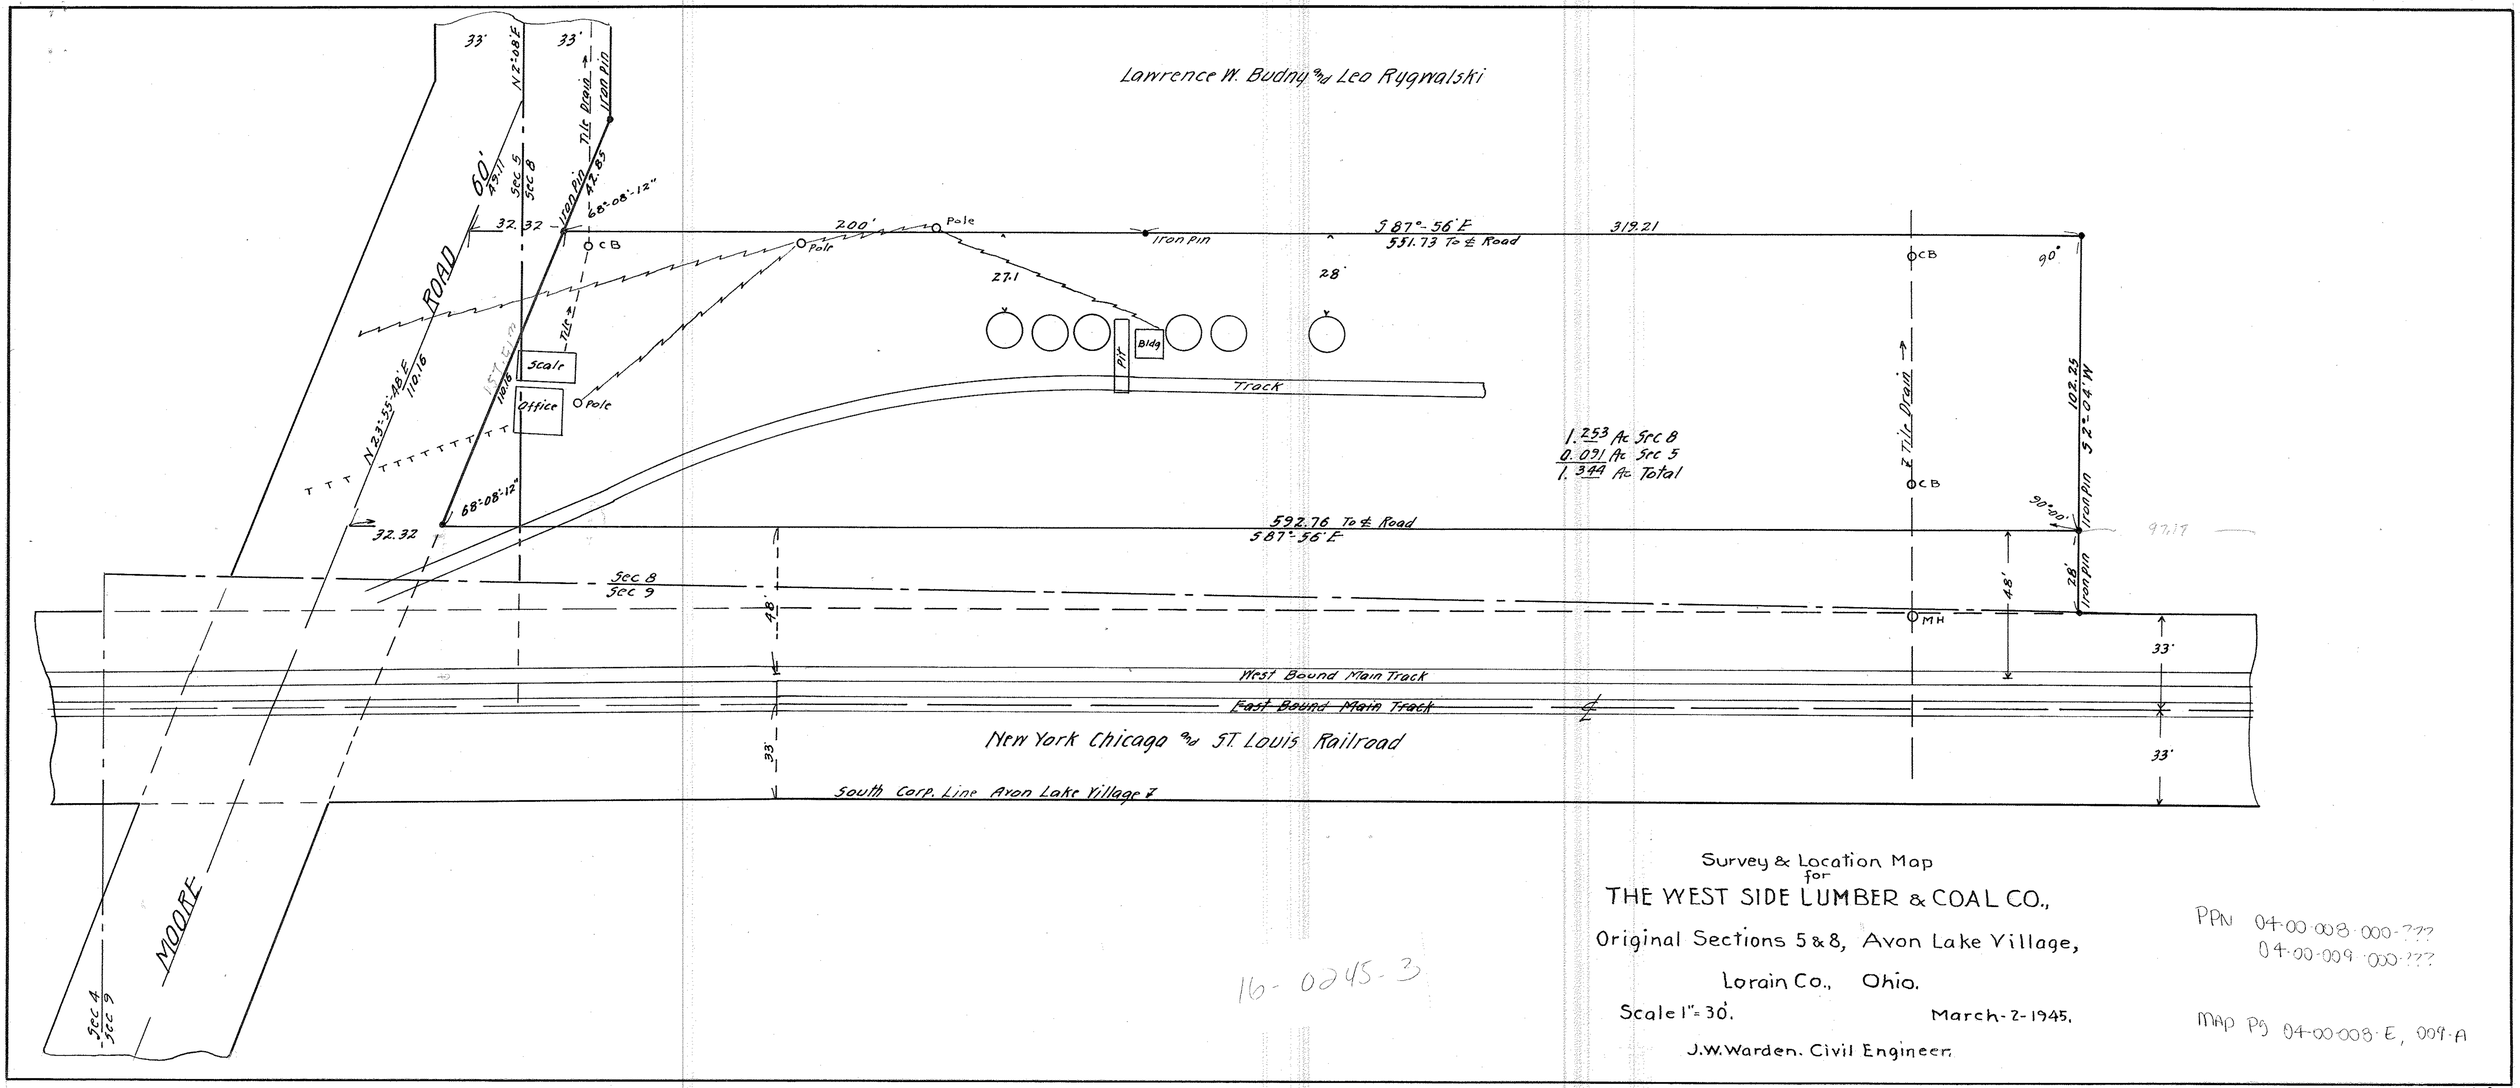

Survey & Location Map
for
THE WEST SIDE LUMBER & COAL CO.,
Original Sections 5 & 8, Avon Lake Village,
Lorain Co., Ohio.
Scale 1" = 30'. March-2-1945.
J.W. Warden. Civil Engineer.

16-0245-3

PPN 04-00-008-000-???
04-00-009-000-???

MAP PG 04-00-008-E, 009-A

D.A.