
 
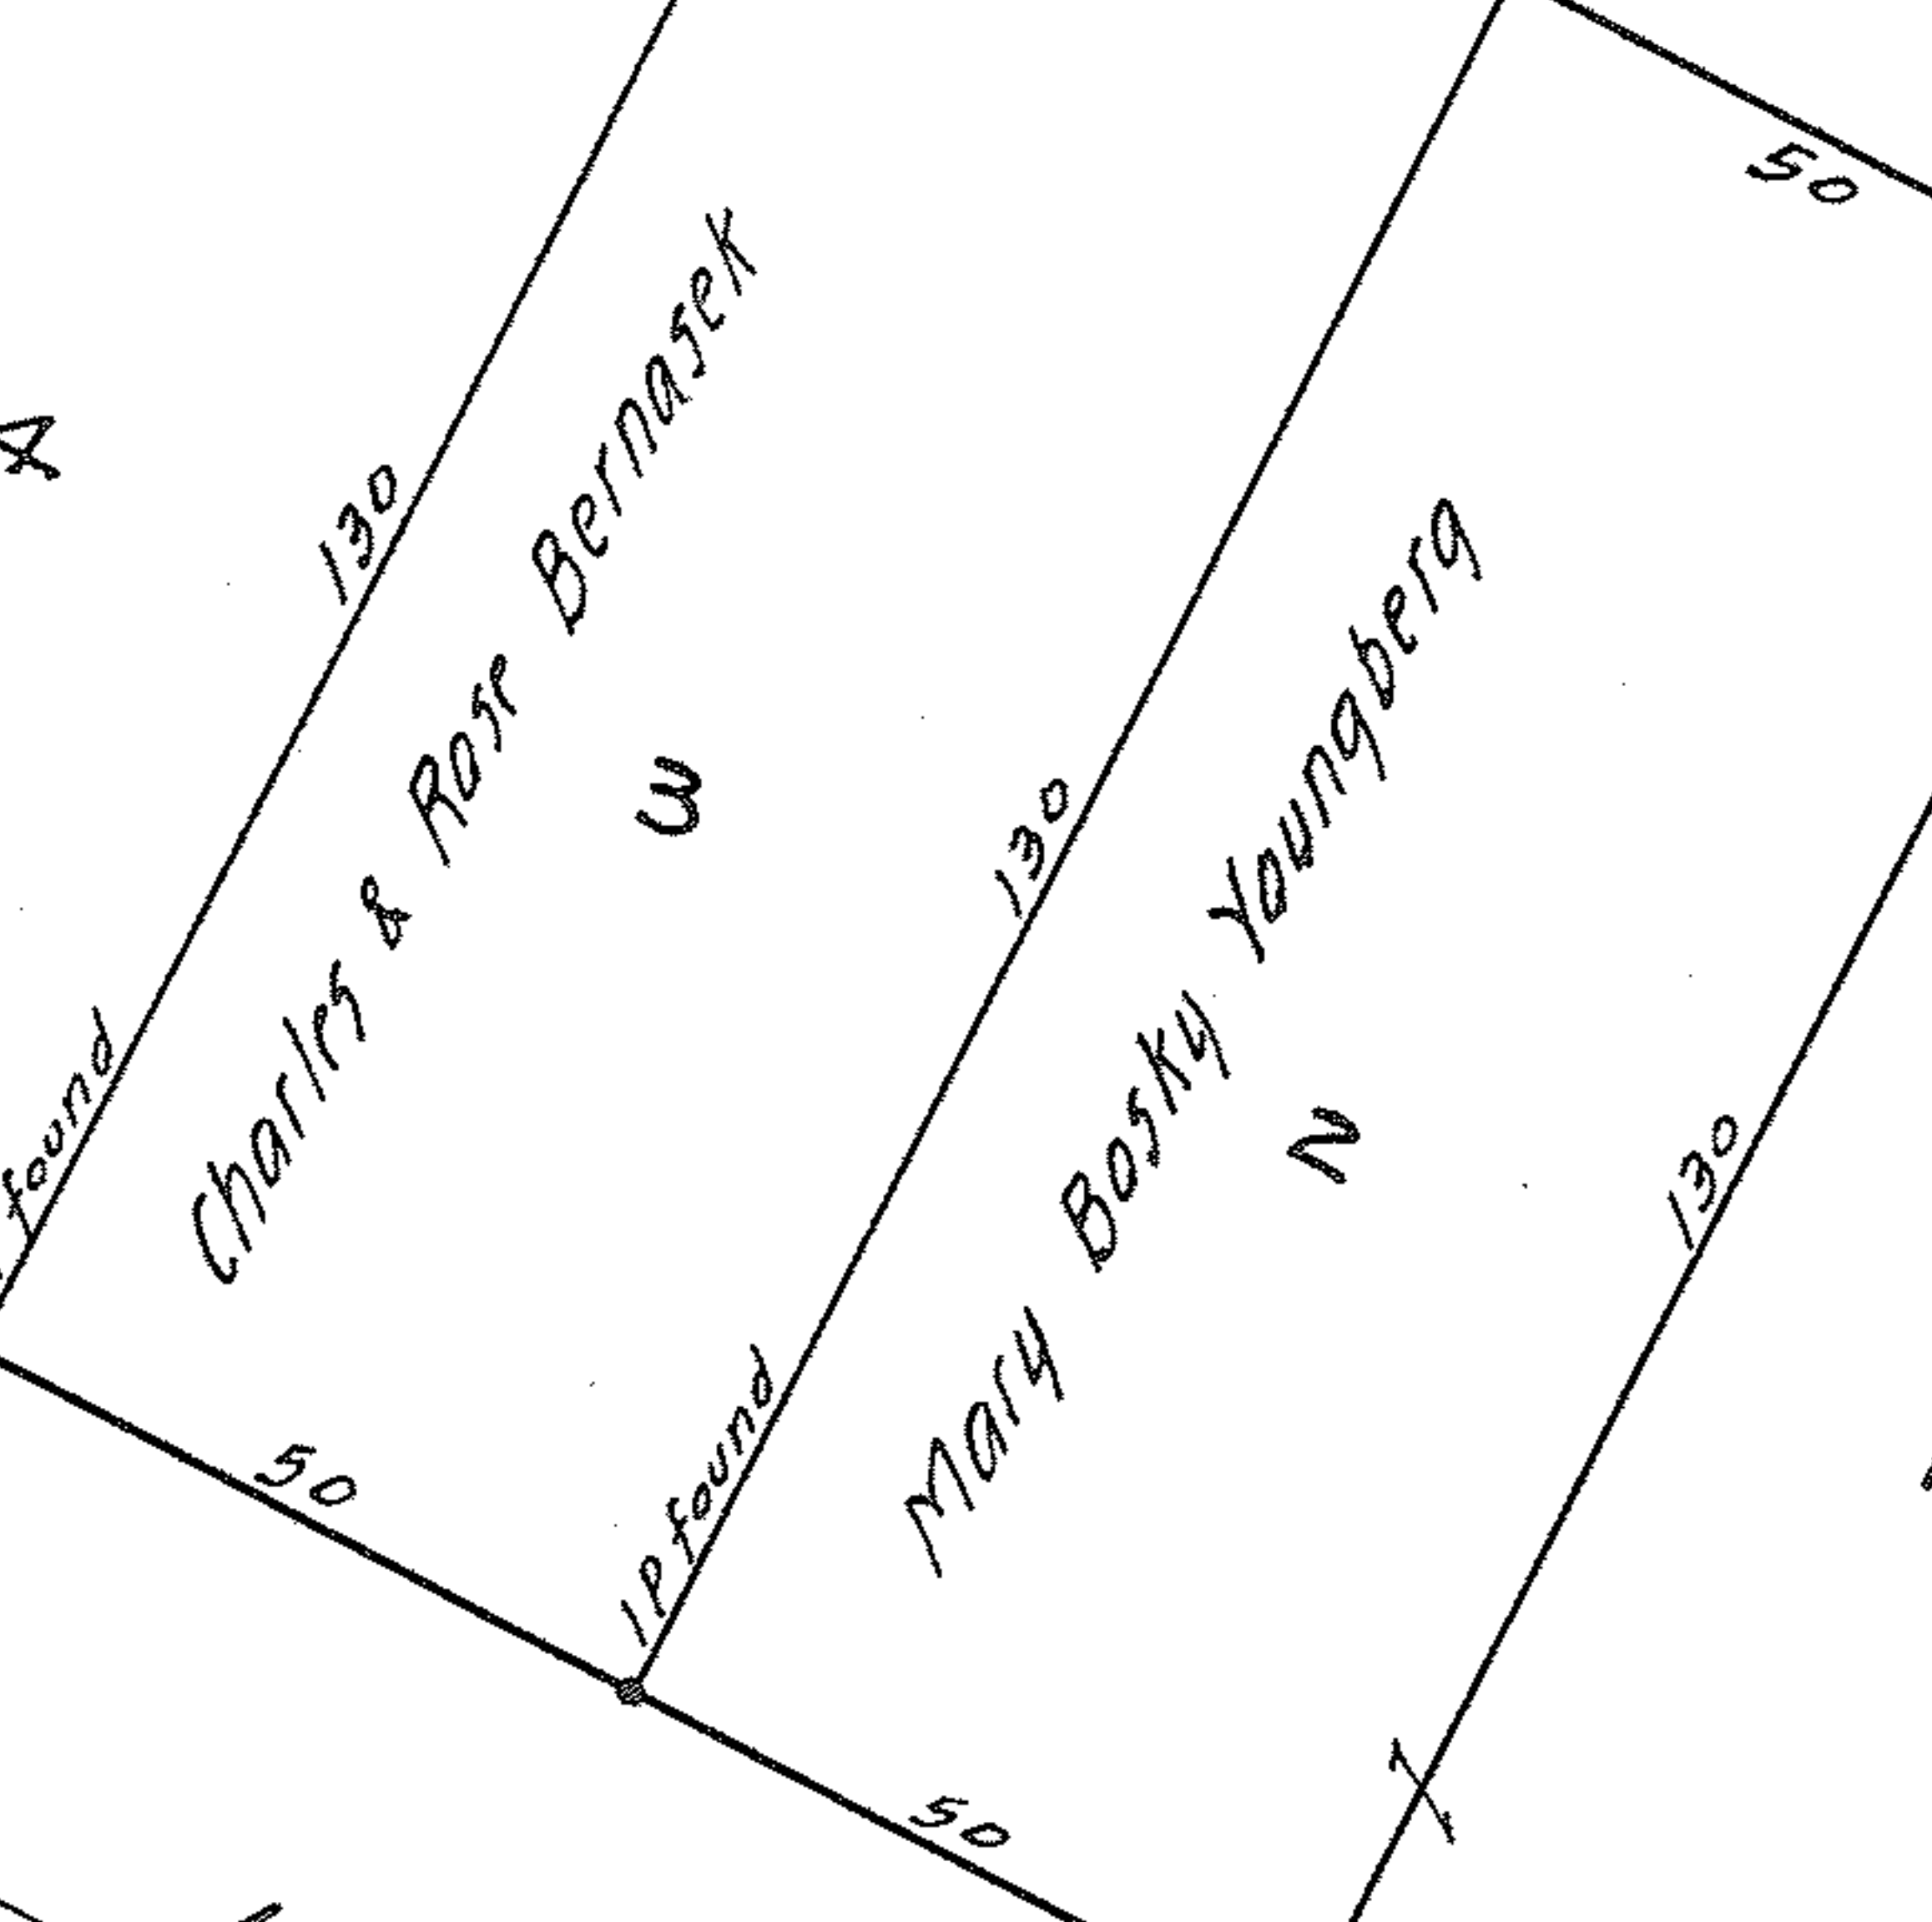
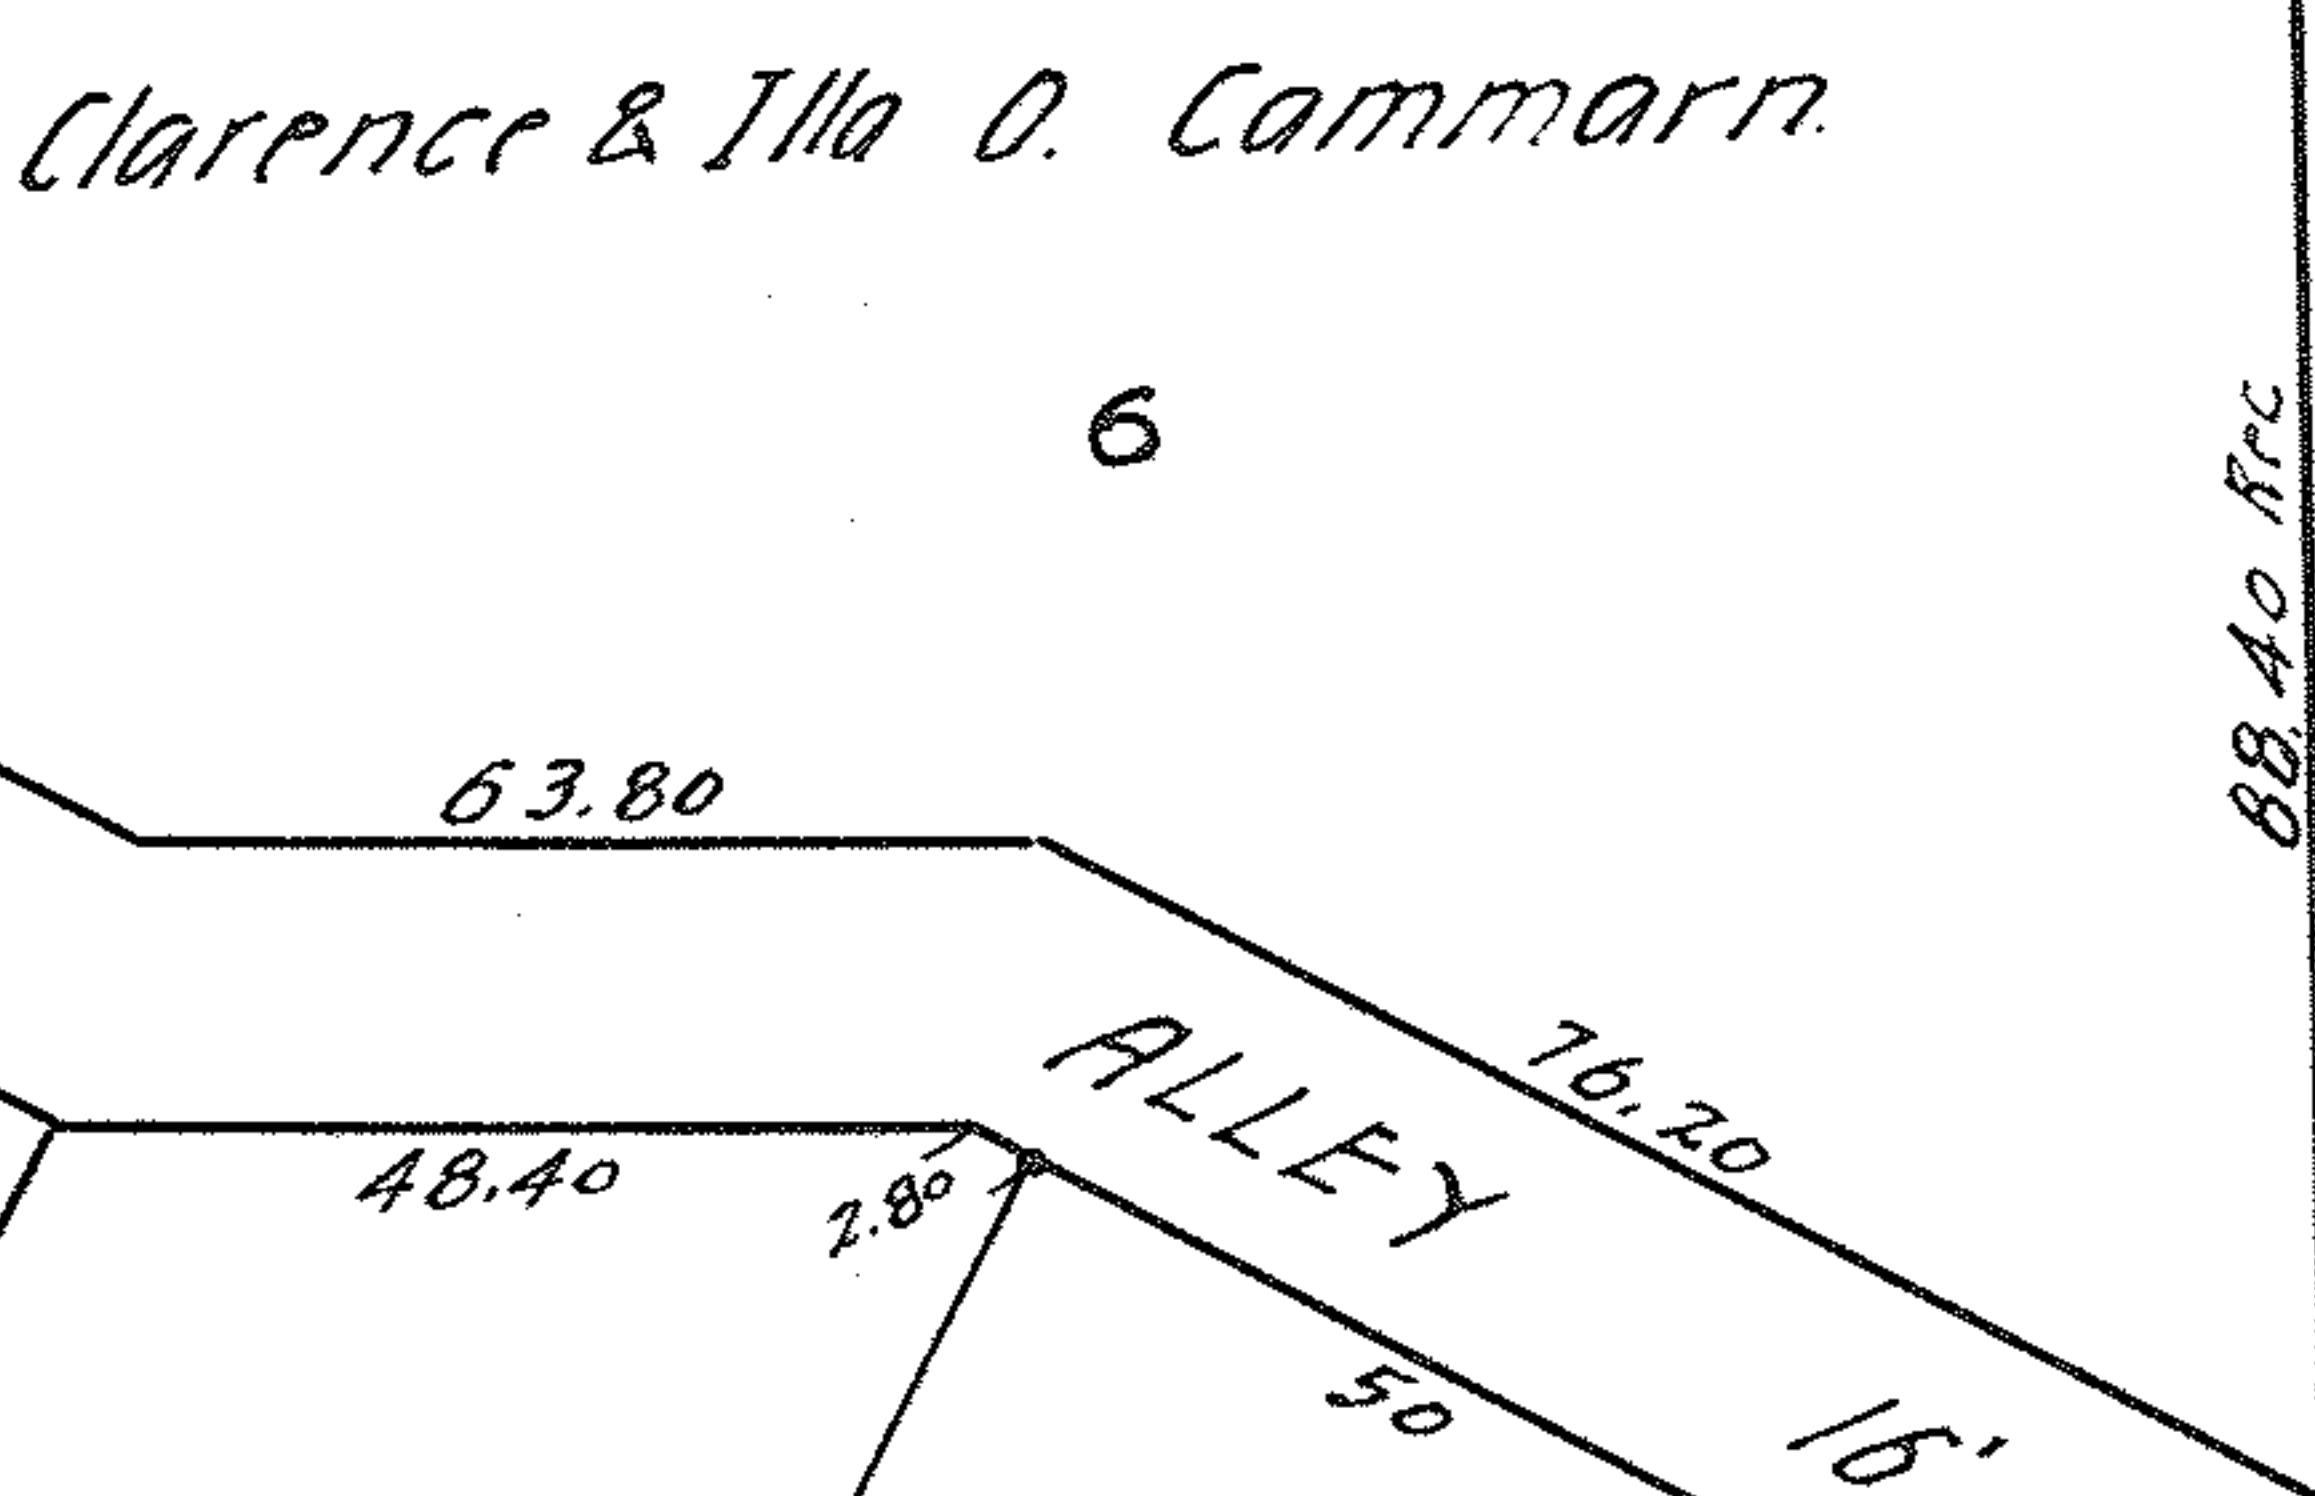
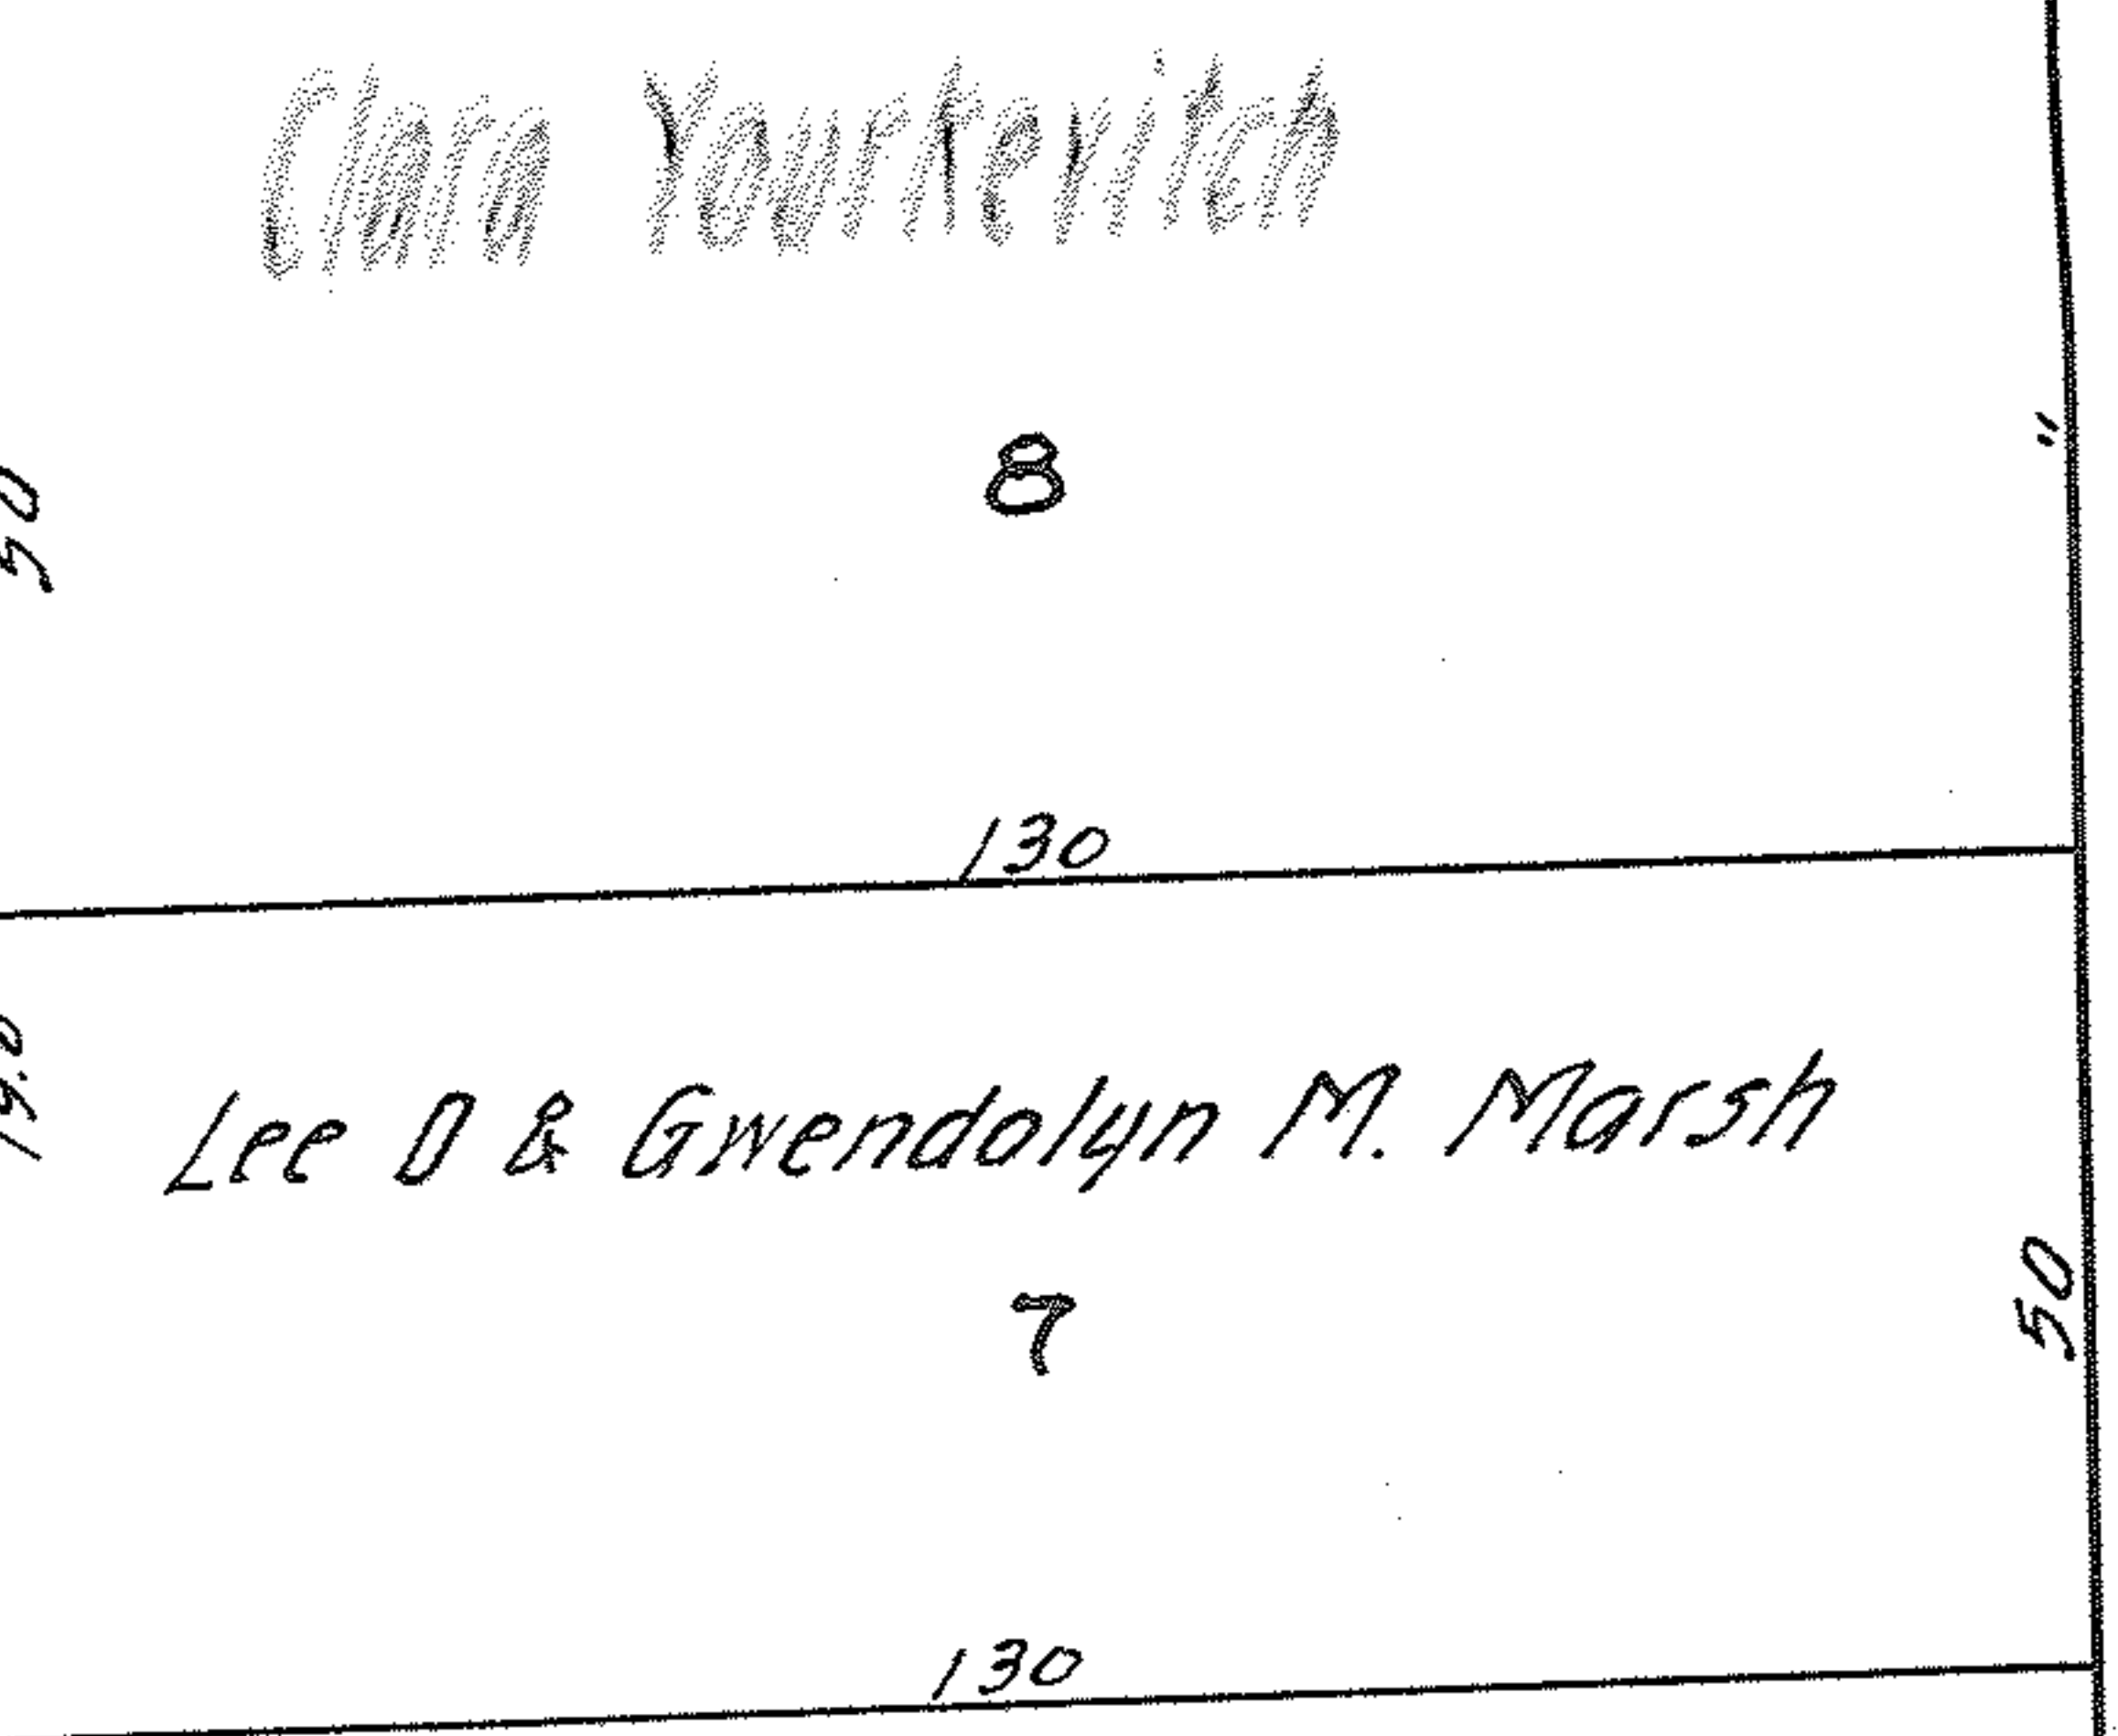
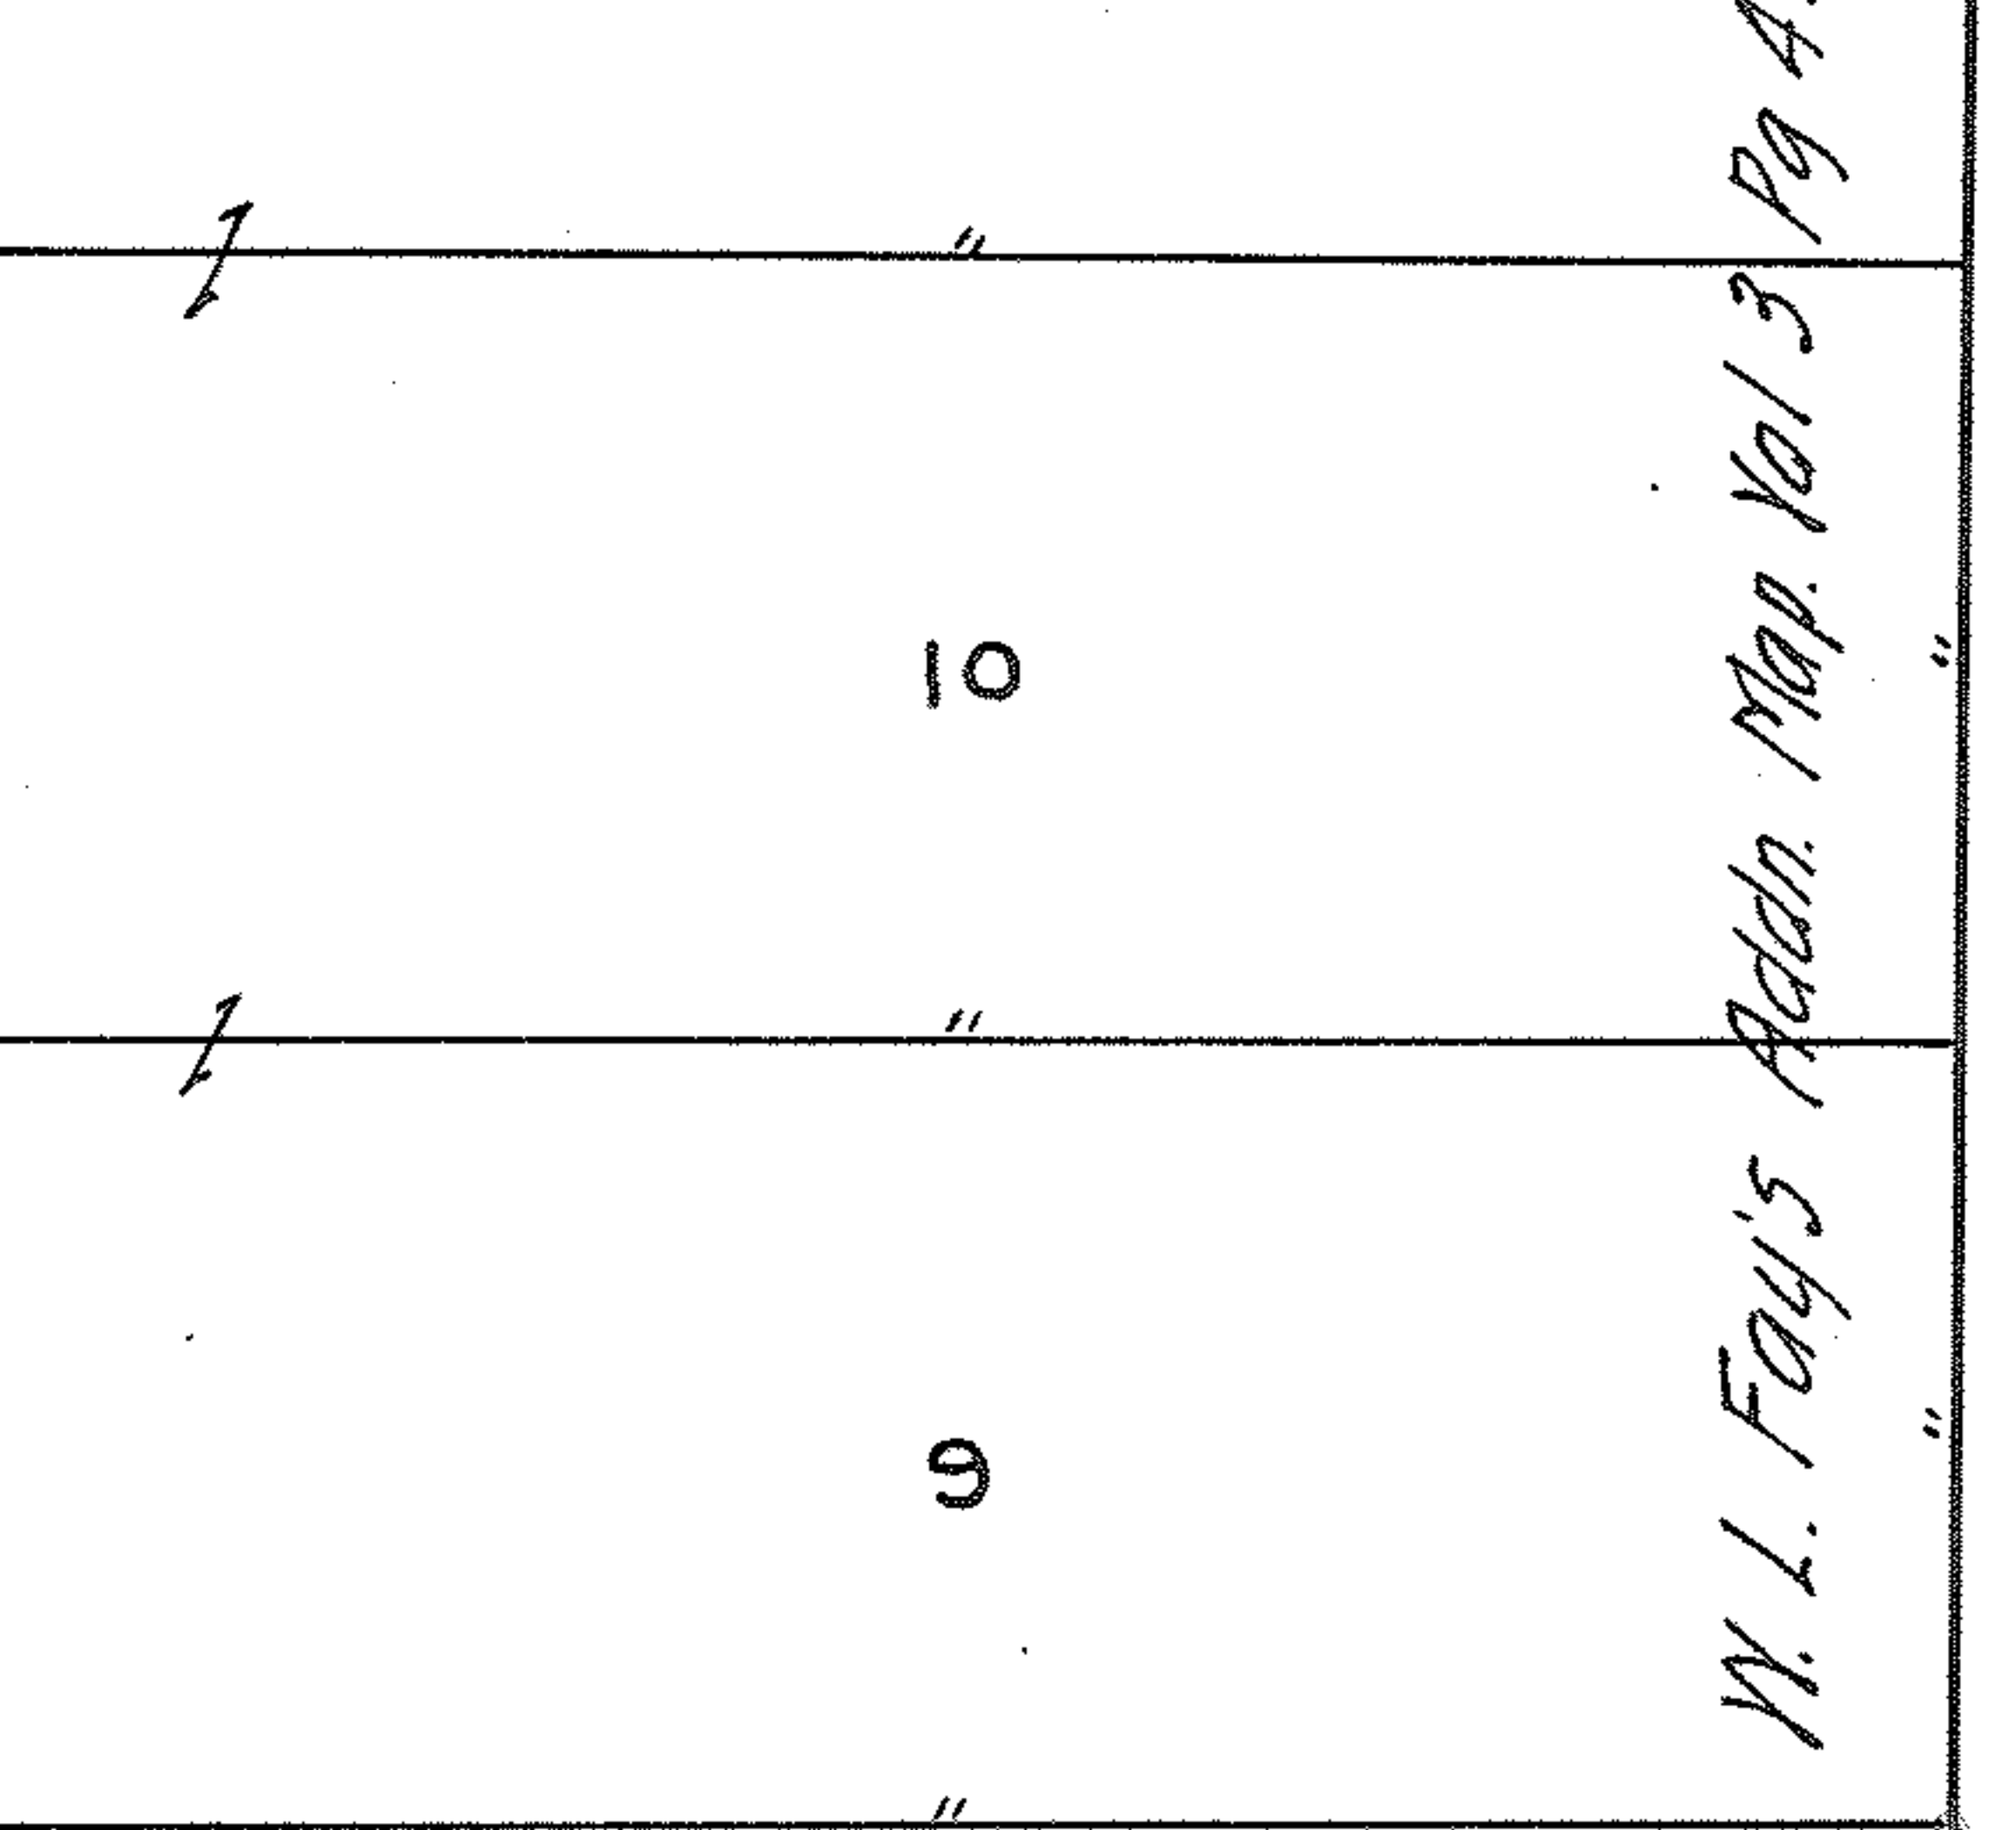
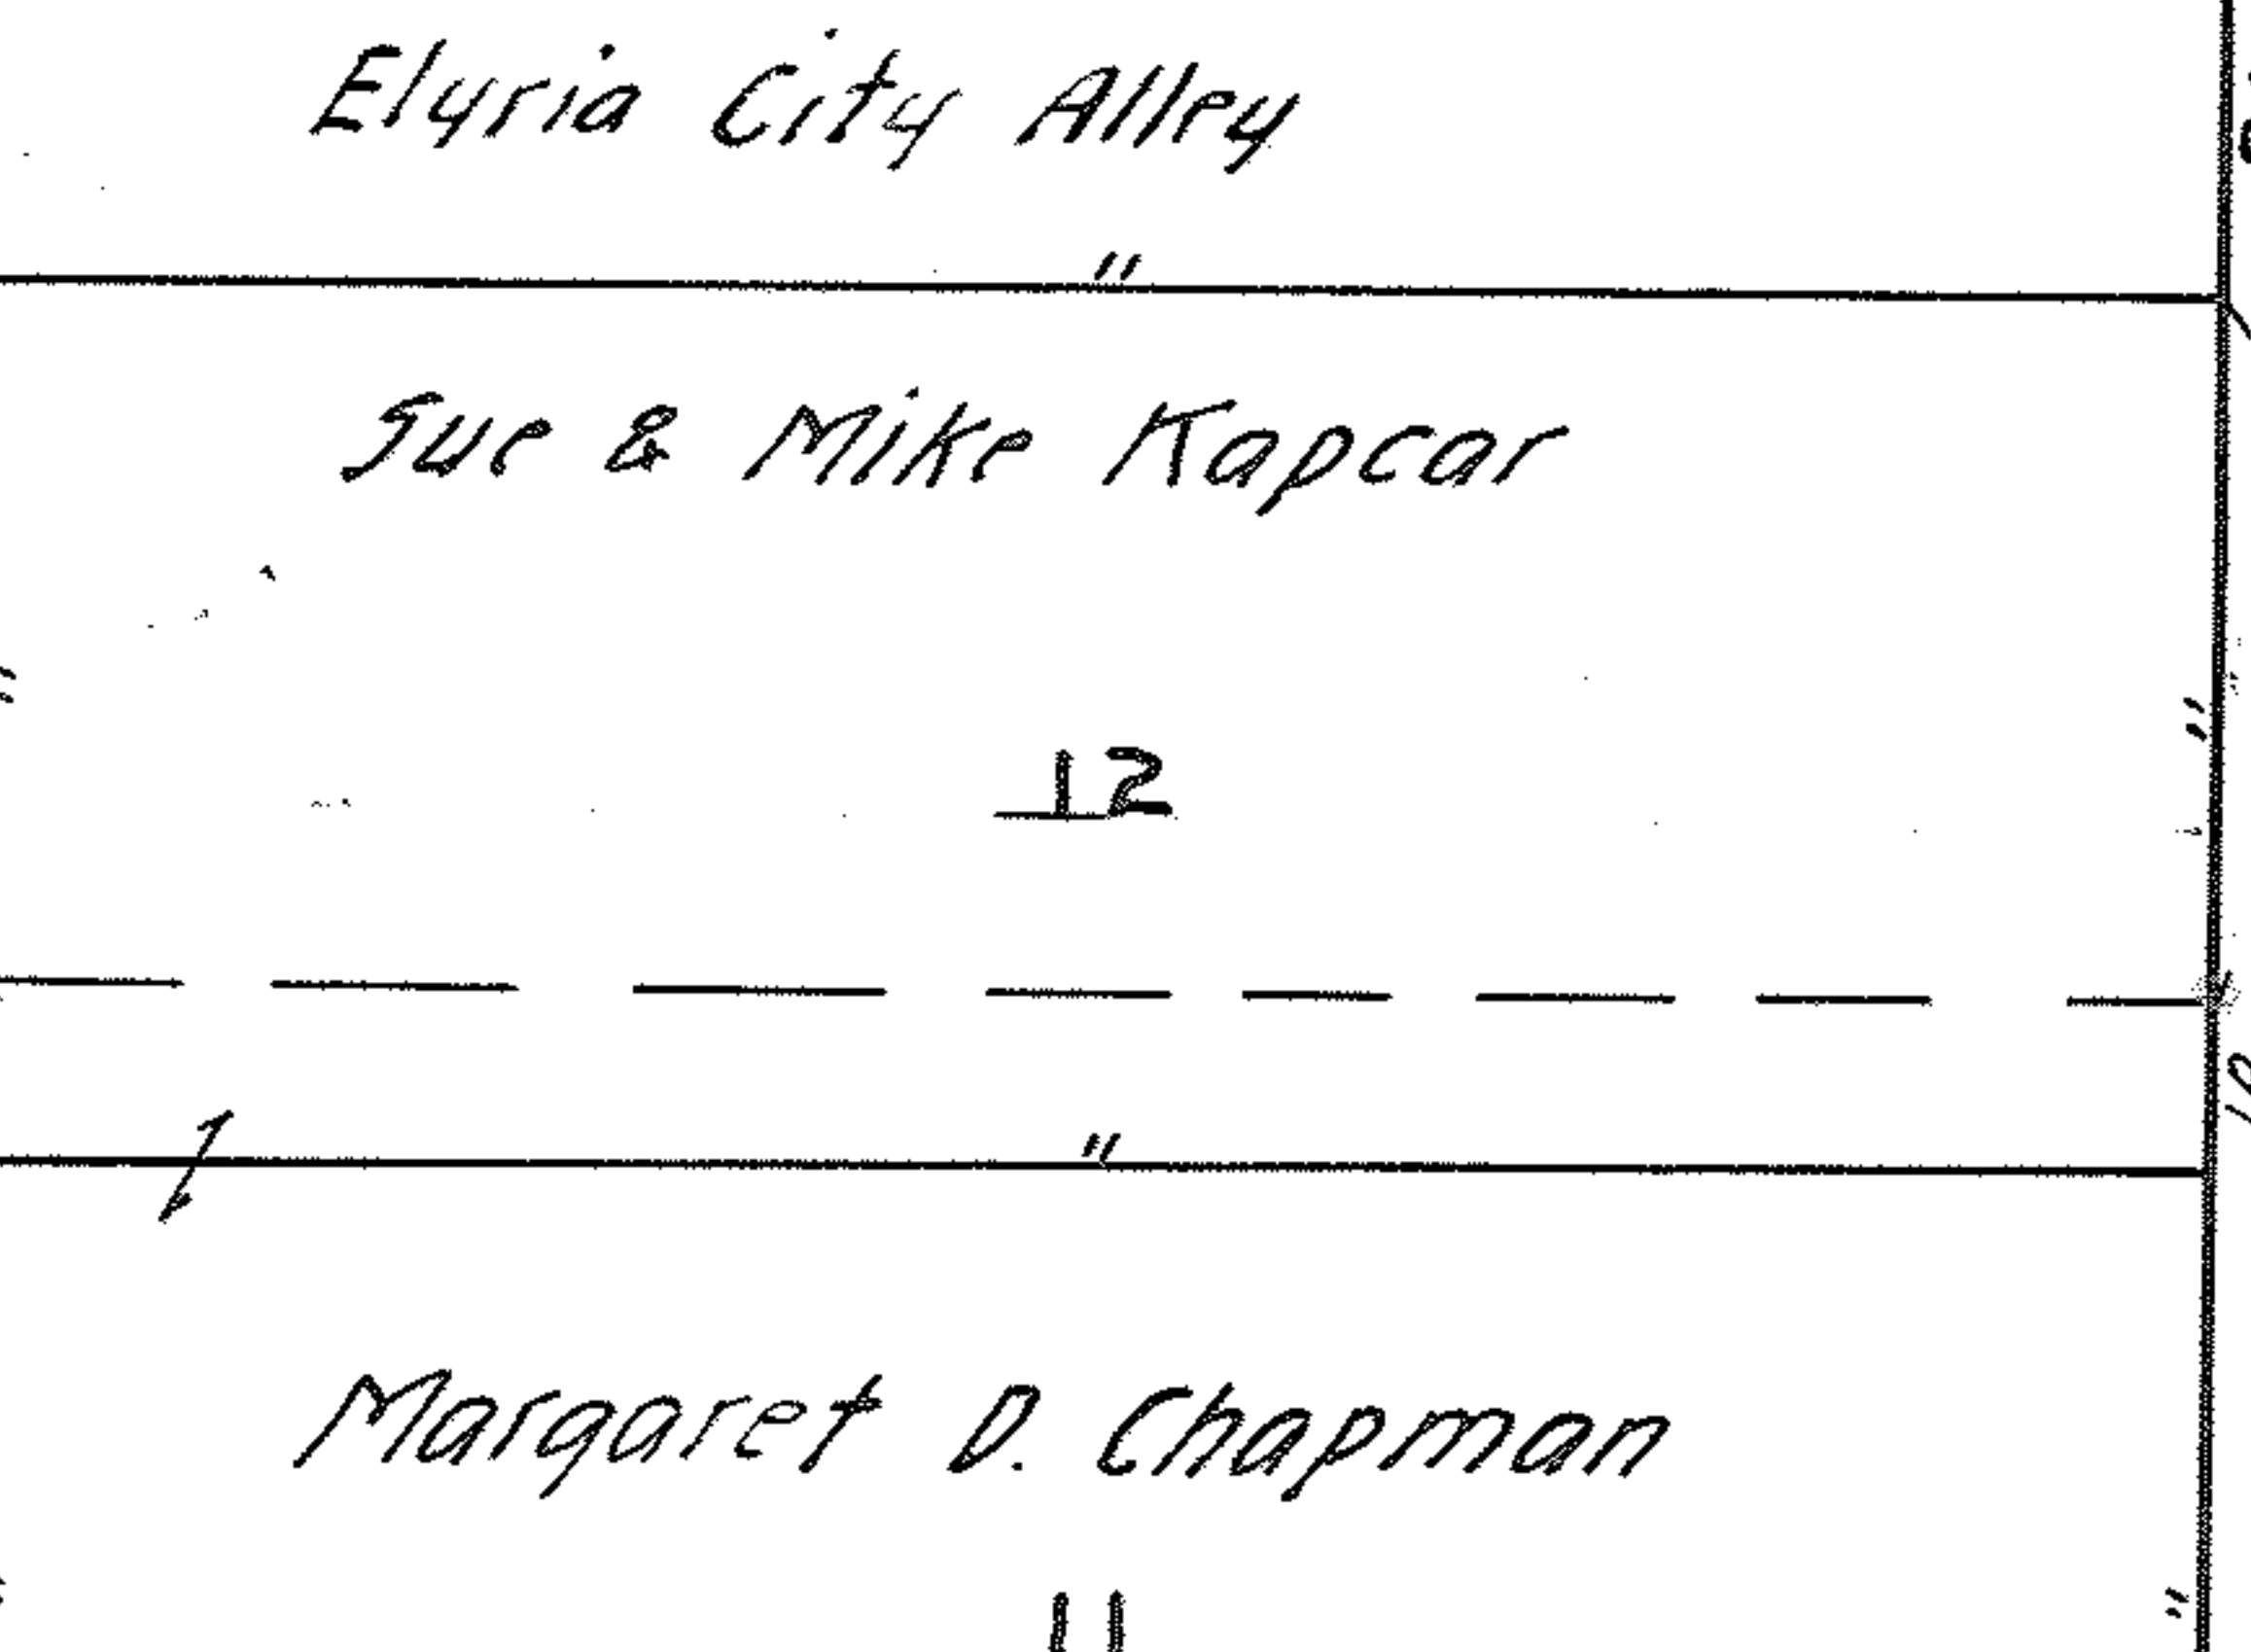
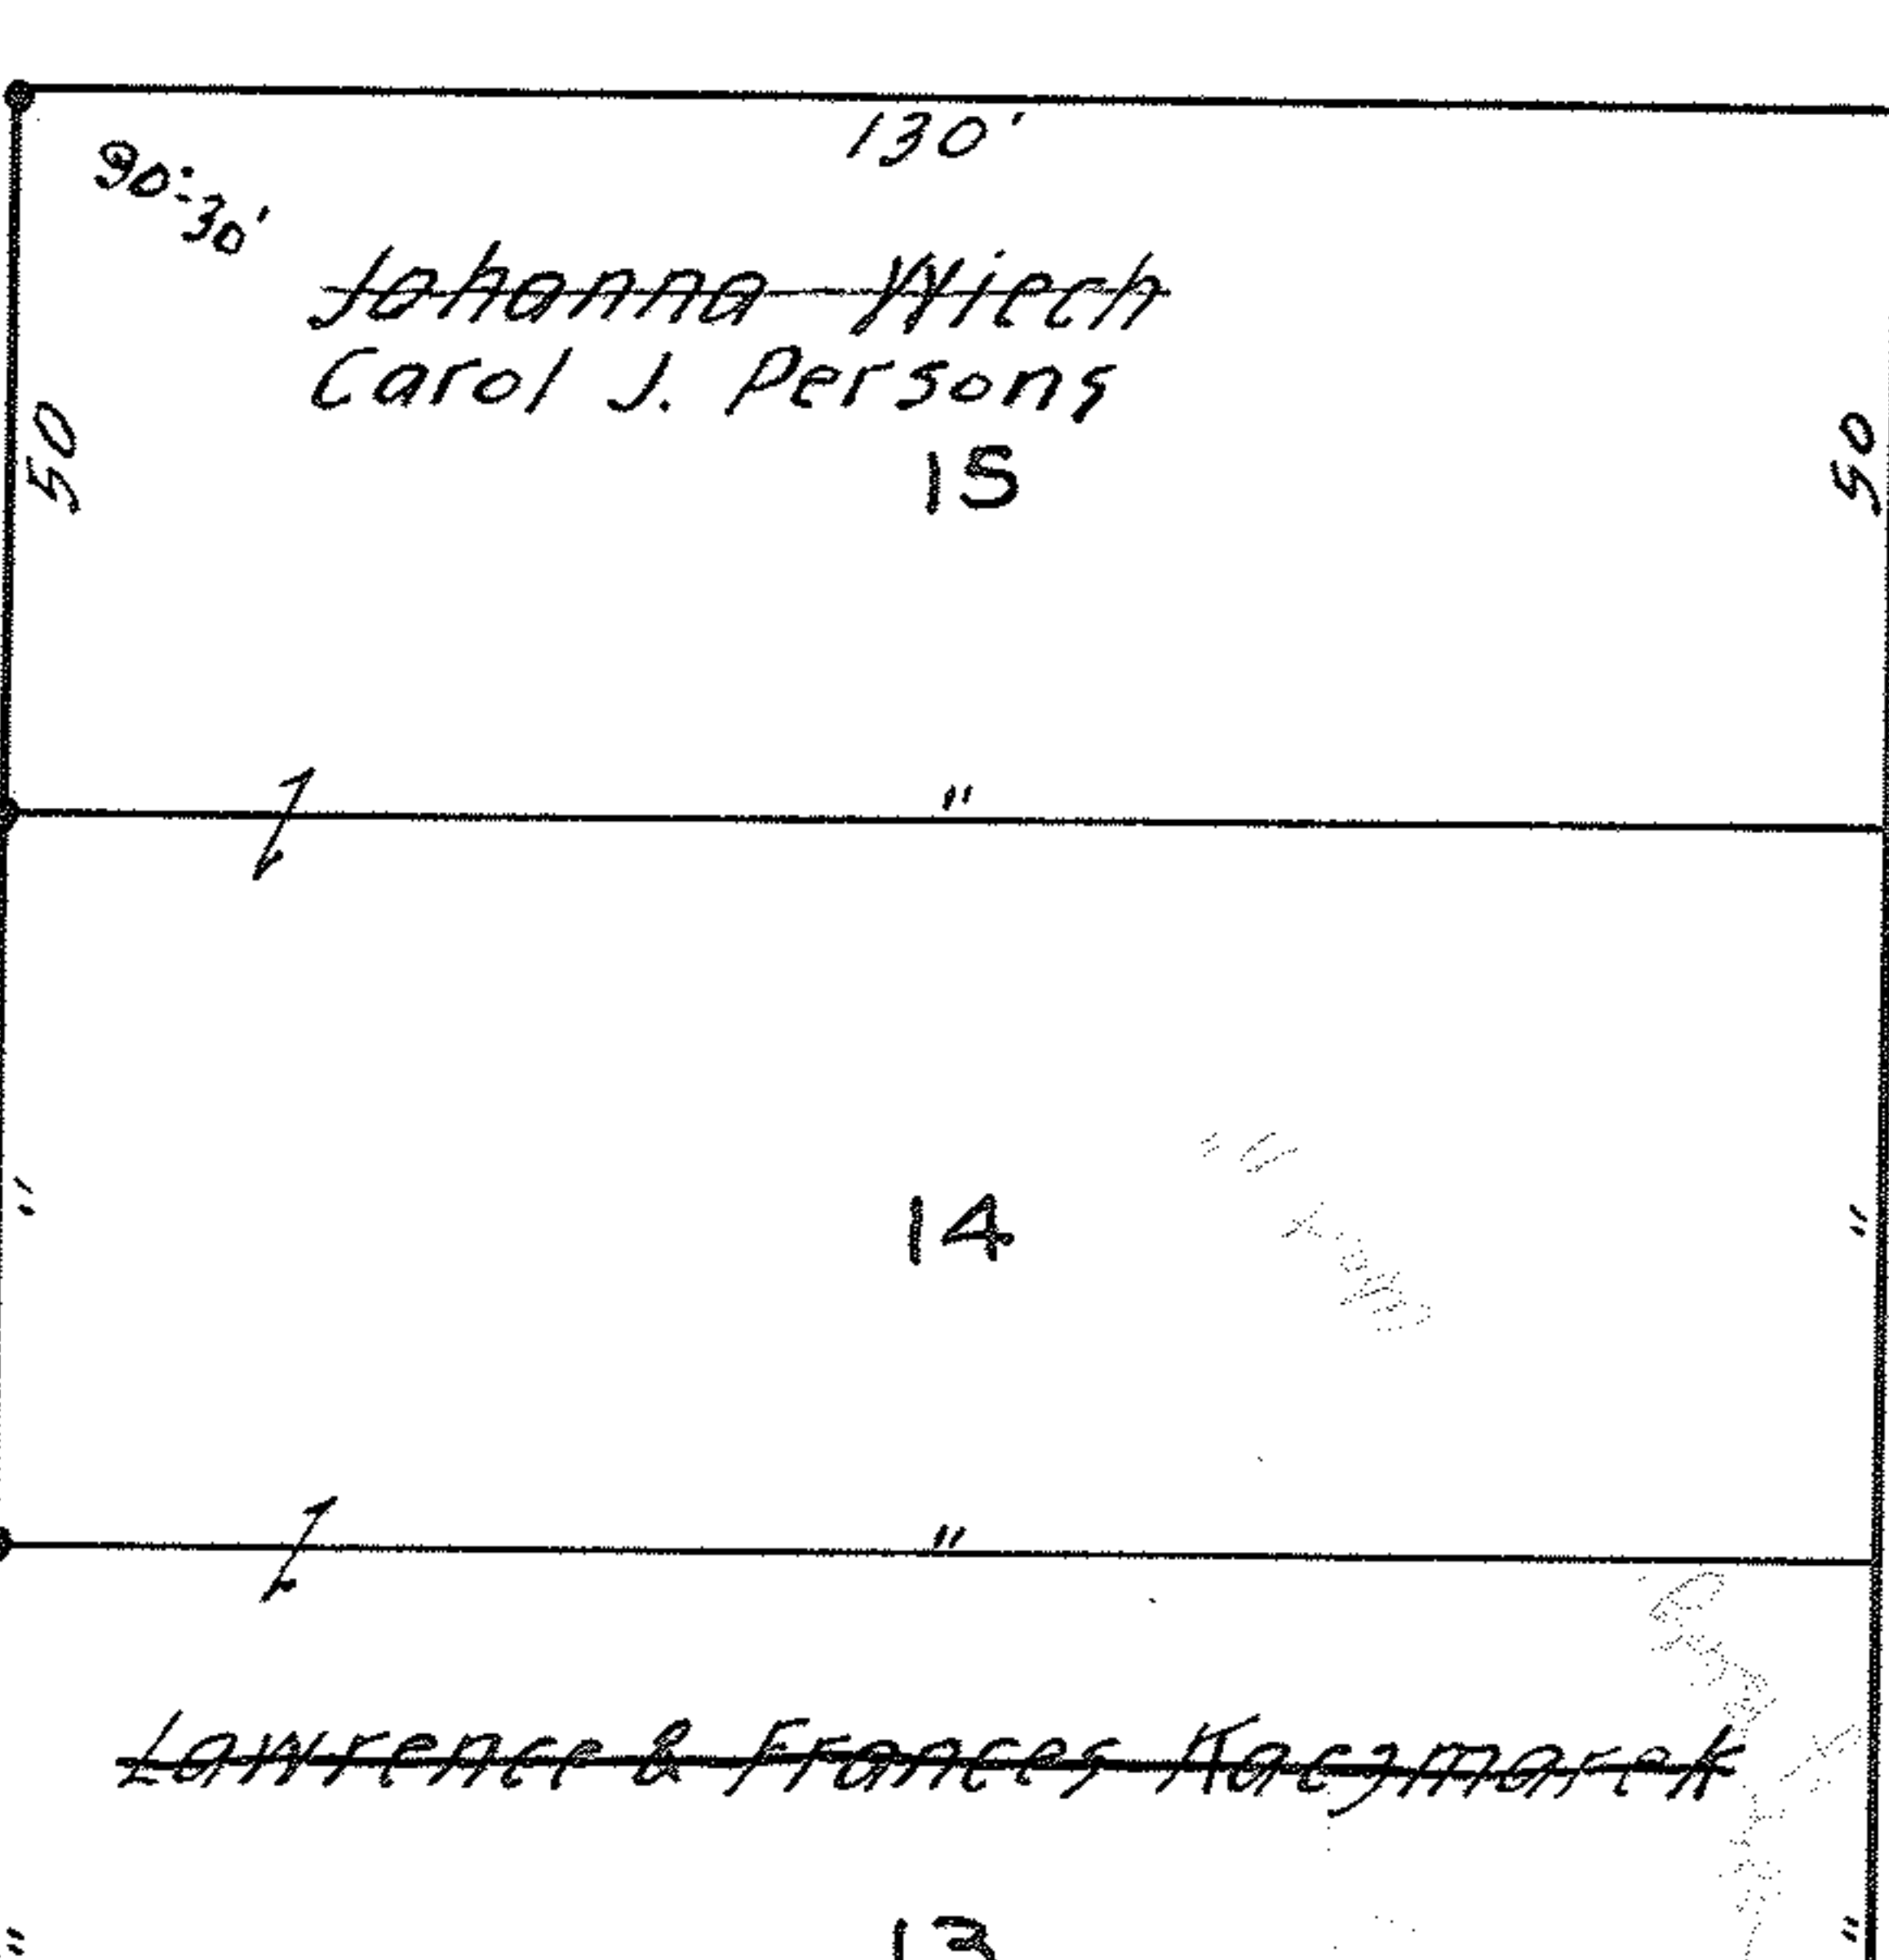


WEST STREET 66'

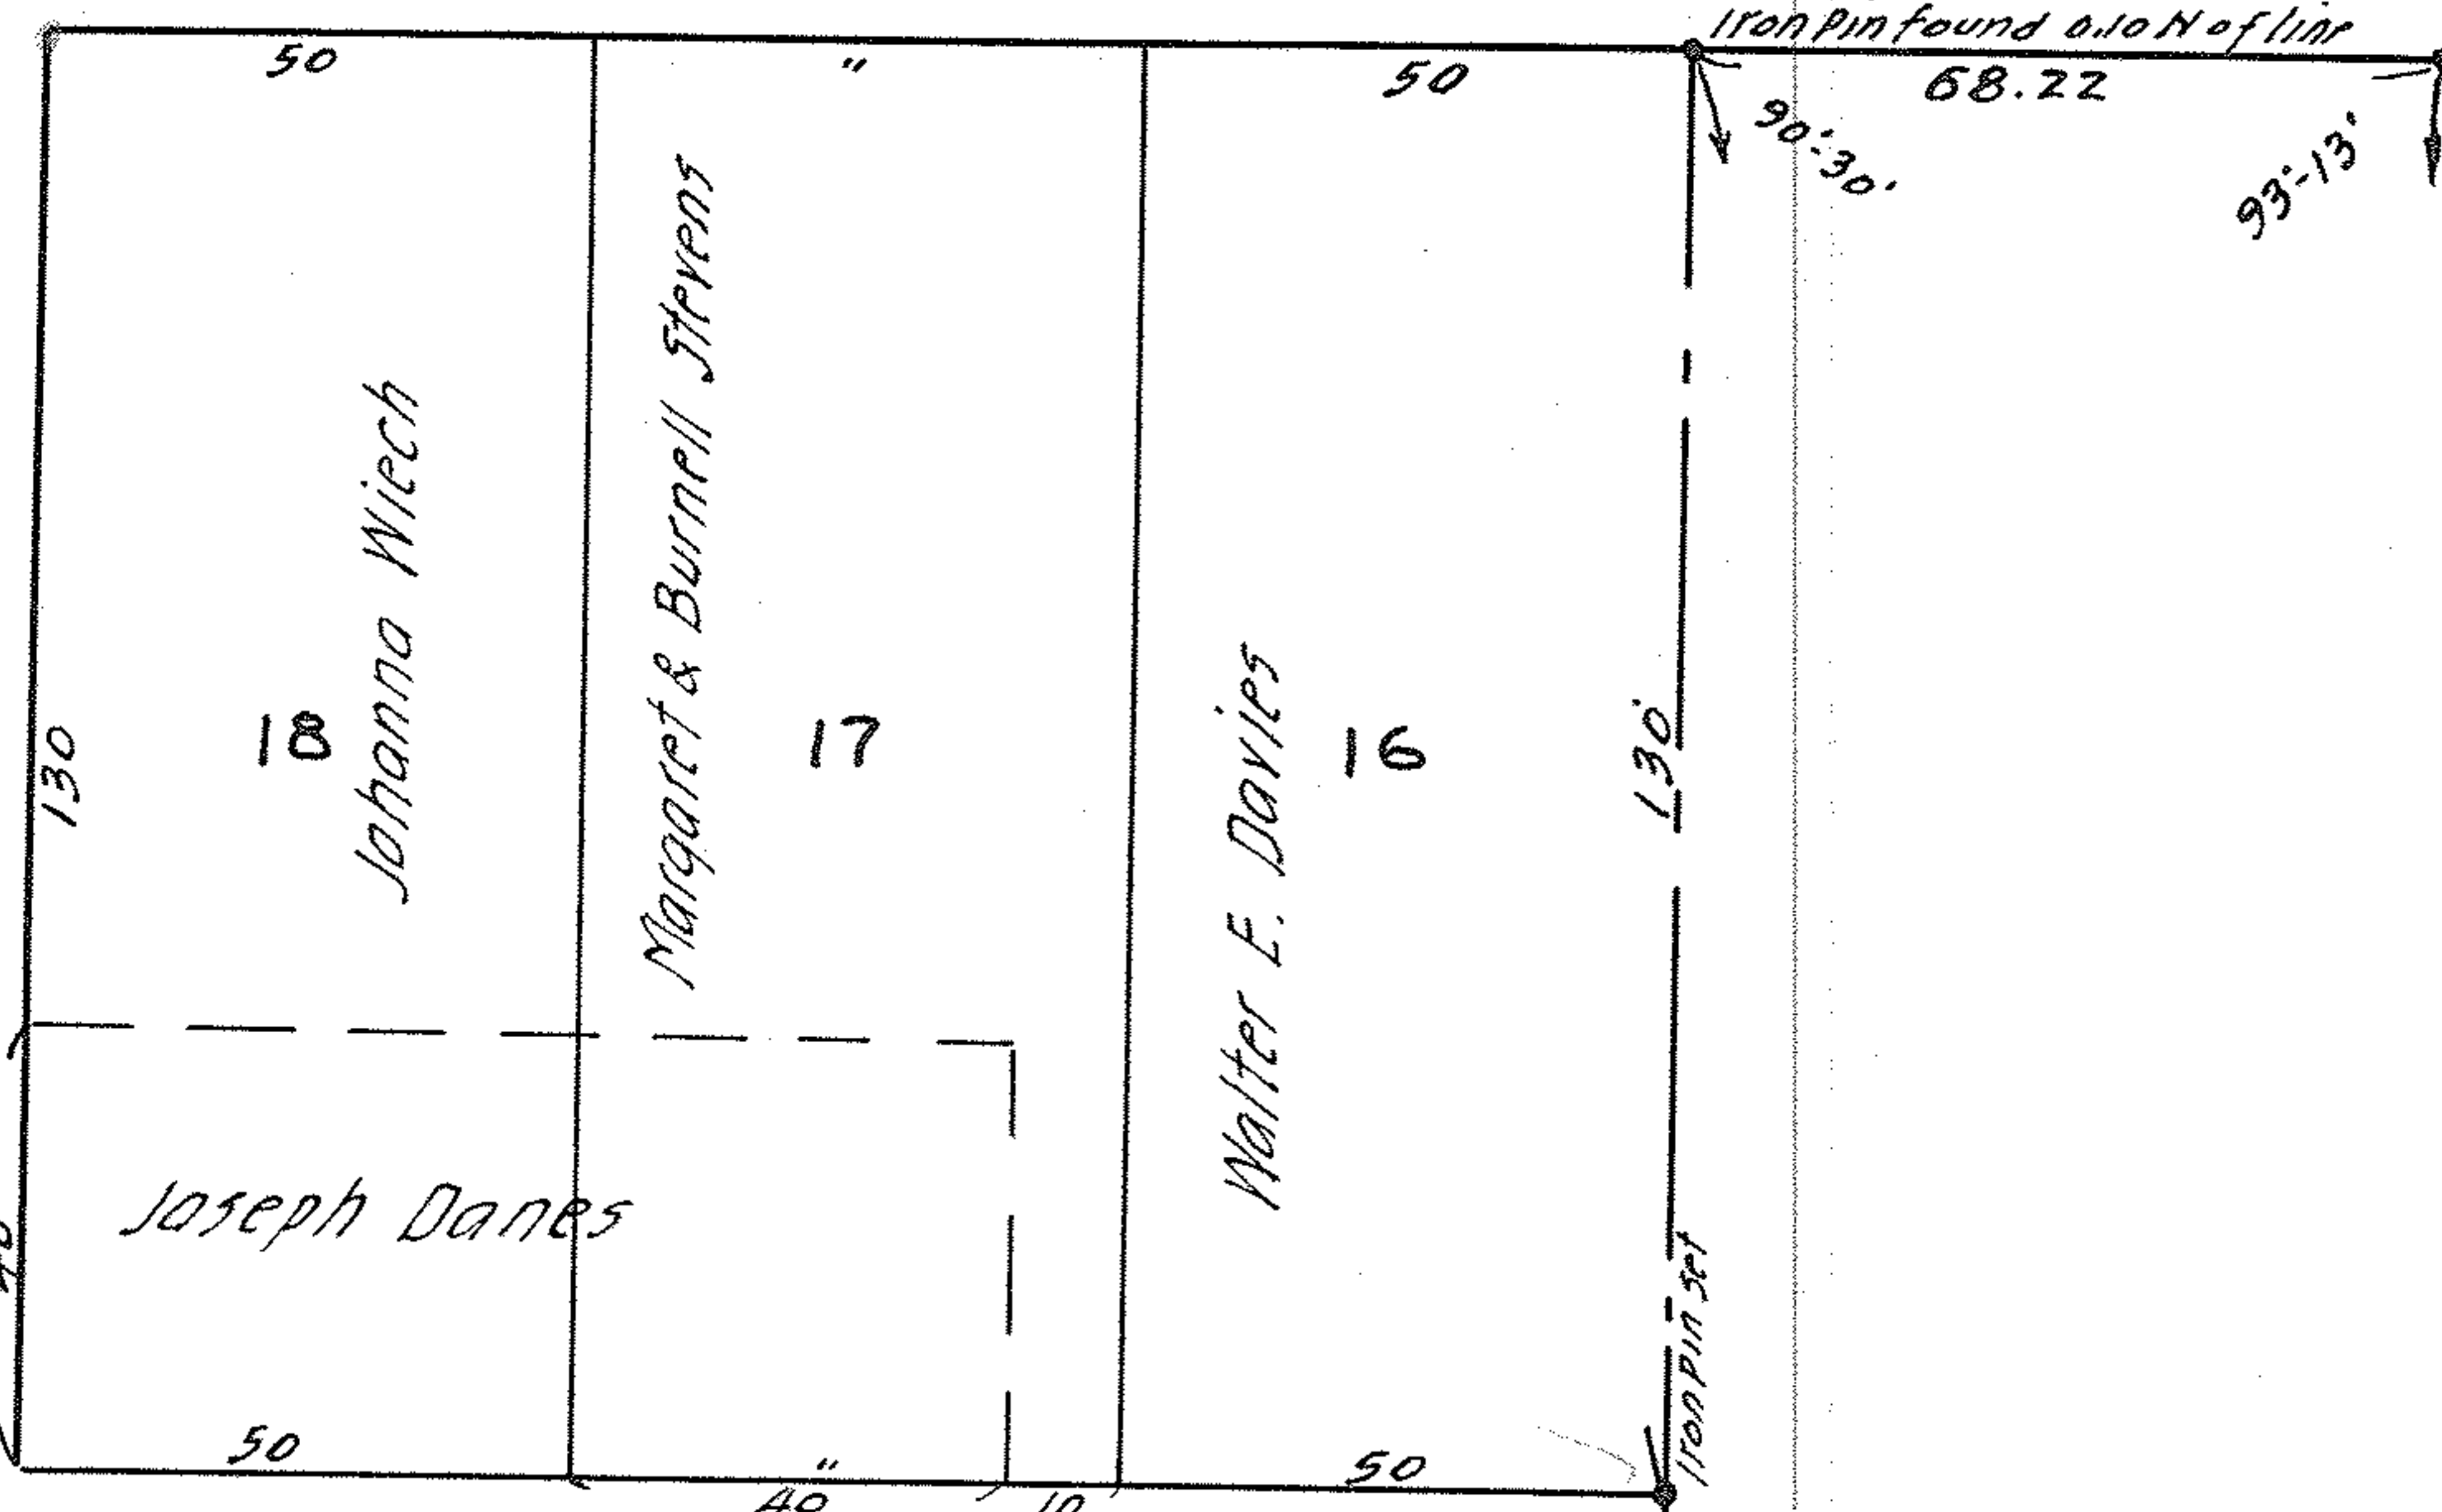

PPN 06 24-038 006 277

map Pg 6 99

1-SPCO-01

Survey For
CHARLES A. PERSONS
 Lot 88 West of Black River
 Elyria City, Lorain County Ohio.
 Scale 1" = 30' Nov. 1, 1946.
 J. W. Warden, Registered Surveyor.
 Revised May 14, 1956

