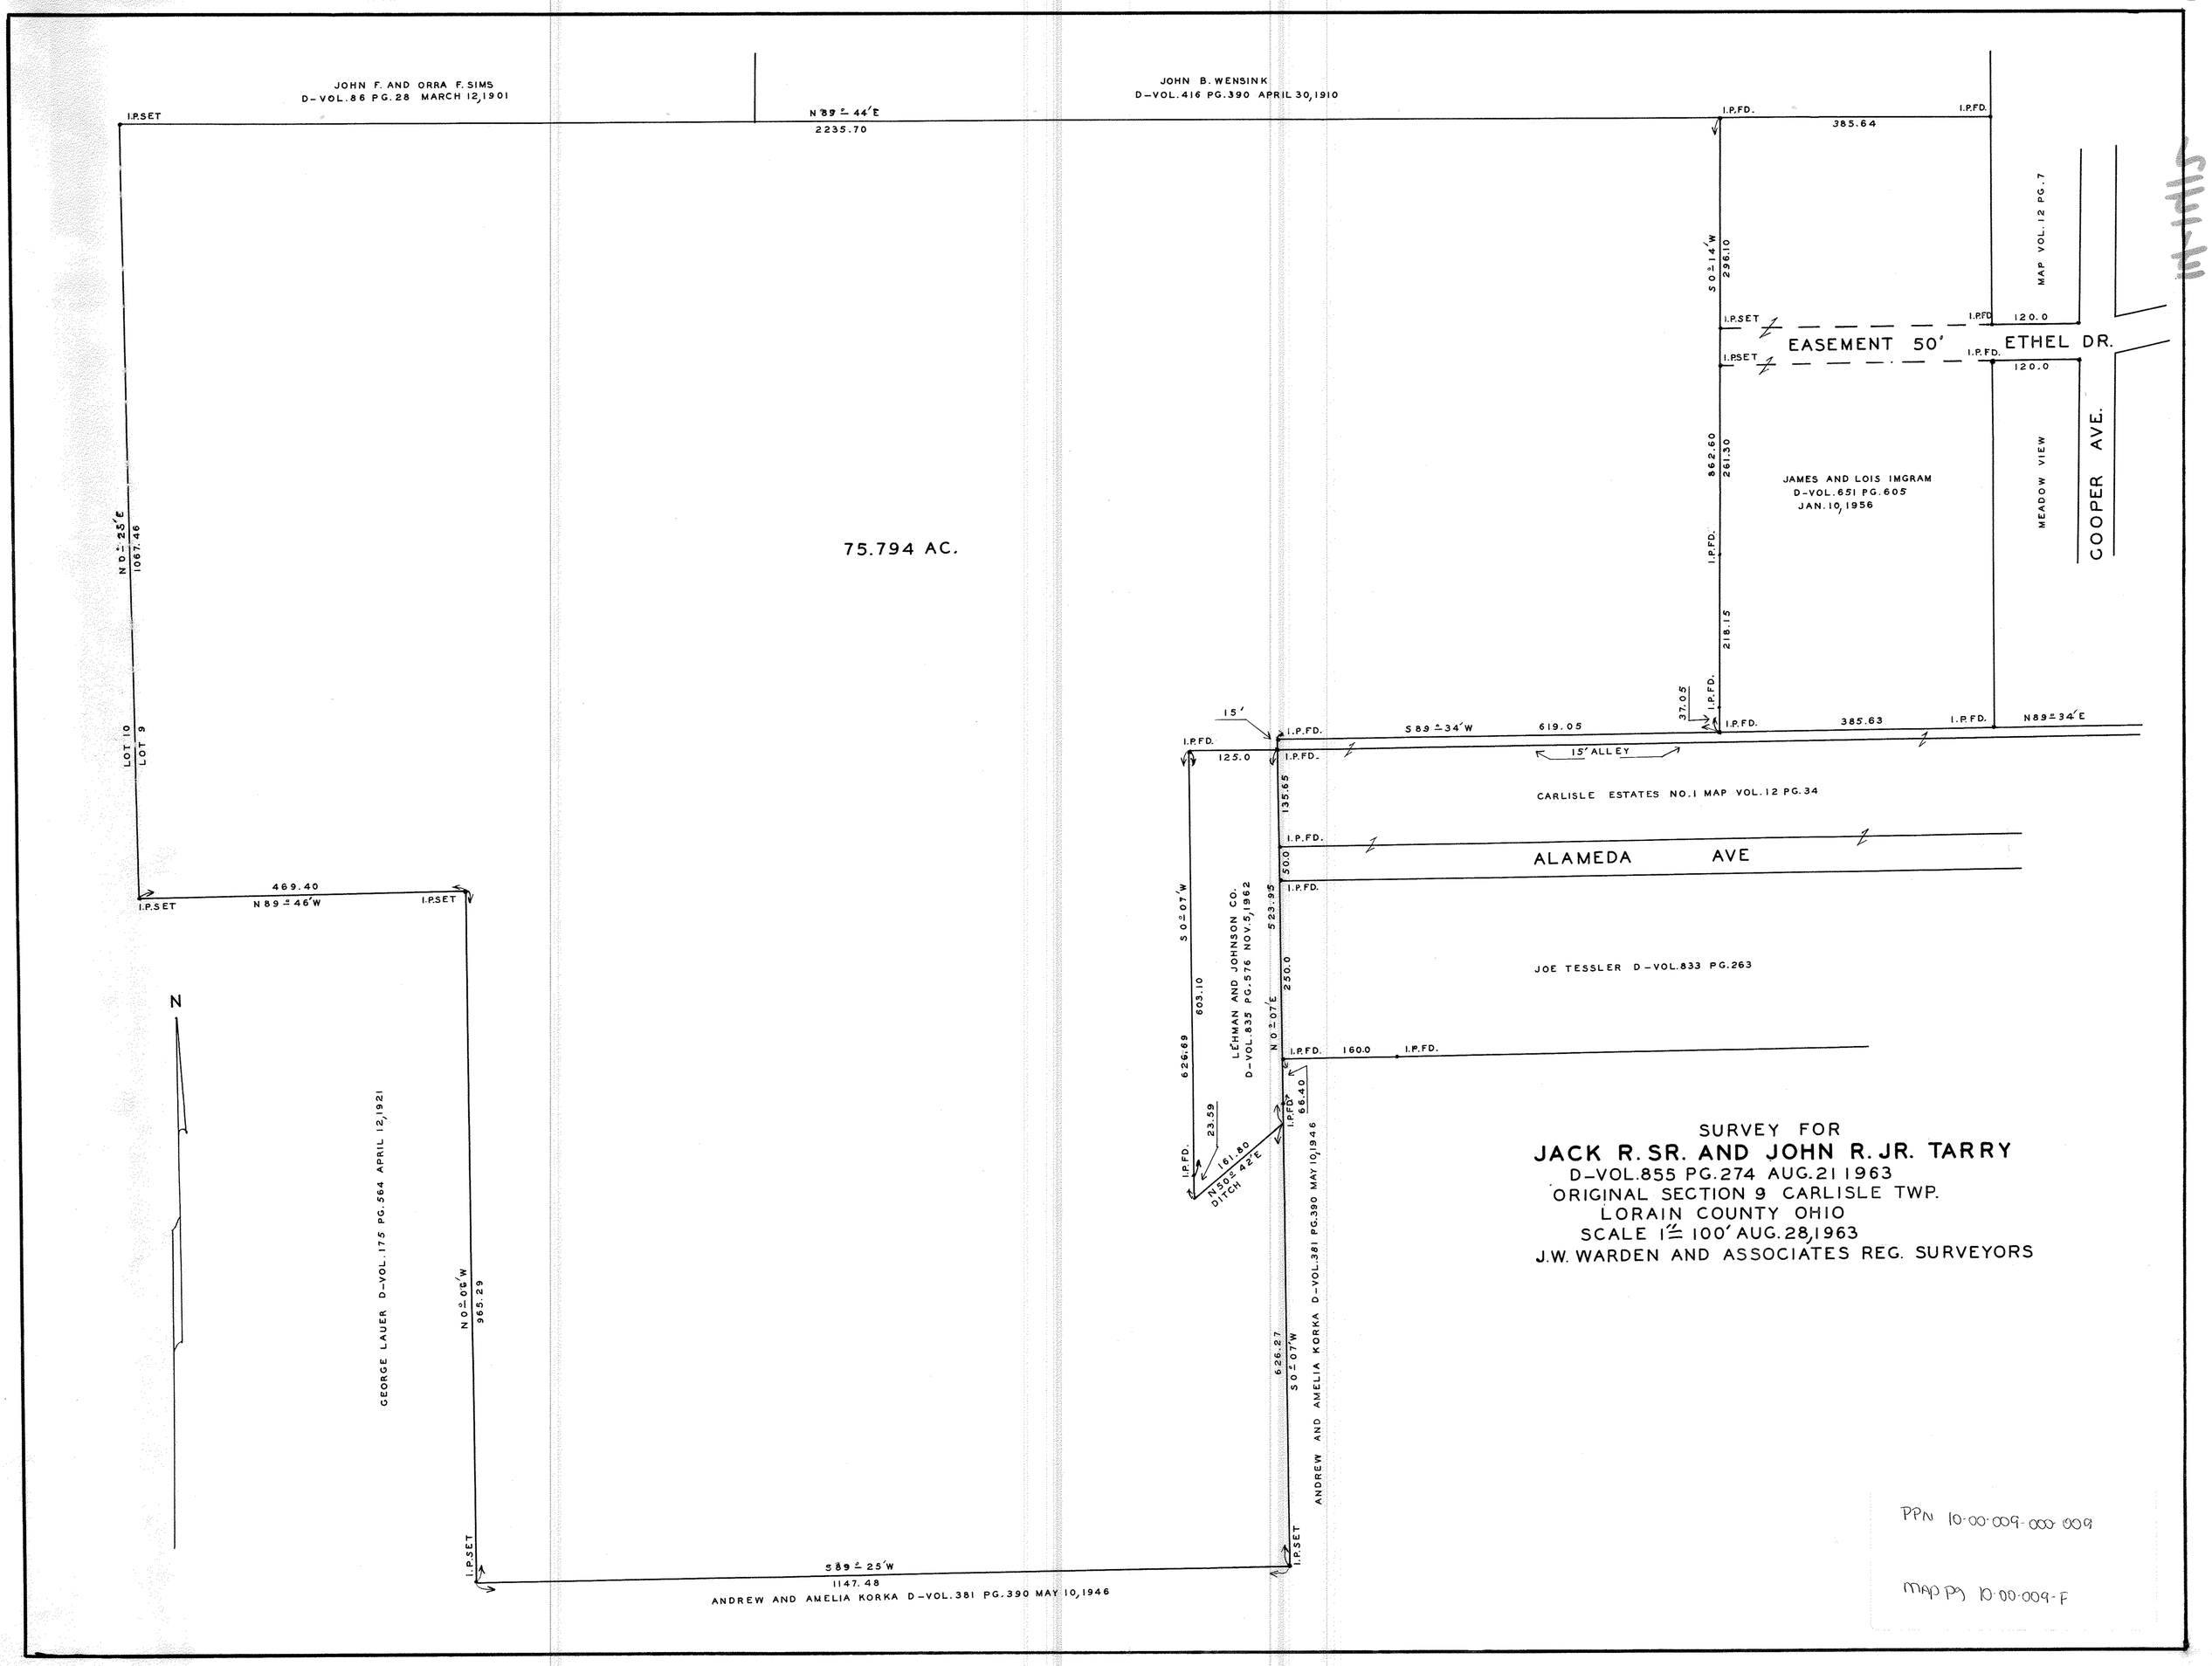

SURVEY FOR
JACK R. SR. AND JOHN R. JR. TARRY
D-VOL.855 PG.274 AUG.21 1963
ORIGINAL SECTION 9 CARLISLE TWP.
LORAIN COUNTY OHIO
SCALE 1" = 100' AUG.28,1963
J.W. WARDEN AND ASSOCIATES REG. SURVEYORS

PPN 10-00-009-000-009

MAP PG 10-00-009-F