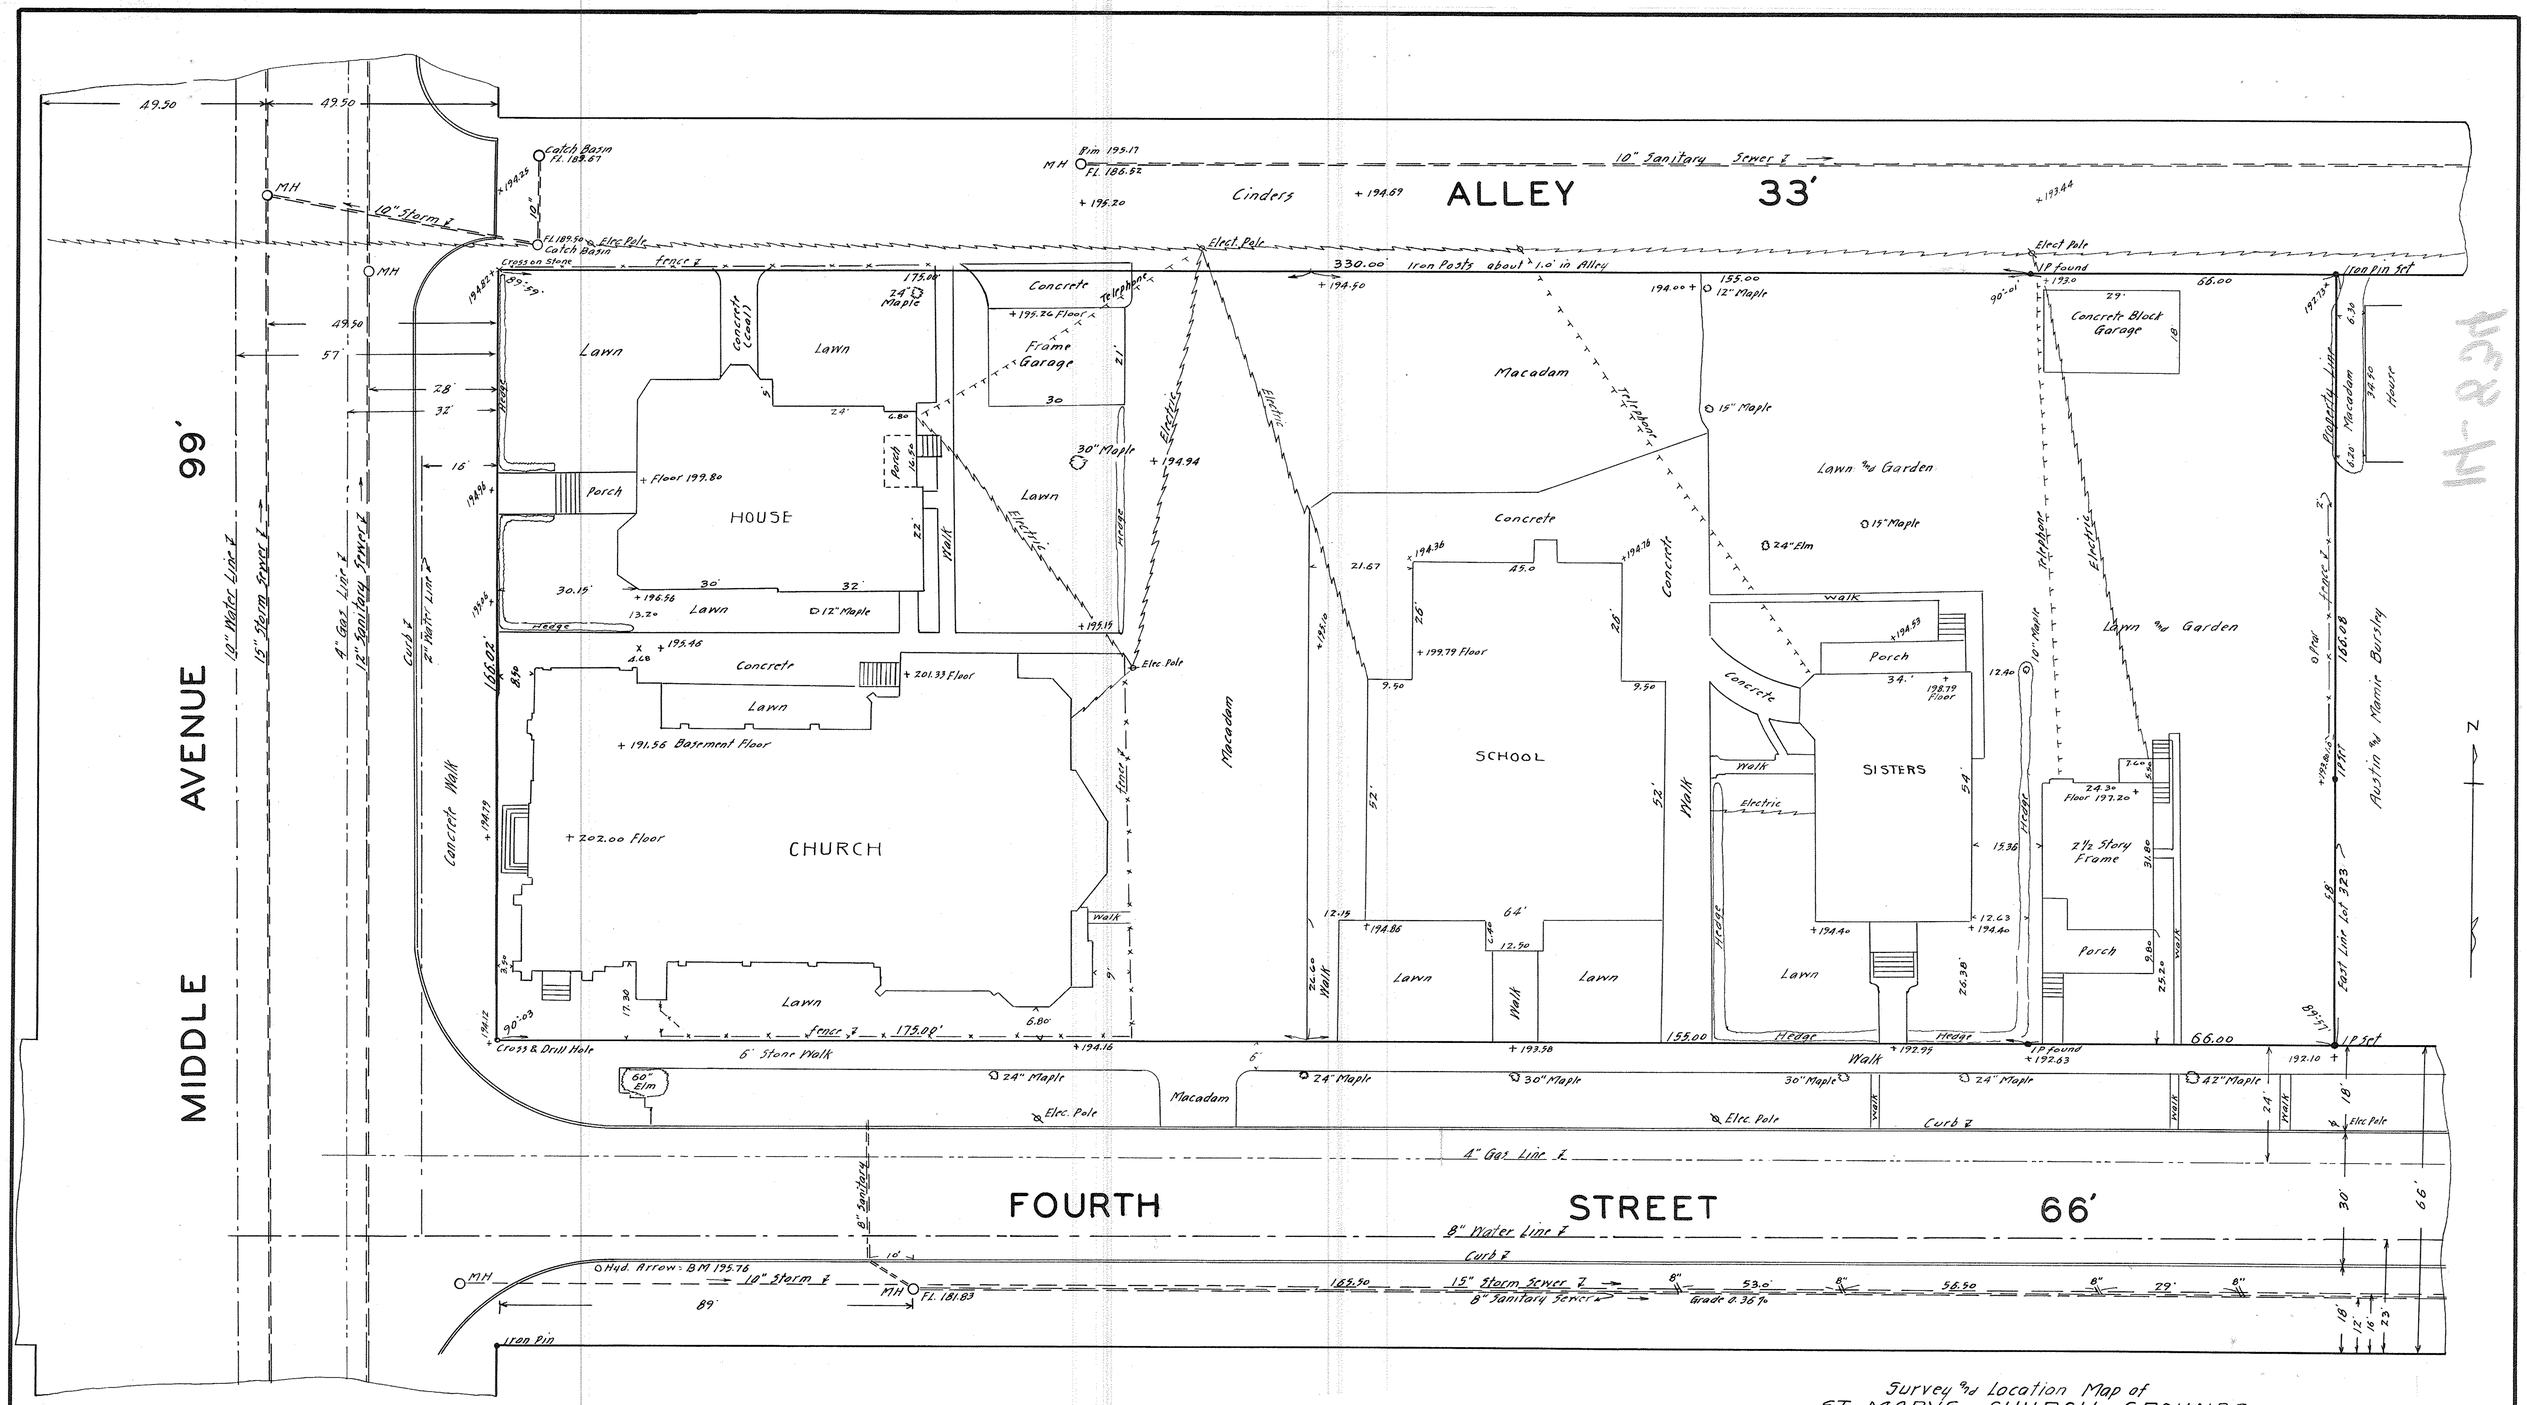
ALLEY 33'
10" Sanitary Sewer
Cinders
MIDDLE AVENUE 99'
FOURTH STREET 66'
CHURCH
HOUSE
SCHOOL
SISTERS
Concrete Block Garage
Frame Garage
2½ Story Frame
Lawn and Garden
Macadam
Concrete
Porch
Walk
Hedge
Fence
Curb
Elec. Pole
Catch Basin
MH
10" Storm Sewer
4" Gas Line
12" Sanitary Sewer
2" Water Line
Concrete Walk
6' Stone Walk
4" Gas Line
8" Sanitary
8" Water Line
15" Storm Sewer
8" Sanitary Sewer
Grade 0.36%
Hyd. Arrow: BM 195.76
Iron Pin
Iron Pins Set
Iron Pins found
Cross & Drill Hole
East Line Lot 323
Austin and Mamie Bursley
Property Line
Elec. Pole
Elect. Pole
Telephone
Electric
Floor 199.80
Floor 201.33
Floor 202.00
Basement Floor 191.56
Floor 199.79
Floor 197.20
Floor 198.79
330.00'
175.08'
155.00
66.00
186.08'
PPN 06-25-048-000-???
Map Pg 6-120
Survey and Location Map of
ST. MARYS CHURCH GROUNDS
Block 48 Lots 318-319-320-321-322-323
Original Village Plat of Elyria, Map. Vol. 3-Pg 14
Elyria City, Lorain County Ohio.
Scale 1" = 16' Dec. 9. 1946.
J. W. Warden. Registered Civil Engineer and Surveyor.
405 Elyria Block Elyria, Ohio.