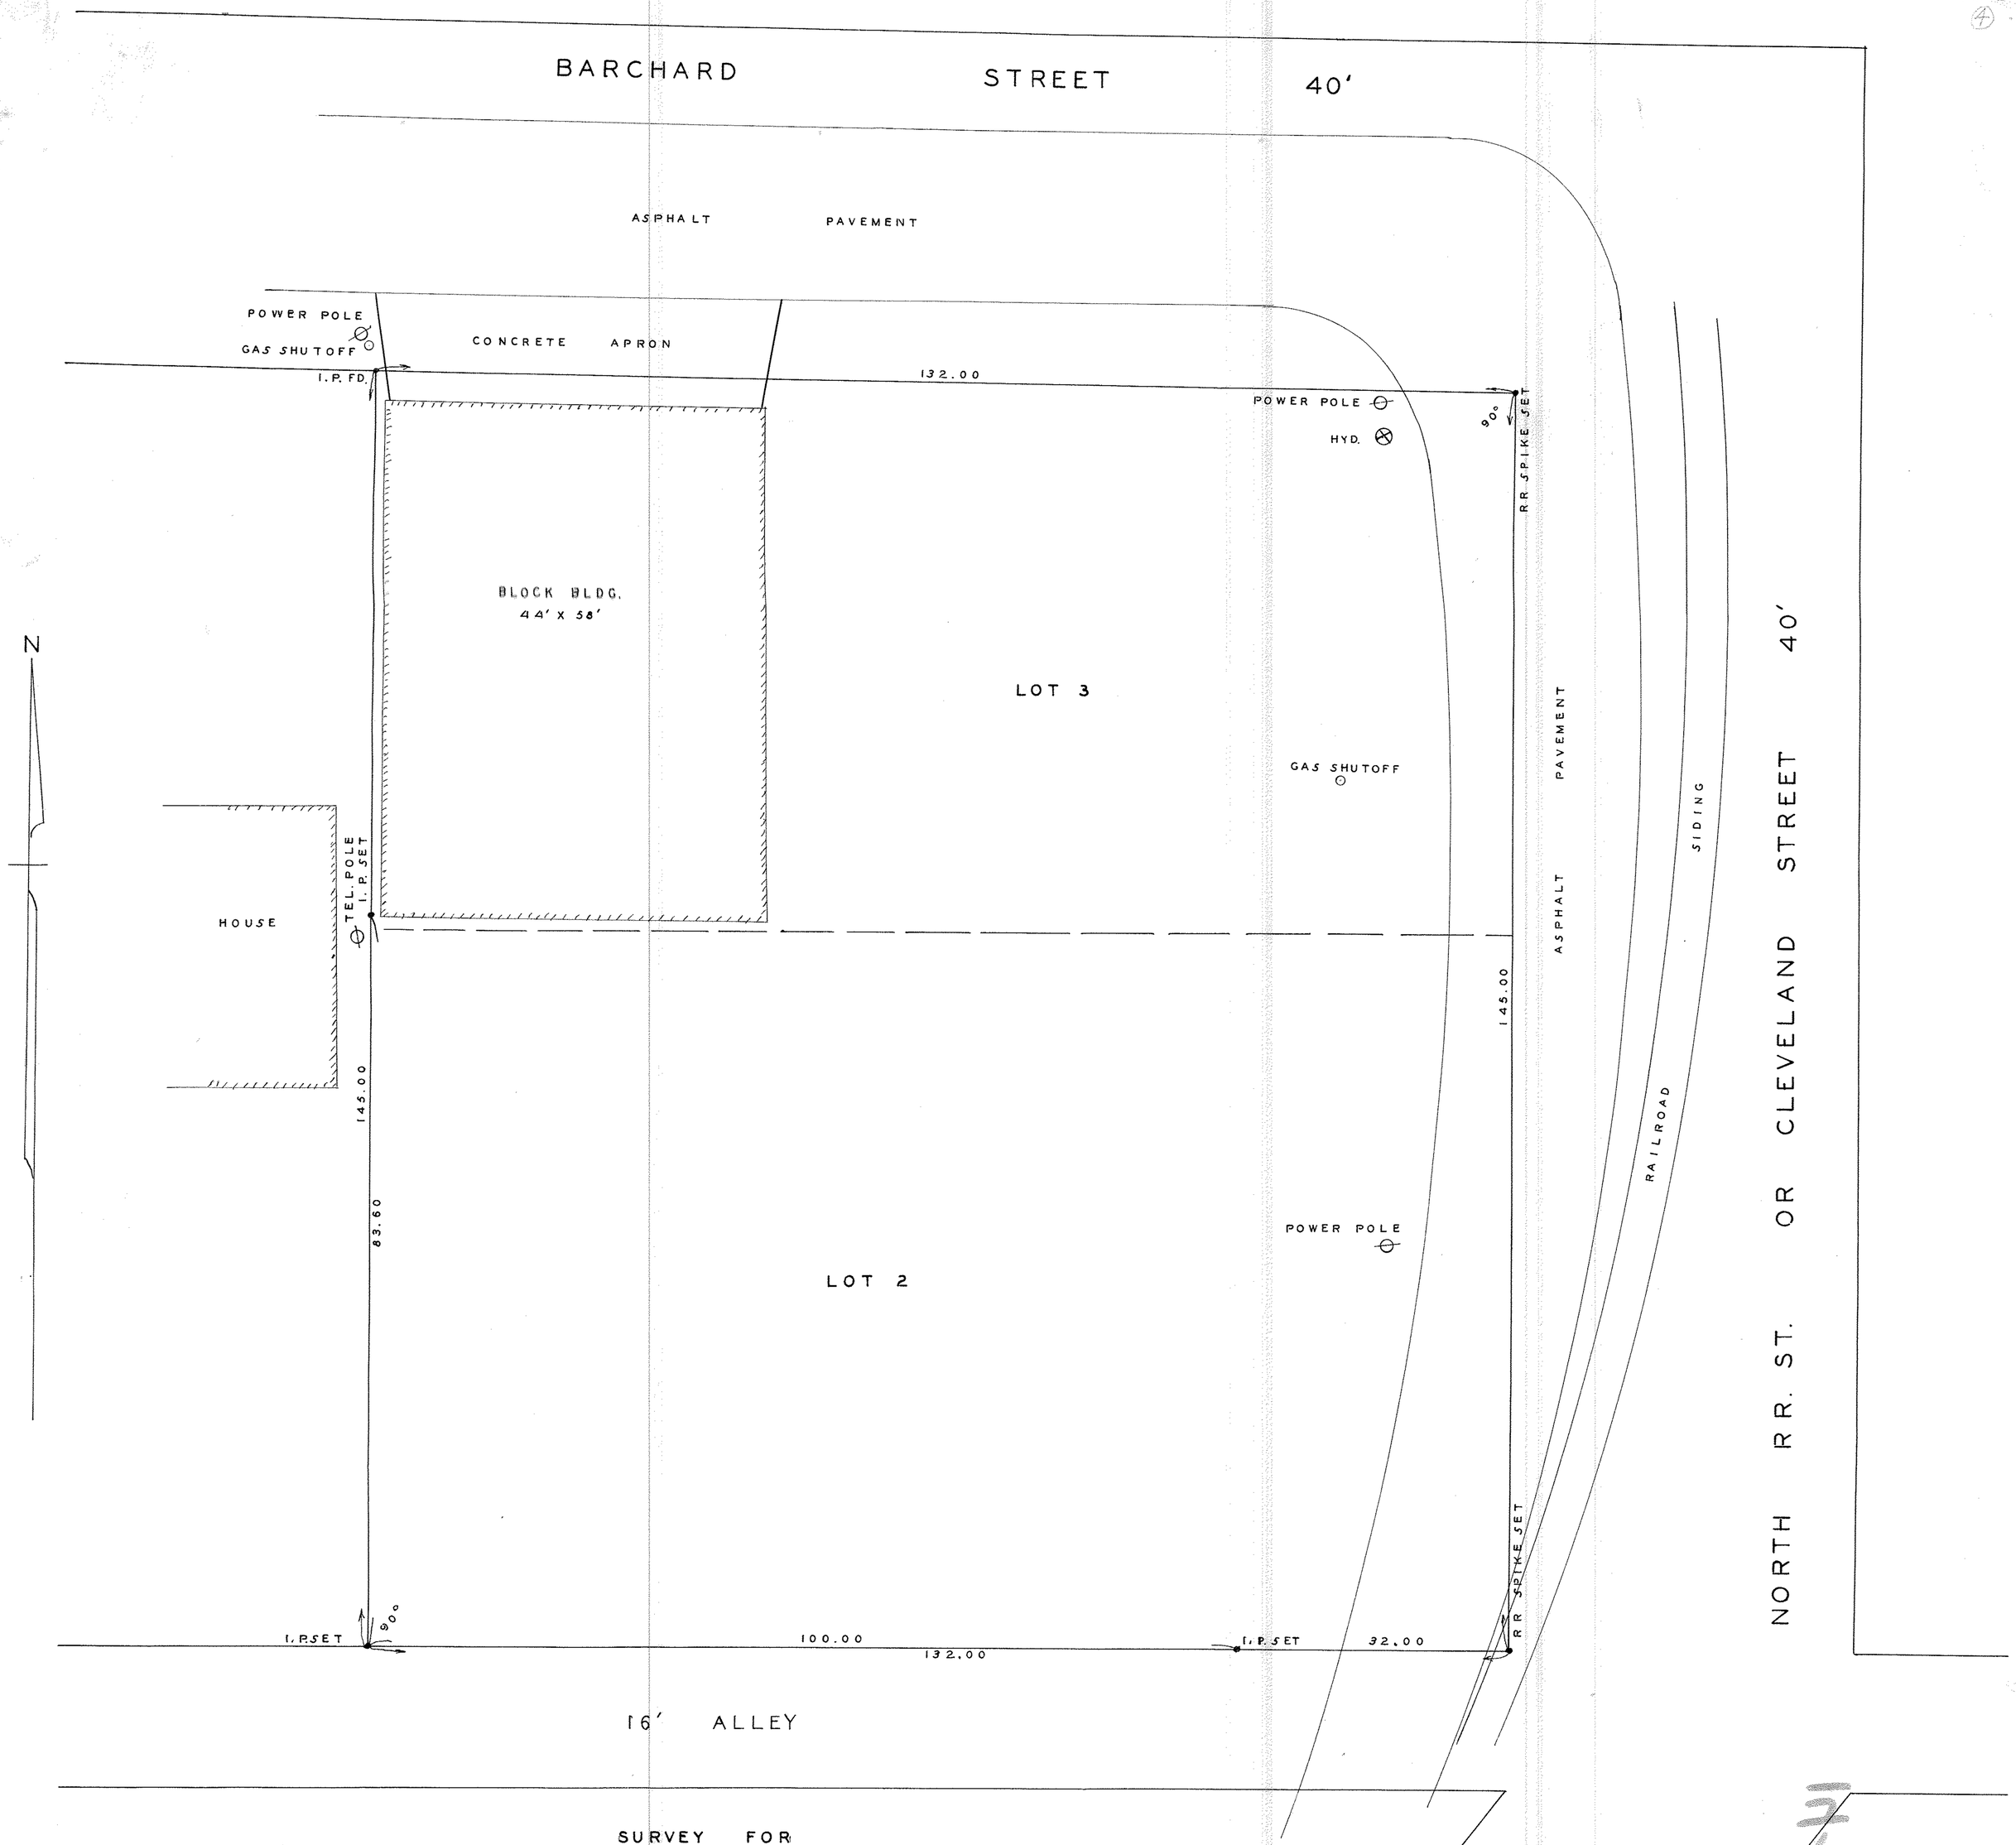

SURVEY FOR
THE LARSON FOUNDRY
SUB LOTS 2-3 BARCHARDS ADDN
MAP VOL 4 PAGE 30
O.L. 81 EATON TWP. GRAFTON VILLAGE
LORAIN COUNTY, OHIO
SCALE 1" = 10' JUNE 18, 1964
J.W. WARDEN AND ASSOCIATES
REG. SURVEYORS

STATE OF OHIO
D.B. AMBRUS
328
REGISTERED
SURVEYOR

PPN 11-00-081-000-???

MAP PG 11-00-081.

14-1441