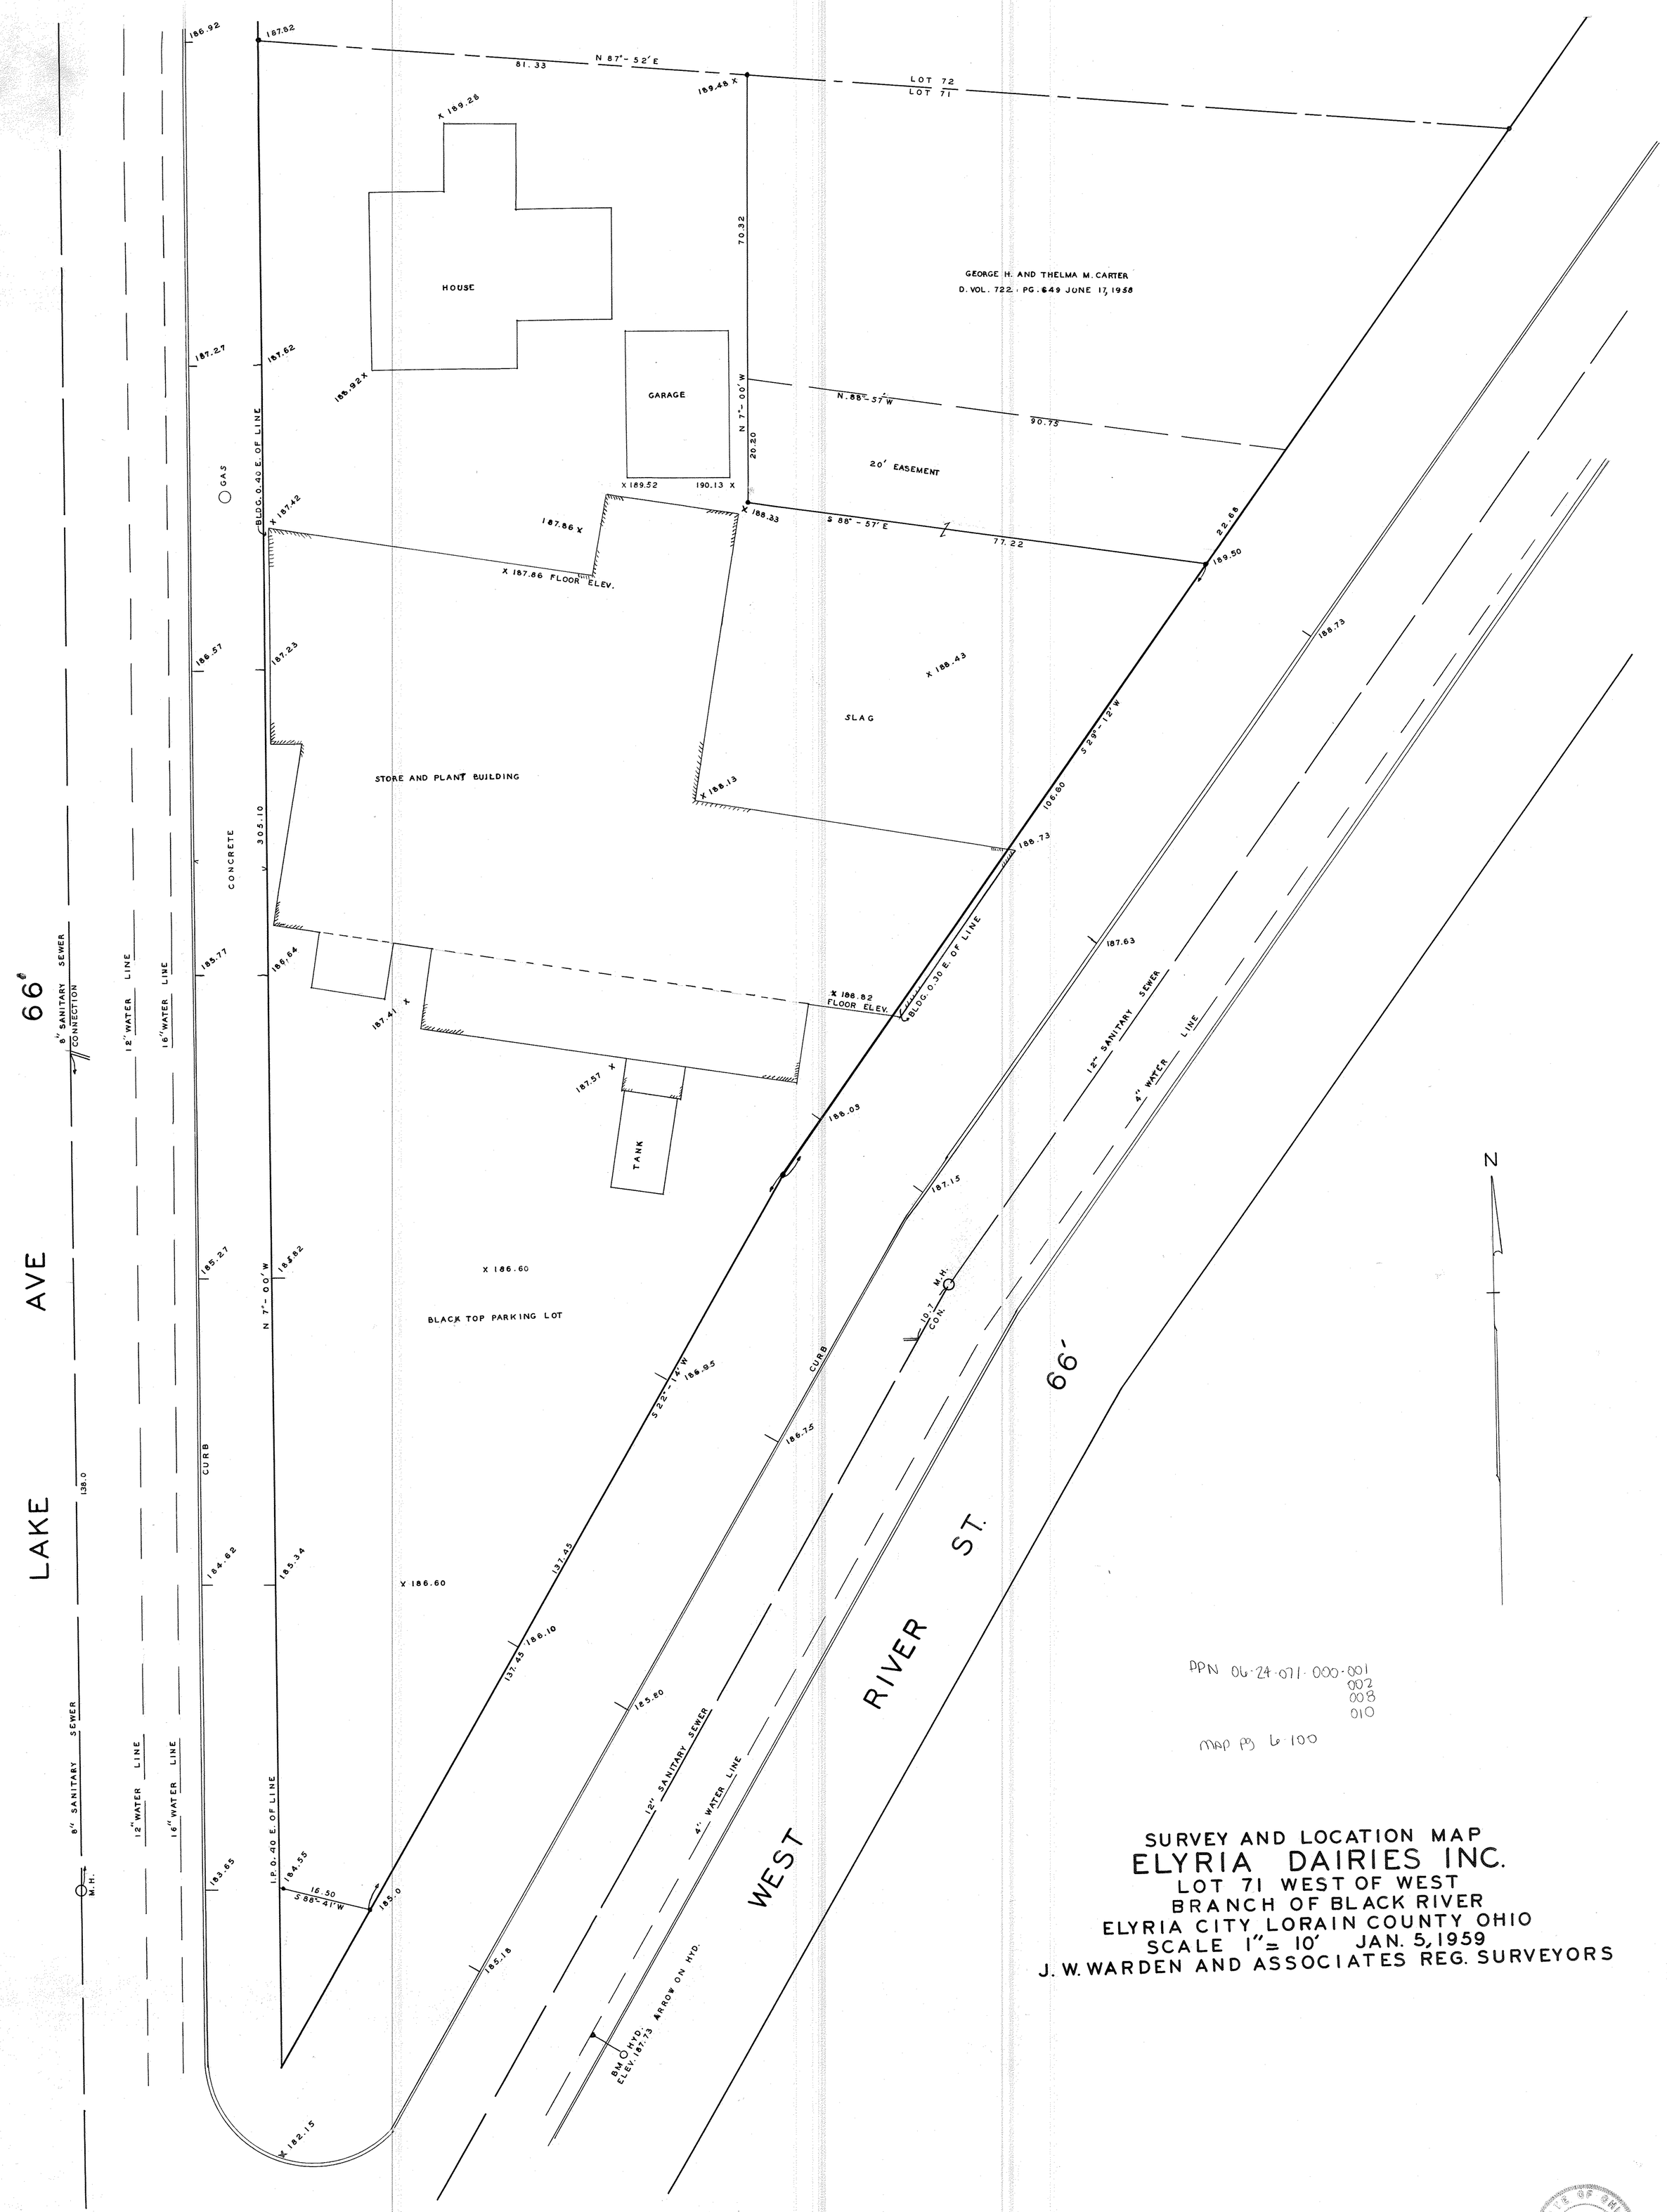

APN 06-24-071-000-001
002
008
010

MAP PG 6-100

SURVEY AND LOCATION MAP
ELYRIA DAIRIES INC.
LOT 71 WEST OF WEST
BRANCH OF BLACK RIVER
ELYRIA CITY, LORAIN COUNTY OHIO
SCALE 1" = 10' JAN. 5, 1959
J. W. WARDEN AND ASSOCIATES REG. SURVEYORS

14-1110