


PPN 07-00-004-104 ???

Map Pg 07-00-004-C

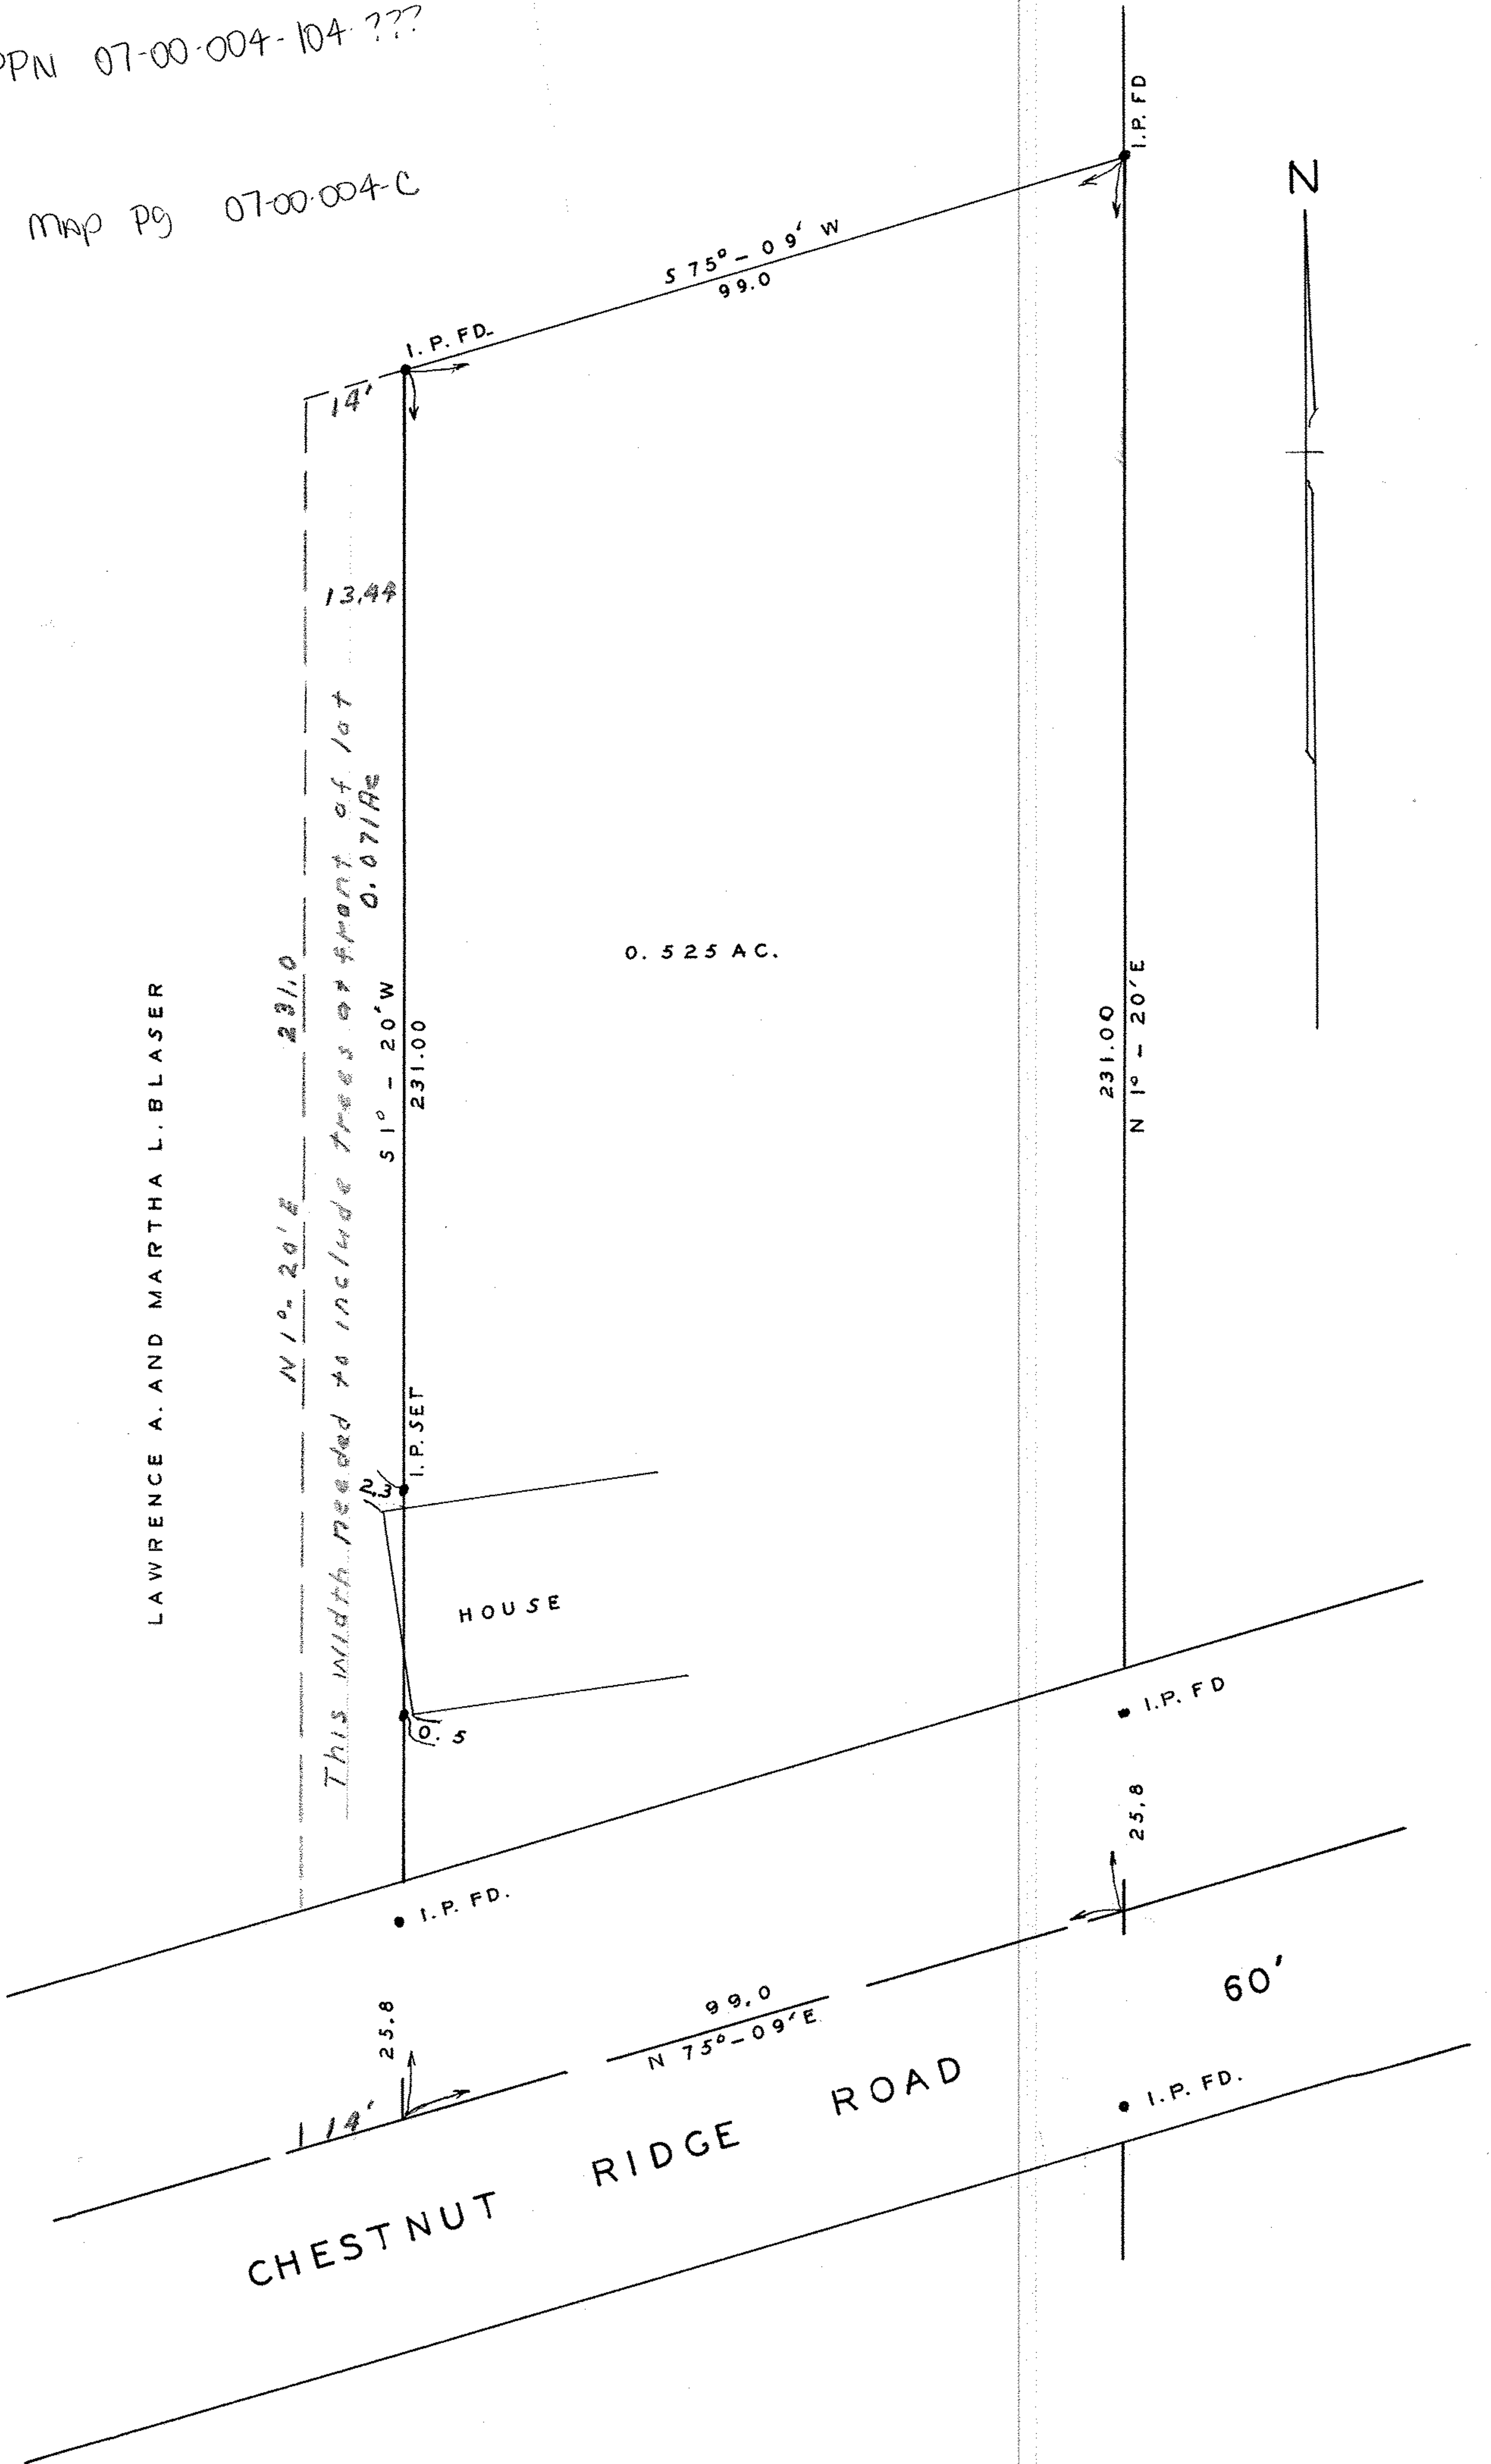

SURVEY FOR
 WM. F. AND EMMA WINTERFIELD
 O. L. h RIDGEVILLE TOWNSHIP
 N. RIDGEVILLE CITY, LORAIN CO. OHIO
 SCALE 1" = 20' JULY 27, 1964
 J. W. WARDEN AND ASSOCIATES
 REG. SURVEYORS

14-1443