


CP11-41

Farmland Foundation Inc. D-Vol. 287 Pg. 399 Aug. 12, 1937

Anthony F. & Elizabeth E. Radsyick D-Vol. 420 Pg. 78 Aug. 18, 1947.

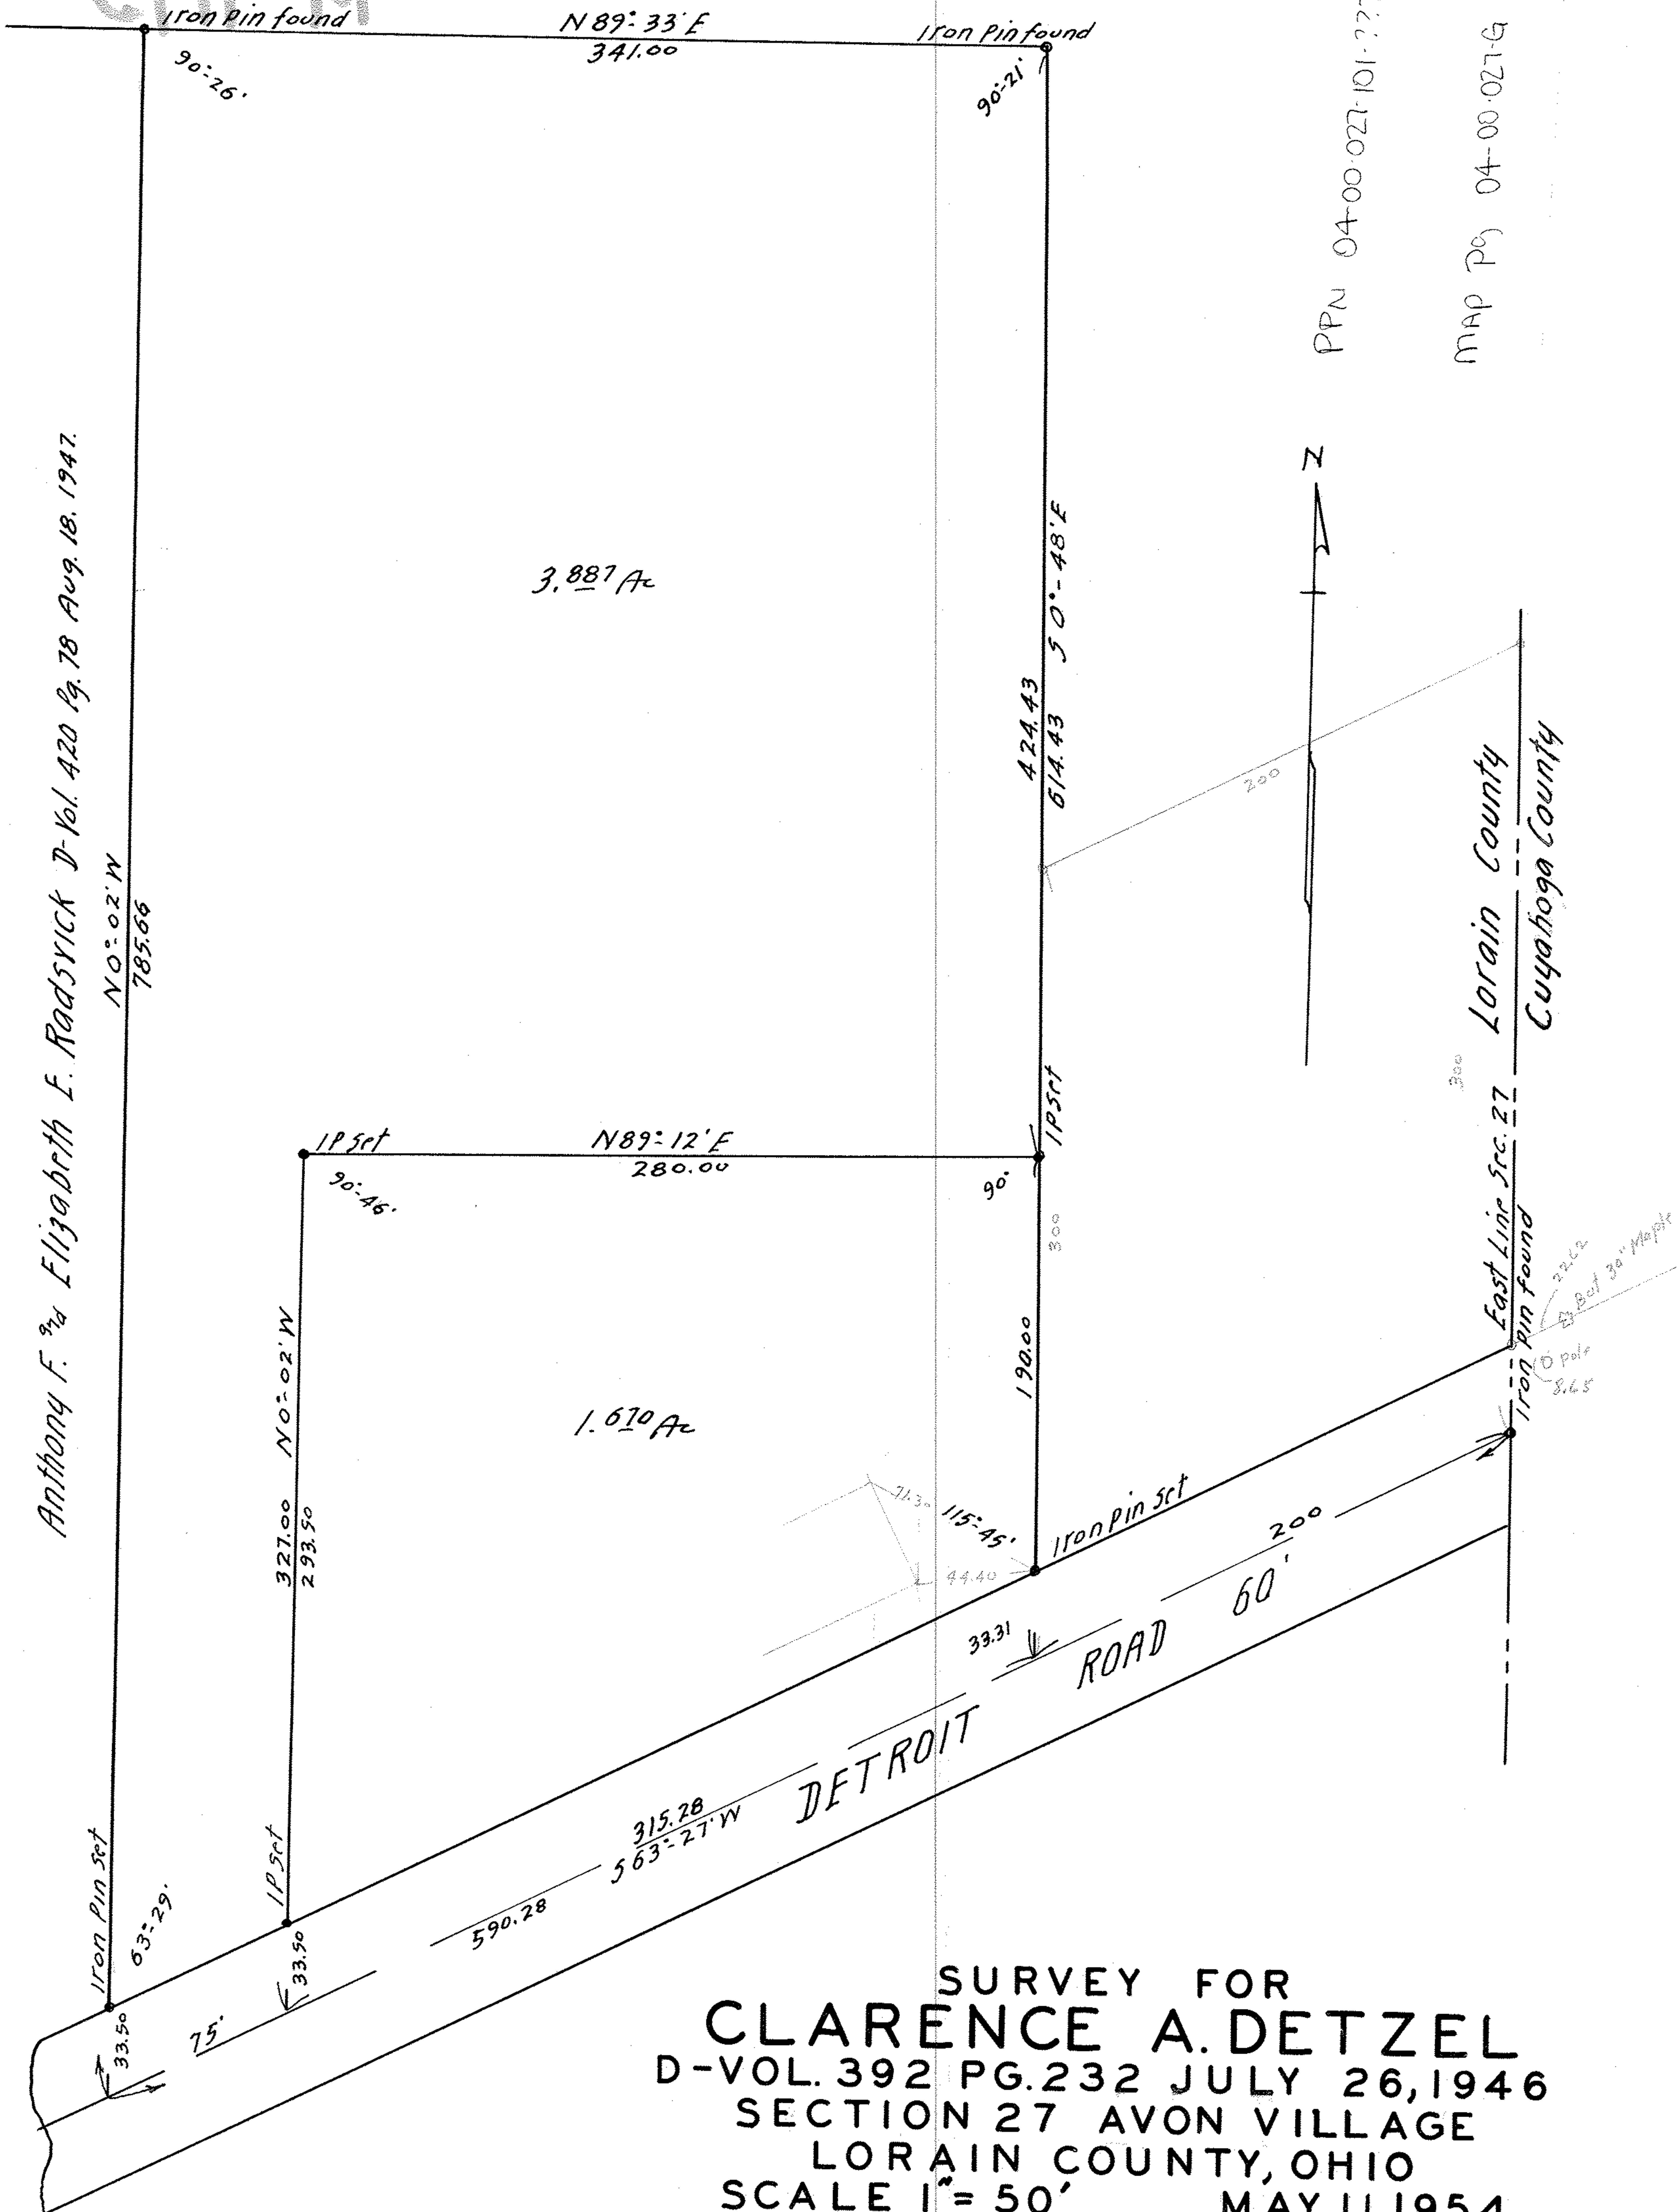

SURVEY FOR  
**CLARENCE A. DETZEL**  
 D-VOL. 392 PG. 232 JULY 26, 1946  
 SECTION 27 AVON VILLAGE  
 LORAIN COUNTY, OHIO  
 SCALE 1" = 50' MAY 11, 1954  
 J. W. WARDEN & ASSOCIATES, REG. SURVEYOR'S