14-0030

14-30

Survey for

STEEL & TUBES INC.

Original Twp., Lot 7. West of Black River, Elyria Twp.,

City of Elyria, Lorain Co., Ohio.

Scale 1 inch = 20 ft. June 3, 1931.

Warden and Laundon.
Civil Engineers.

Note: Iron Pins set at all points marked thus •.
Total acreage to North line Mussey & W. River Sts. = 2.560 Acres.
" " " " " " & E. line " " " = 2.037 Acres.

Parcel A	= 0.117	Acres
B	= 0.094	"
C	= 0.104	"
D	= 0.135	"
E	= 0.132	"
F	= 0.128	"
G	= 0.125	"
H	= 0.075	"
I	= 0.046	"
J	= 0.447	"
K	= 0.172	"
L	= 0.108	"
M	= 0.094	"
N	= 0.079	"
O	= 0.055	"
P	= 0.126	"
	2.037 Acres.	

Deed to Bernard M. O'Donnell - Nov. 29-1938
Deed Vol. 294 - Pg. 216

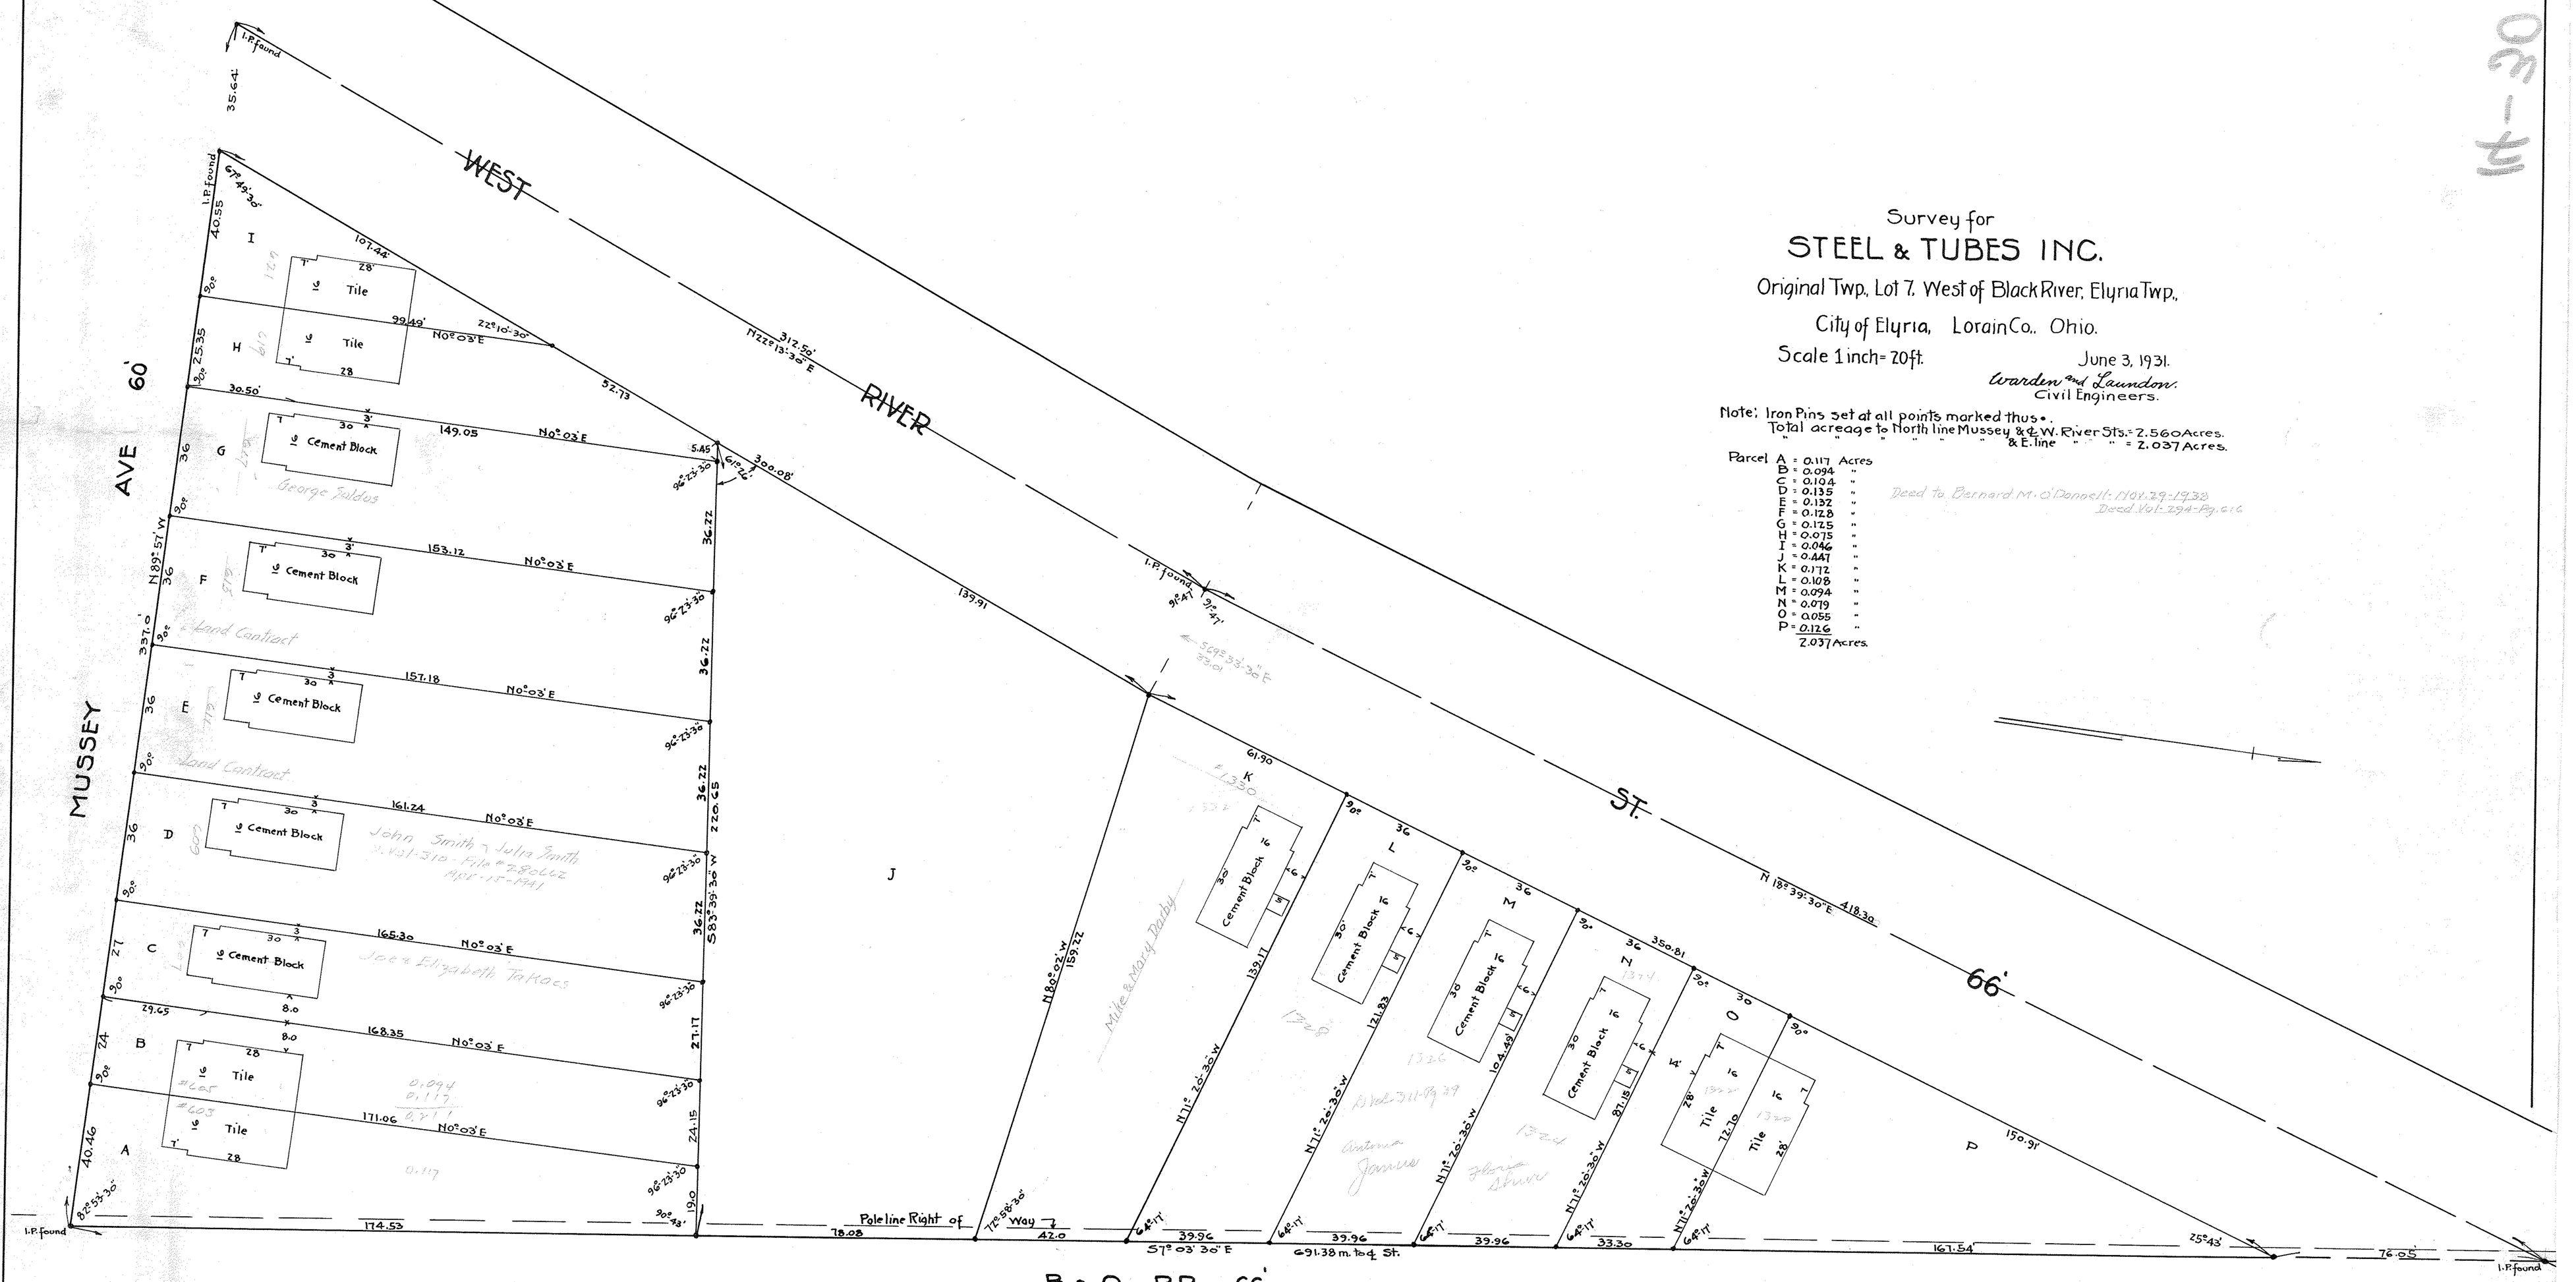

PPN 06-24-007-105 ???
06-24-007-106 ???

MAP PG 6-135

2366