

Barbara Long et al. - fmly. John & Frances Long
D. Vol. 56 - Pg. 338 - May 28 1883.

Joseph J. & Christine Gerhart
D. Vol. 325 - Pg. 19 - June 28 1941

O.W. & Myrtle Uebbing
D. Vol. 300 - Pg. 448 - Aug 1 1939.

George H. & Marian Garrett
D. Vol. 364 - Pg. 322 - June 11 1945.


Sec. 12 - 10 478 Ac.
Total 13 457 Ac. to center of road.

Anna Stockard
D. Vol. 343 - Pg. 237
June 6 1945.

Frank Leshar
formerly to Joseph Coonrady
D. Vol. 50 - Pg. 227 Jan. 10 1882.

Survey for
Tom Hricovic
Sec. 11-12 - Avon Twp.
now Avon Village - Lorain Co. O.
Nov. 22 1946 - Scale 1" = 100'
J.W. Warden - Reg. Surveyor.

14 095

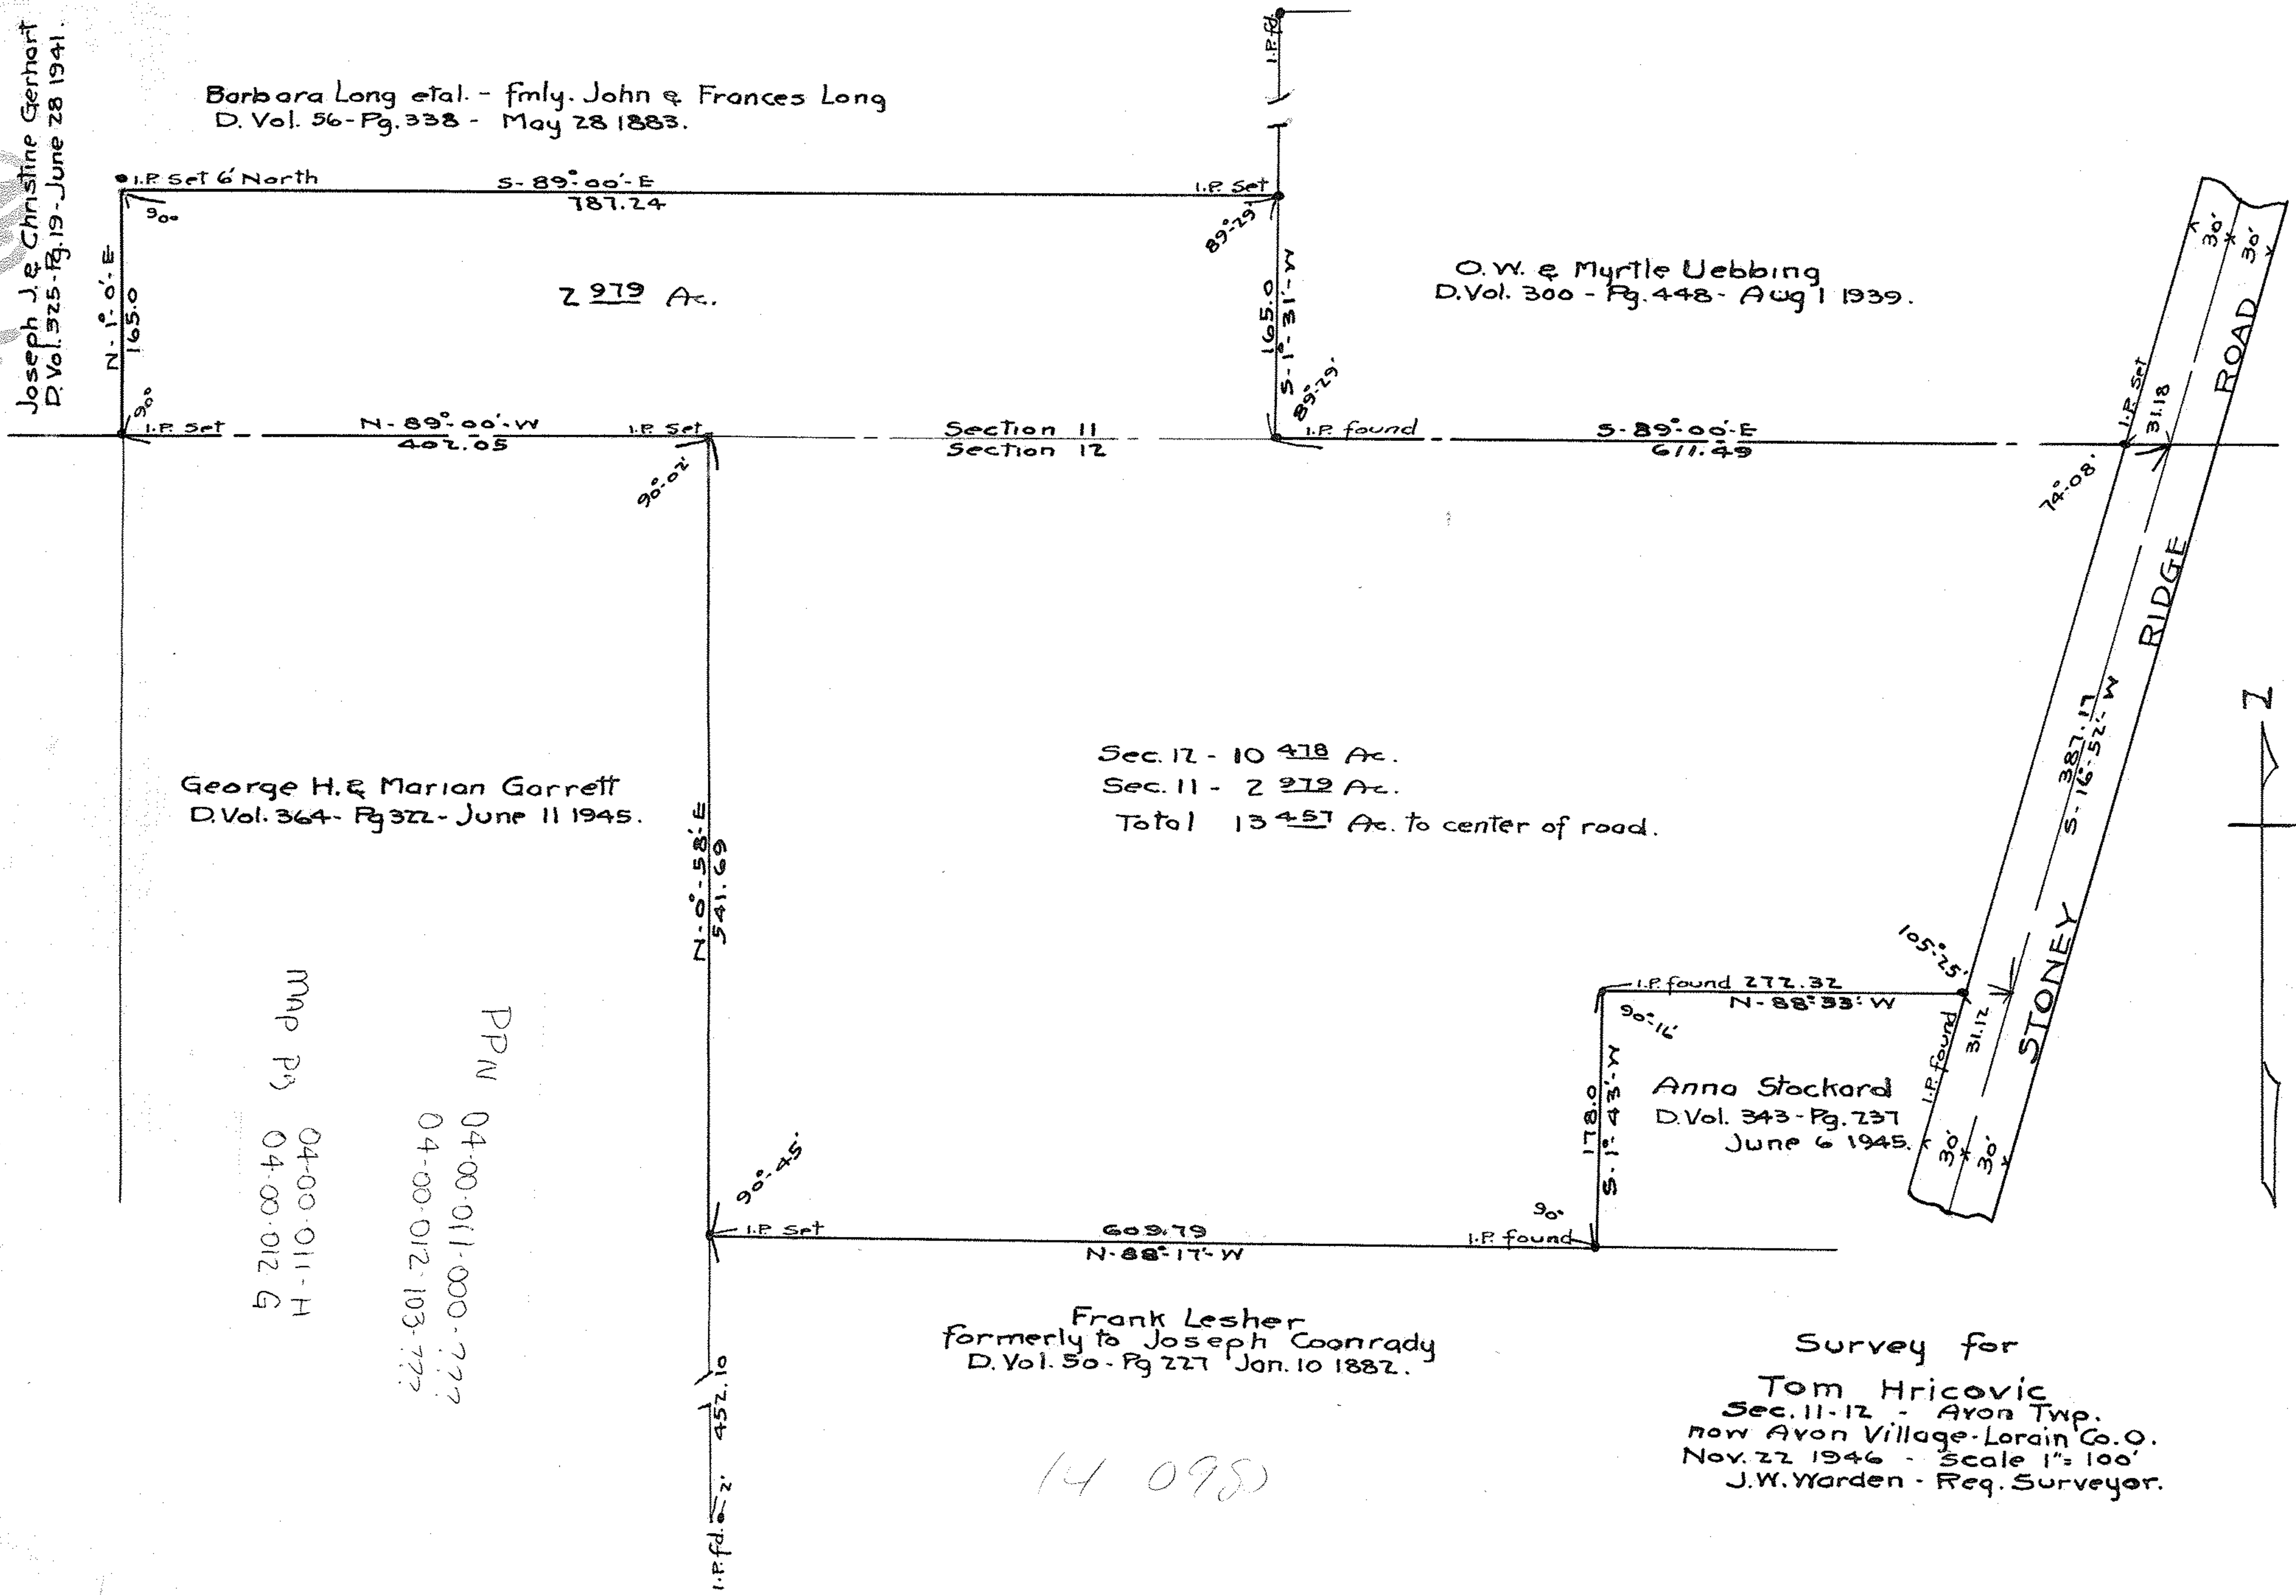

Map P's 04-00-011-H
04-00-012-G

PPN 04-00-011-000-777
04-00-012-103-777

14-095