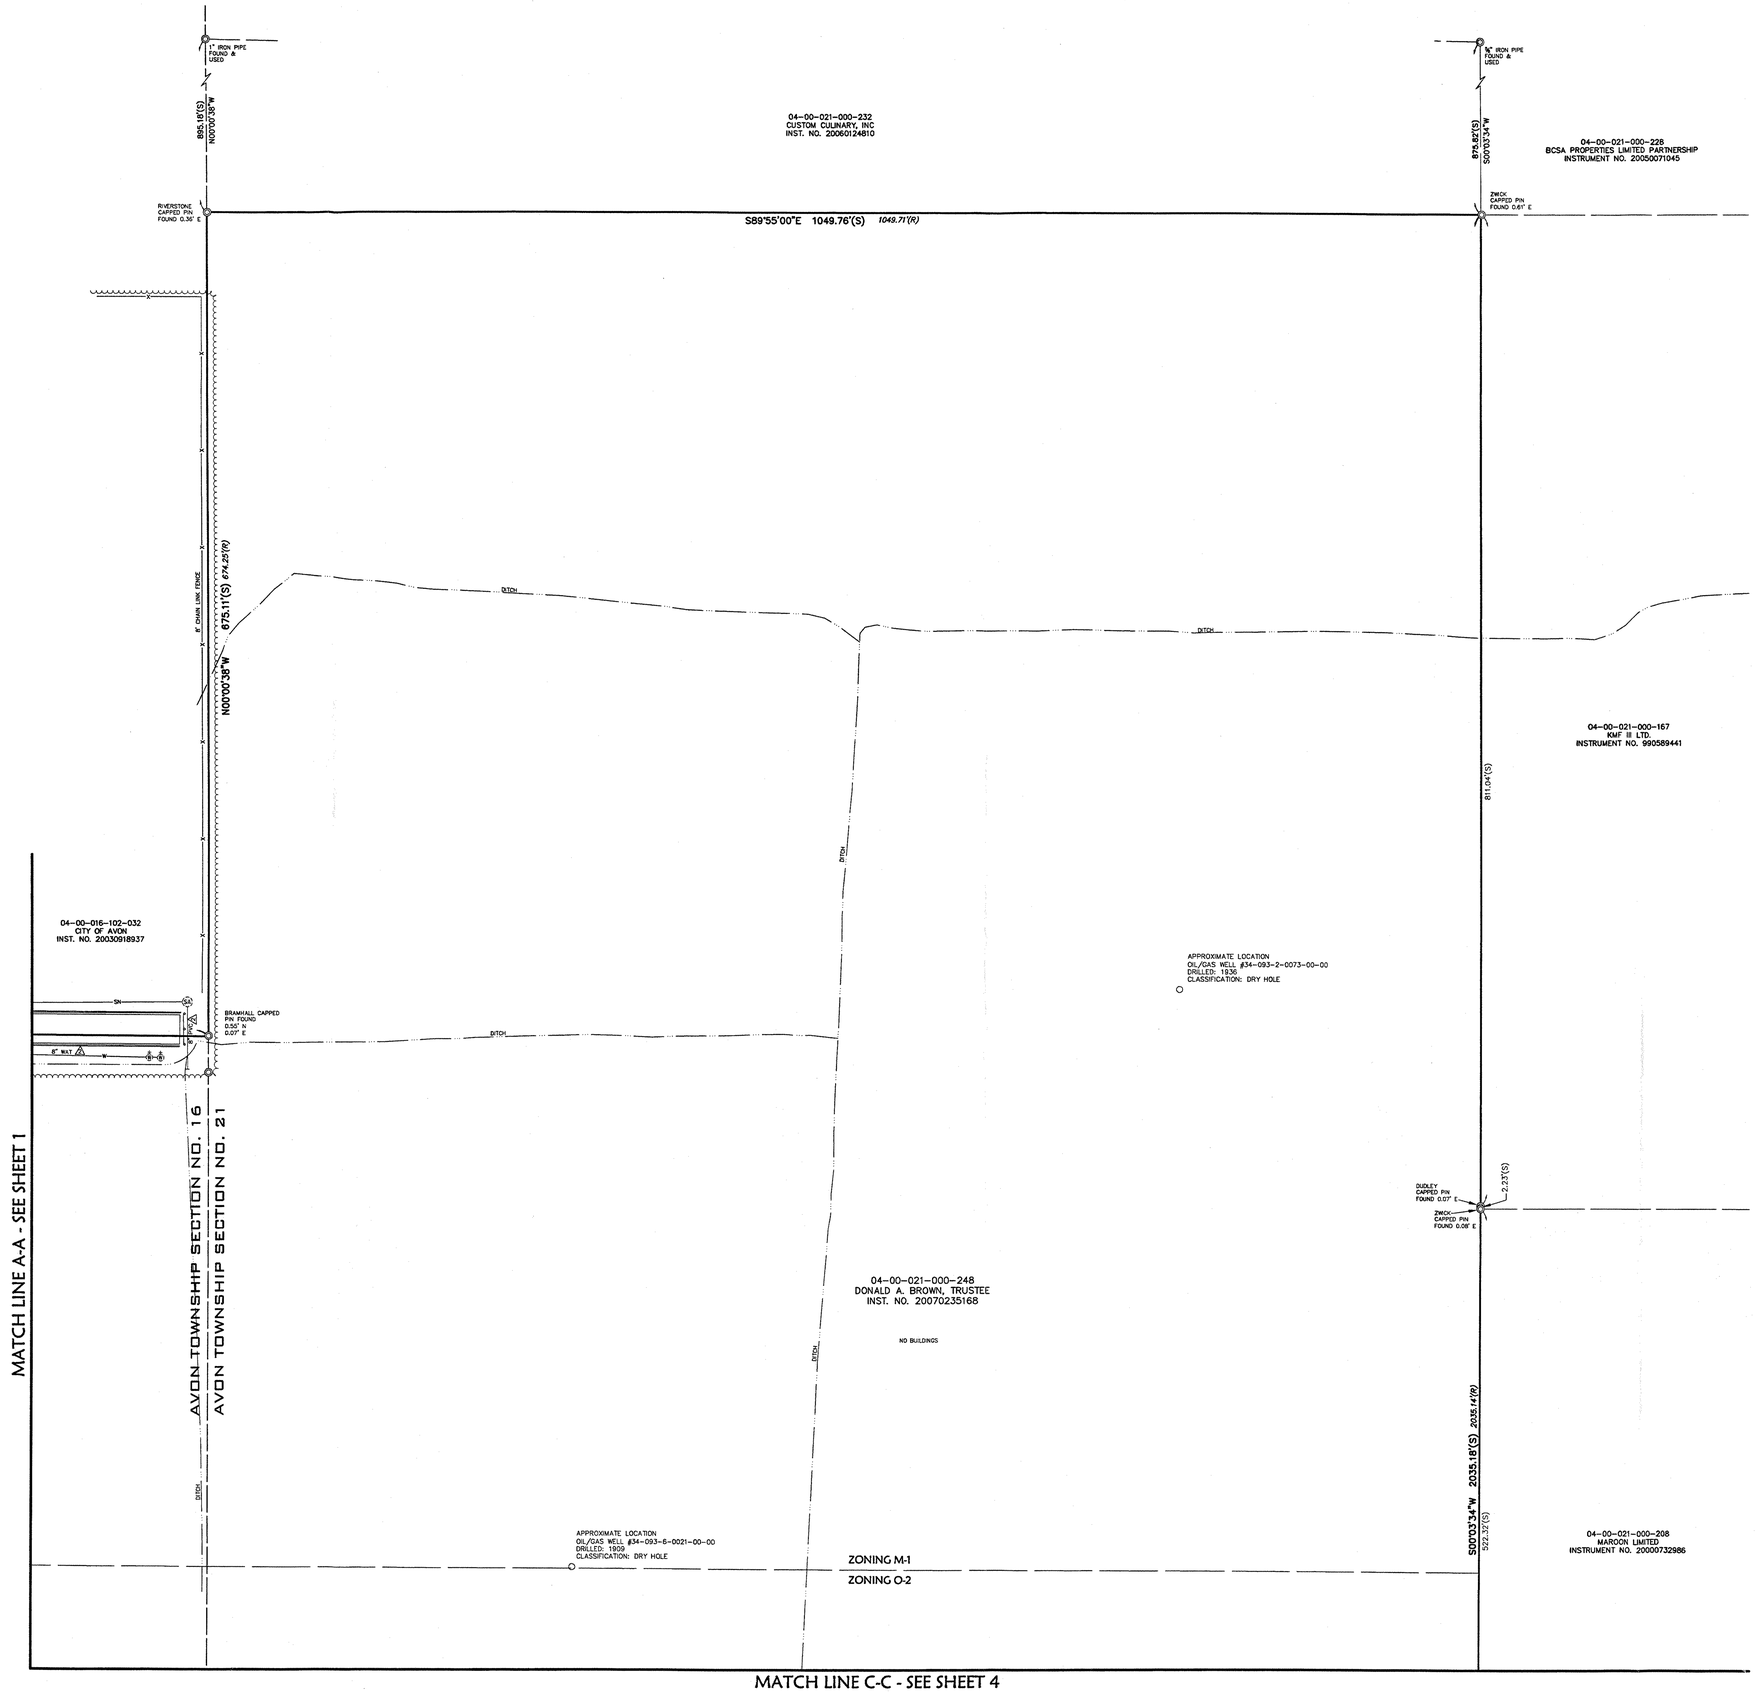

REVISIONS			
	DATE	DESCRIPTION	BY

DATE: 6-09-08
DRAWN BY: ABR
CH'D BY: 7245
DWG. NAME: C-ALTA02
PATH: 08075
F.B. 805

KS Associates, Inc.
260 Burns Road, Suite 100
Elyria OH 44035
P 440 365 4730
F 440 365 4790
www.ksassociates.com
KS ASSOCIATES

ALTA/ACSM LAND TITLE SURVEY

OF PART OF
ORIGINAL AVON TOWNSHIP SECTION NOs 16 & 21
CITY OF AVON, COUNTY OF LORAIN, STATE OF OHIO

SHEET 2 OF 4

JOB NO. 08075-01