


Survey for
 Georgia K. Wood Estate.
 Section 18, Avon Lake Village,
 formerly Avon Township, Lorain Co., O.
 June 25, 1943. Scale 1"=50'.
 J. W. Warden - Registered Surveyor.

The Cleveland Trust Co.
 P.C. #2 - D. Vol- 237 - Pg-383 - May 15, 1928.

Carlisle J. P. & Elsie D. Simmons
 D. Vol- 326 - Pg. 206 - Nov. 30 - 1942.

Village of Avon Lake - D. Vol- 306 - Pg. 532 - Sept. 14 - 1940

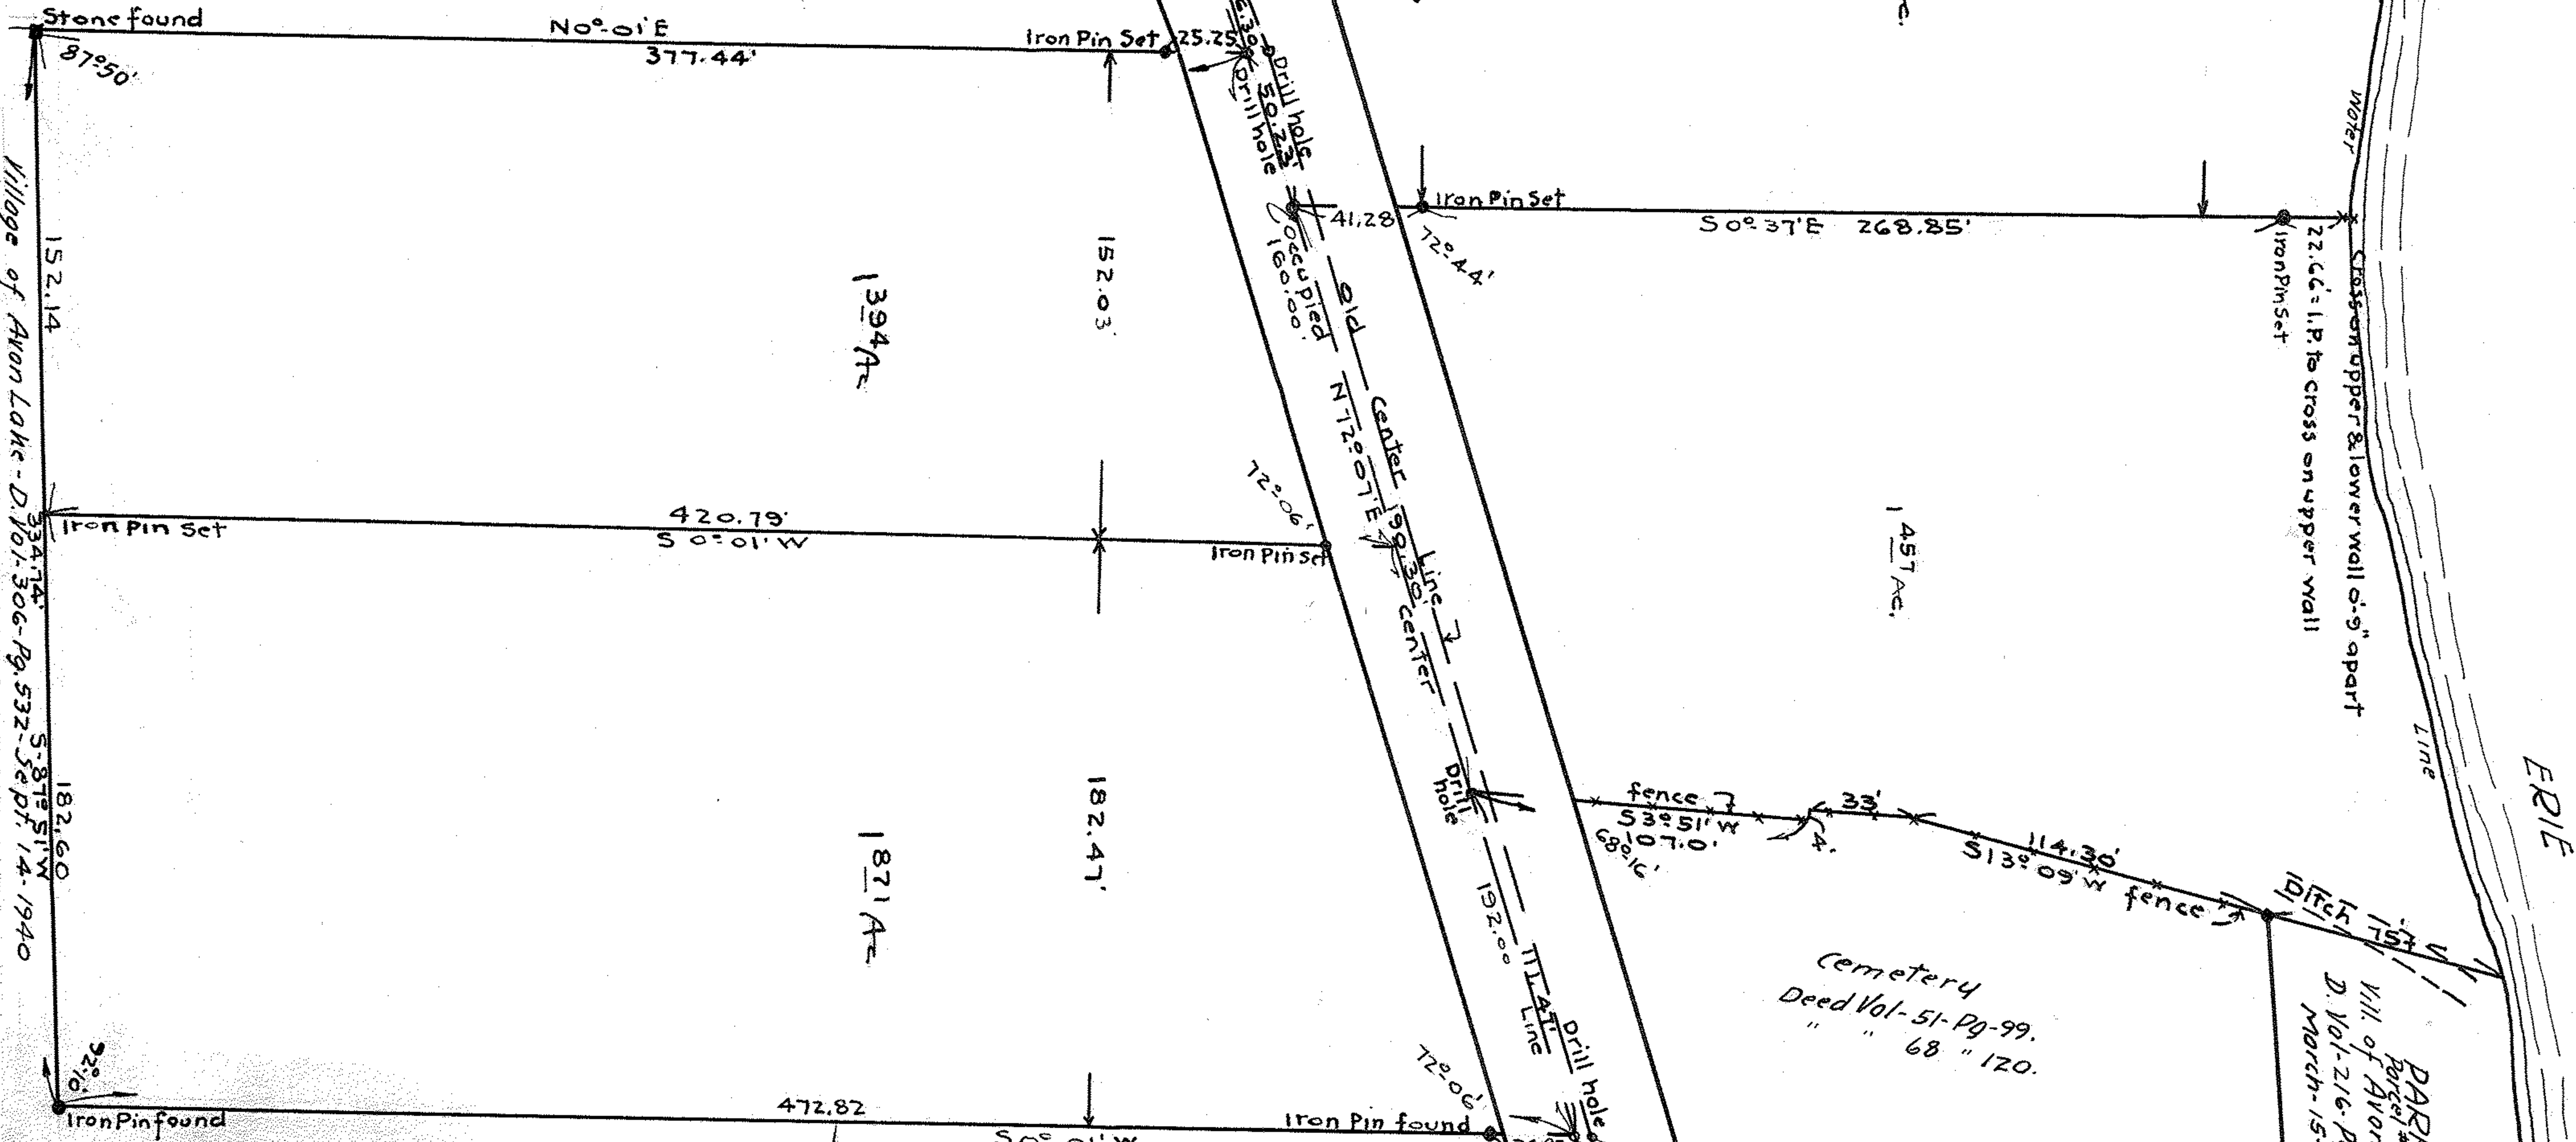

Village of Avon Lake
 D. Vol- 306 - Pg-532 - Sept-14-1940

Village of Avon Lake
 D. Vol- 216 - Pg-637 - March-15-1926
 P.C. #2.

Cemetery
 Deed Vol- 51 - Pg-99.
 " " 68 " 120.

PARK #1
 Vill. of Avon Lake
 D. Vol- 216 - Pg-637.
 March-15-1926.

10/0401 A