PPN 04-00-001-101-???

MAP PG 04-00-001-B

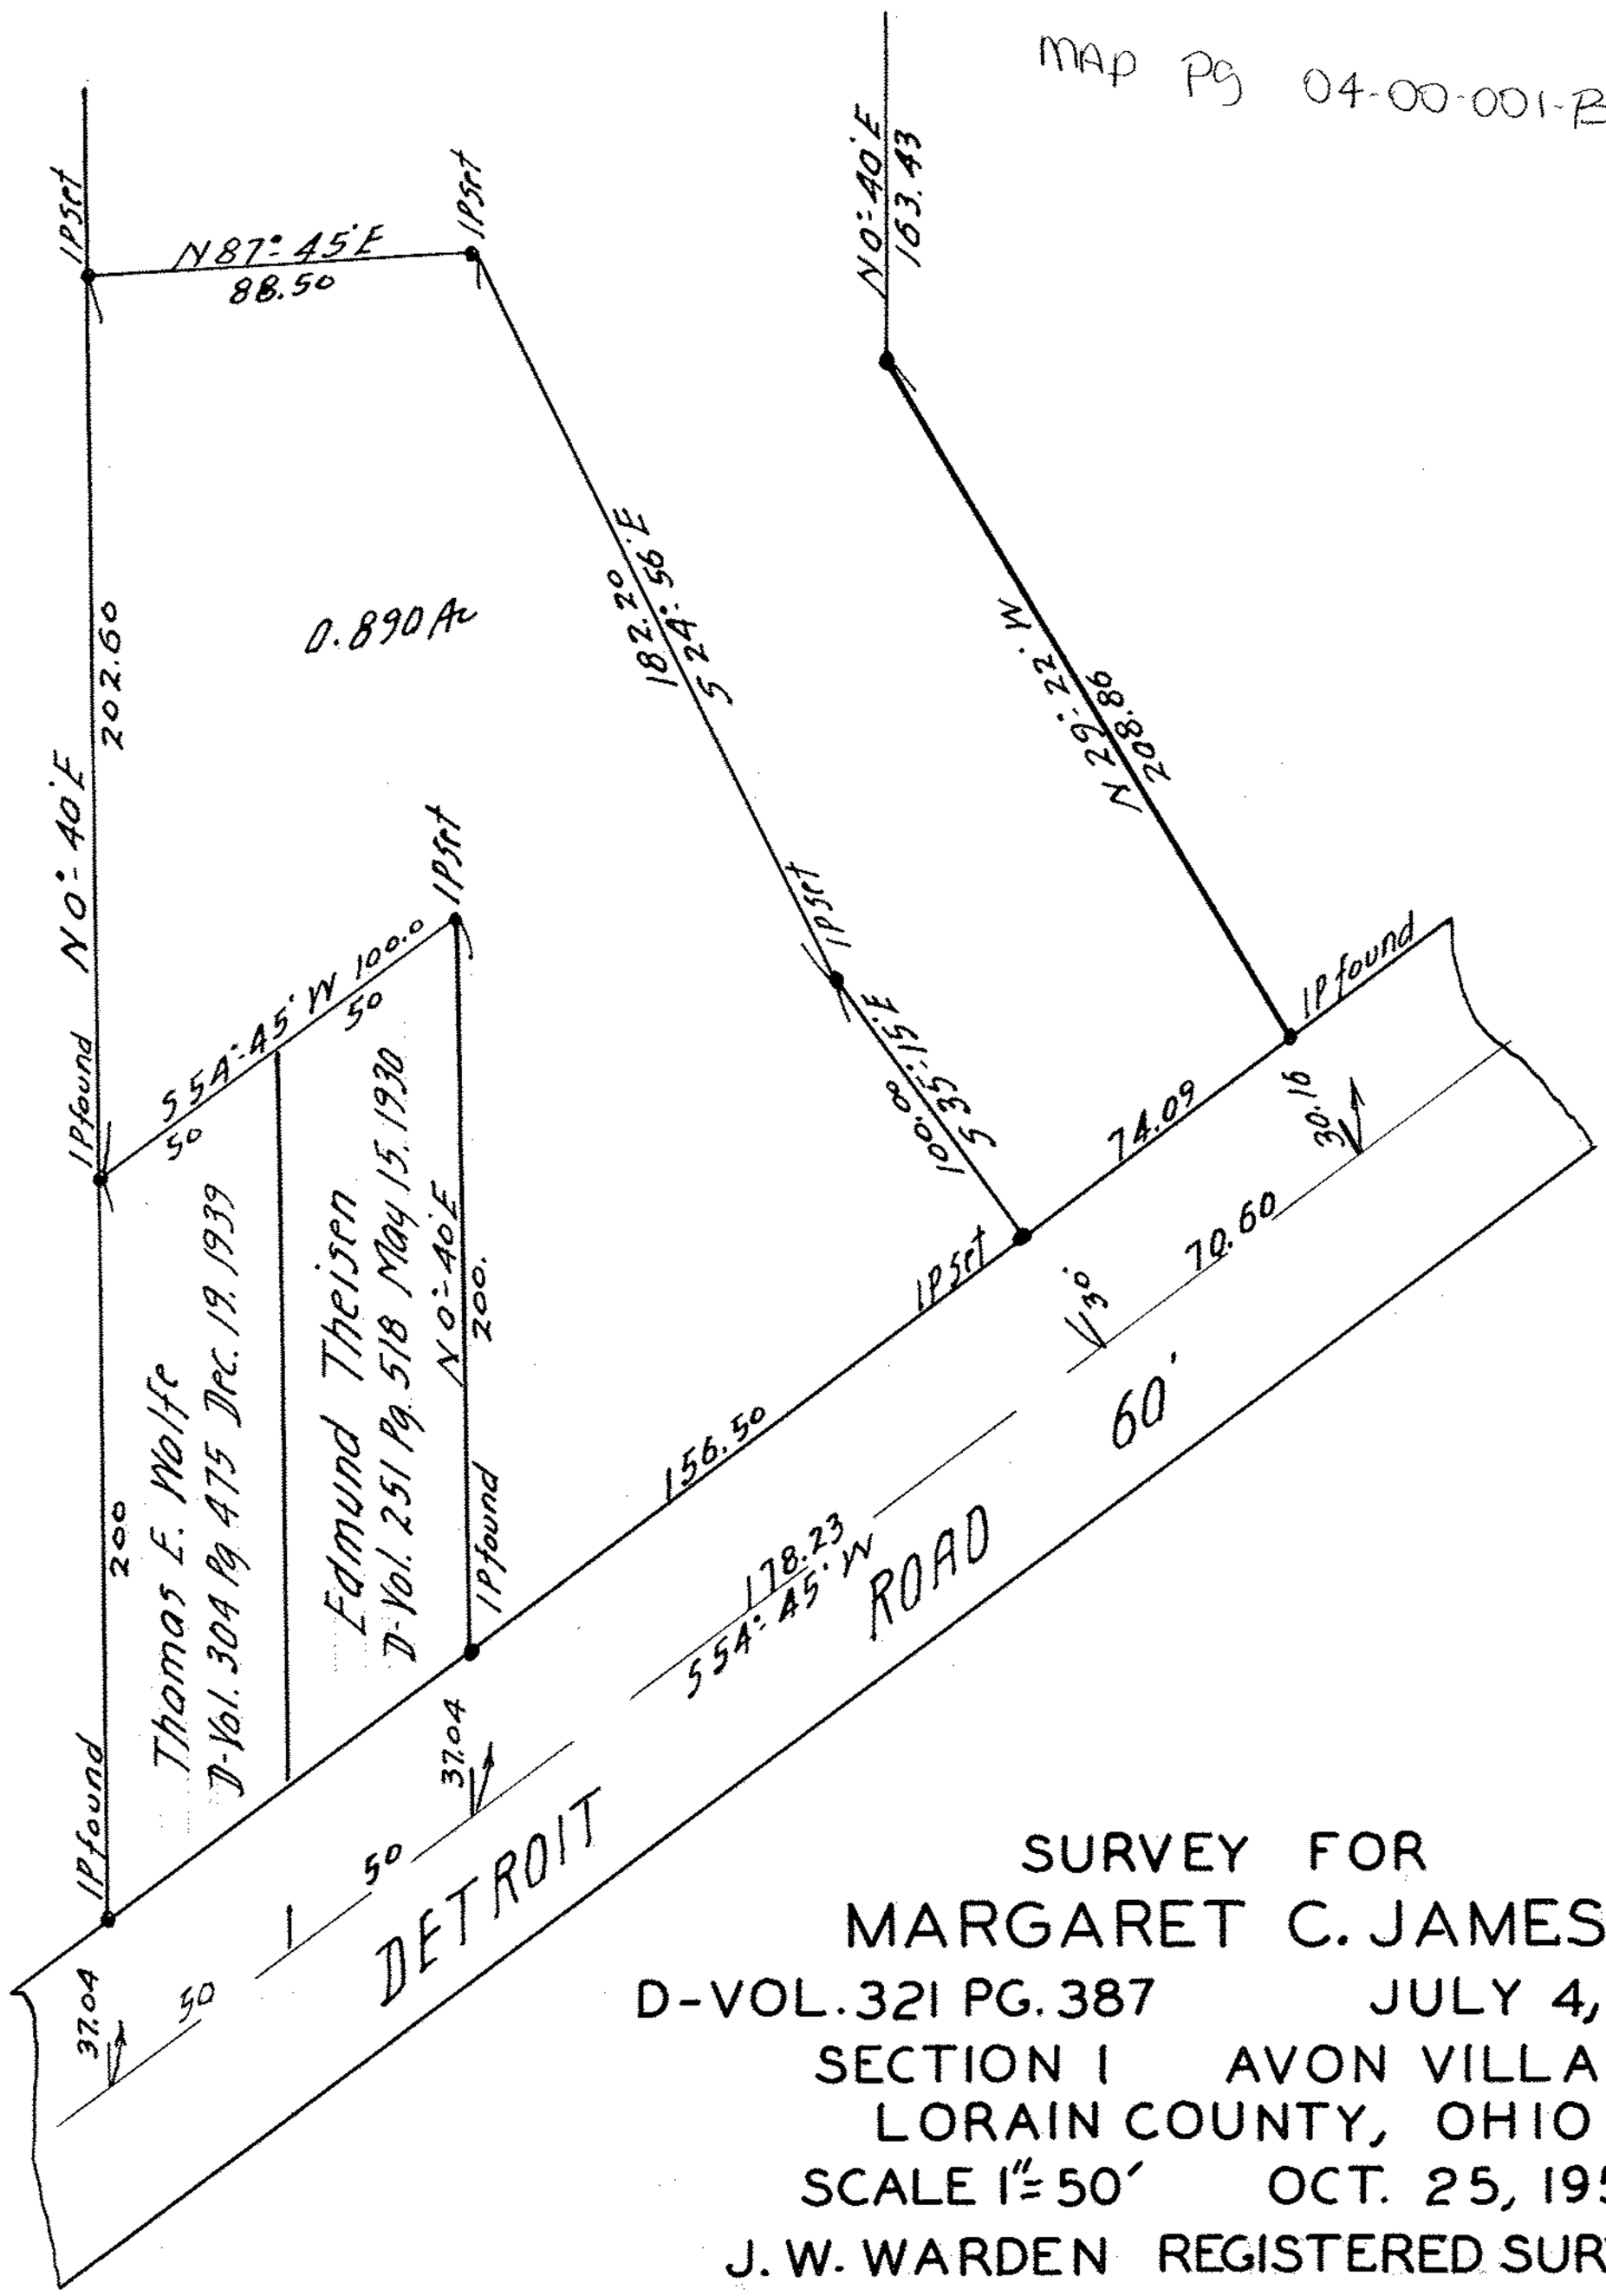

SURVEY FOR
MARGARET C. JAMES
D-VOL. 321 PG. 387 JULY 4, 1942
SECTION 1 AVON VILLAGE
LORAIN COUNTY, OHIO
SCALE 1"=50' OCT. 25, 1950
J. W. WARDEN REGISTERED SURVEYOR