J-15 R

SURVEY FOR
ROBERT MULLER

BLOCK I LOTS 24-25
AVON DOVER BEACH SUBN.
MAP VOL. II PAGE 27
SEC. 30 AVON LAKE VILLAGE
LORAIN COUNTY, OHIO
SCALE 1"= 10' MAY 7, 1955
J. W. WARDEN AND ASSOCIATES
REGISTERED SURVEYORS
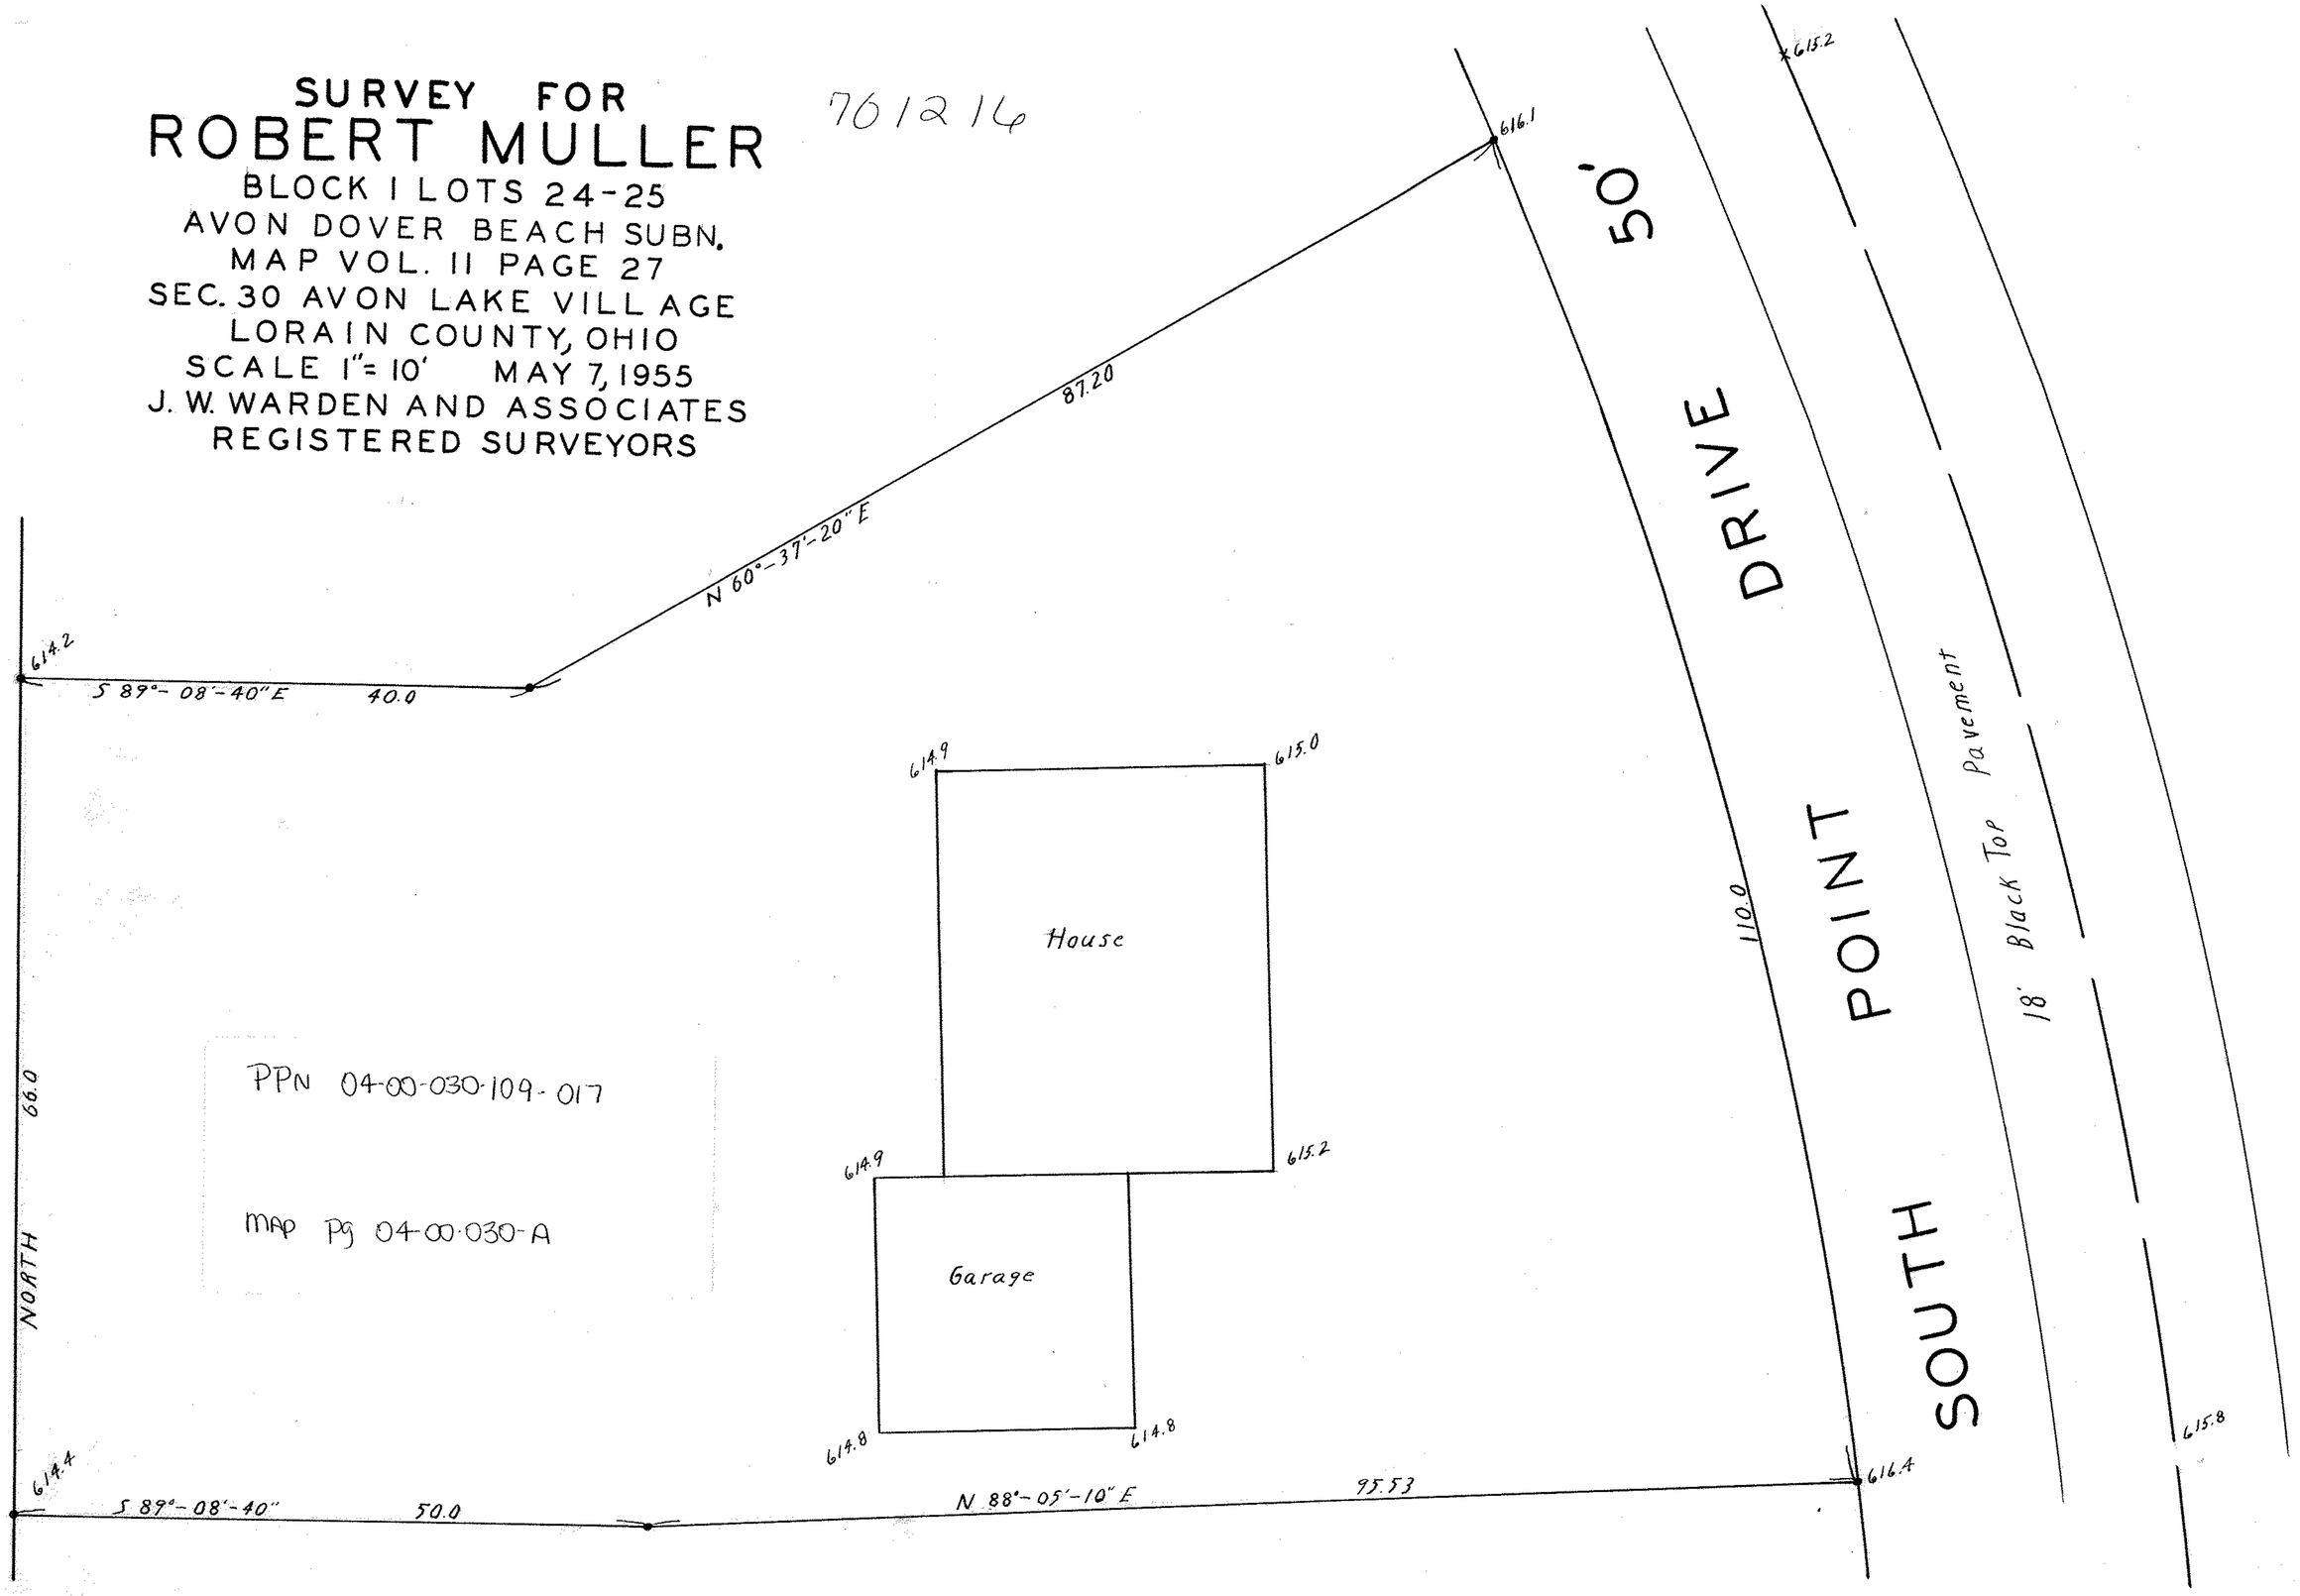
701216