
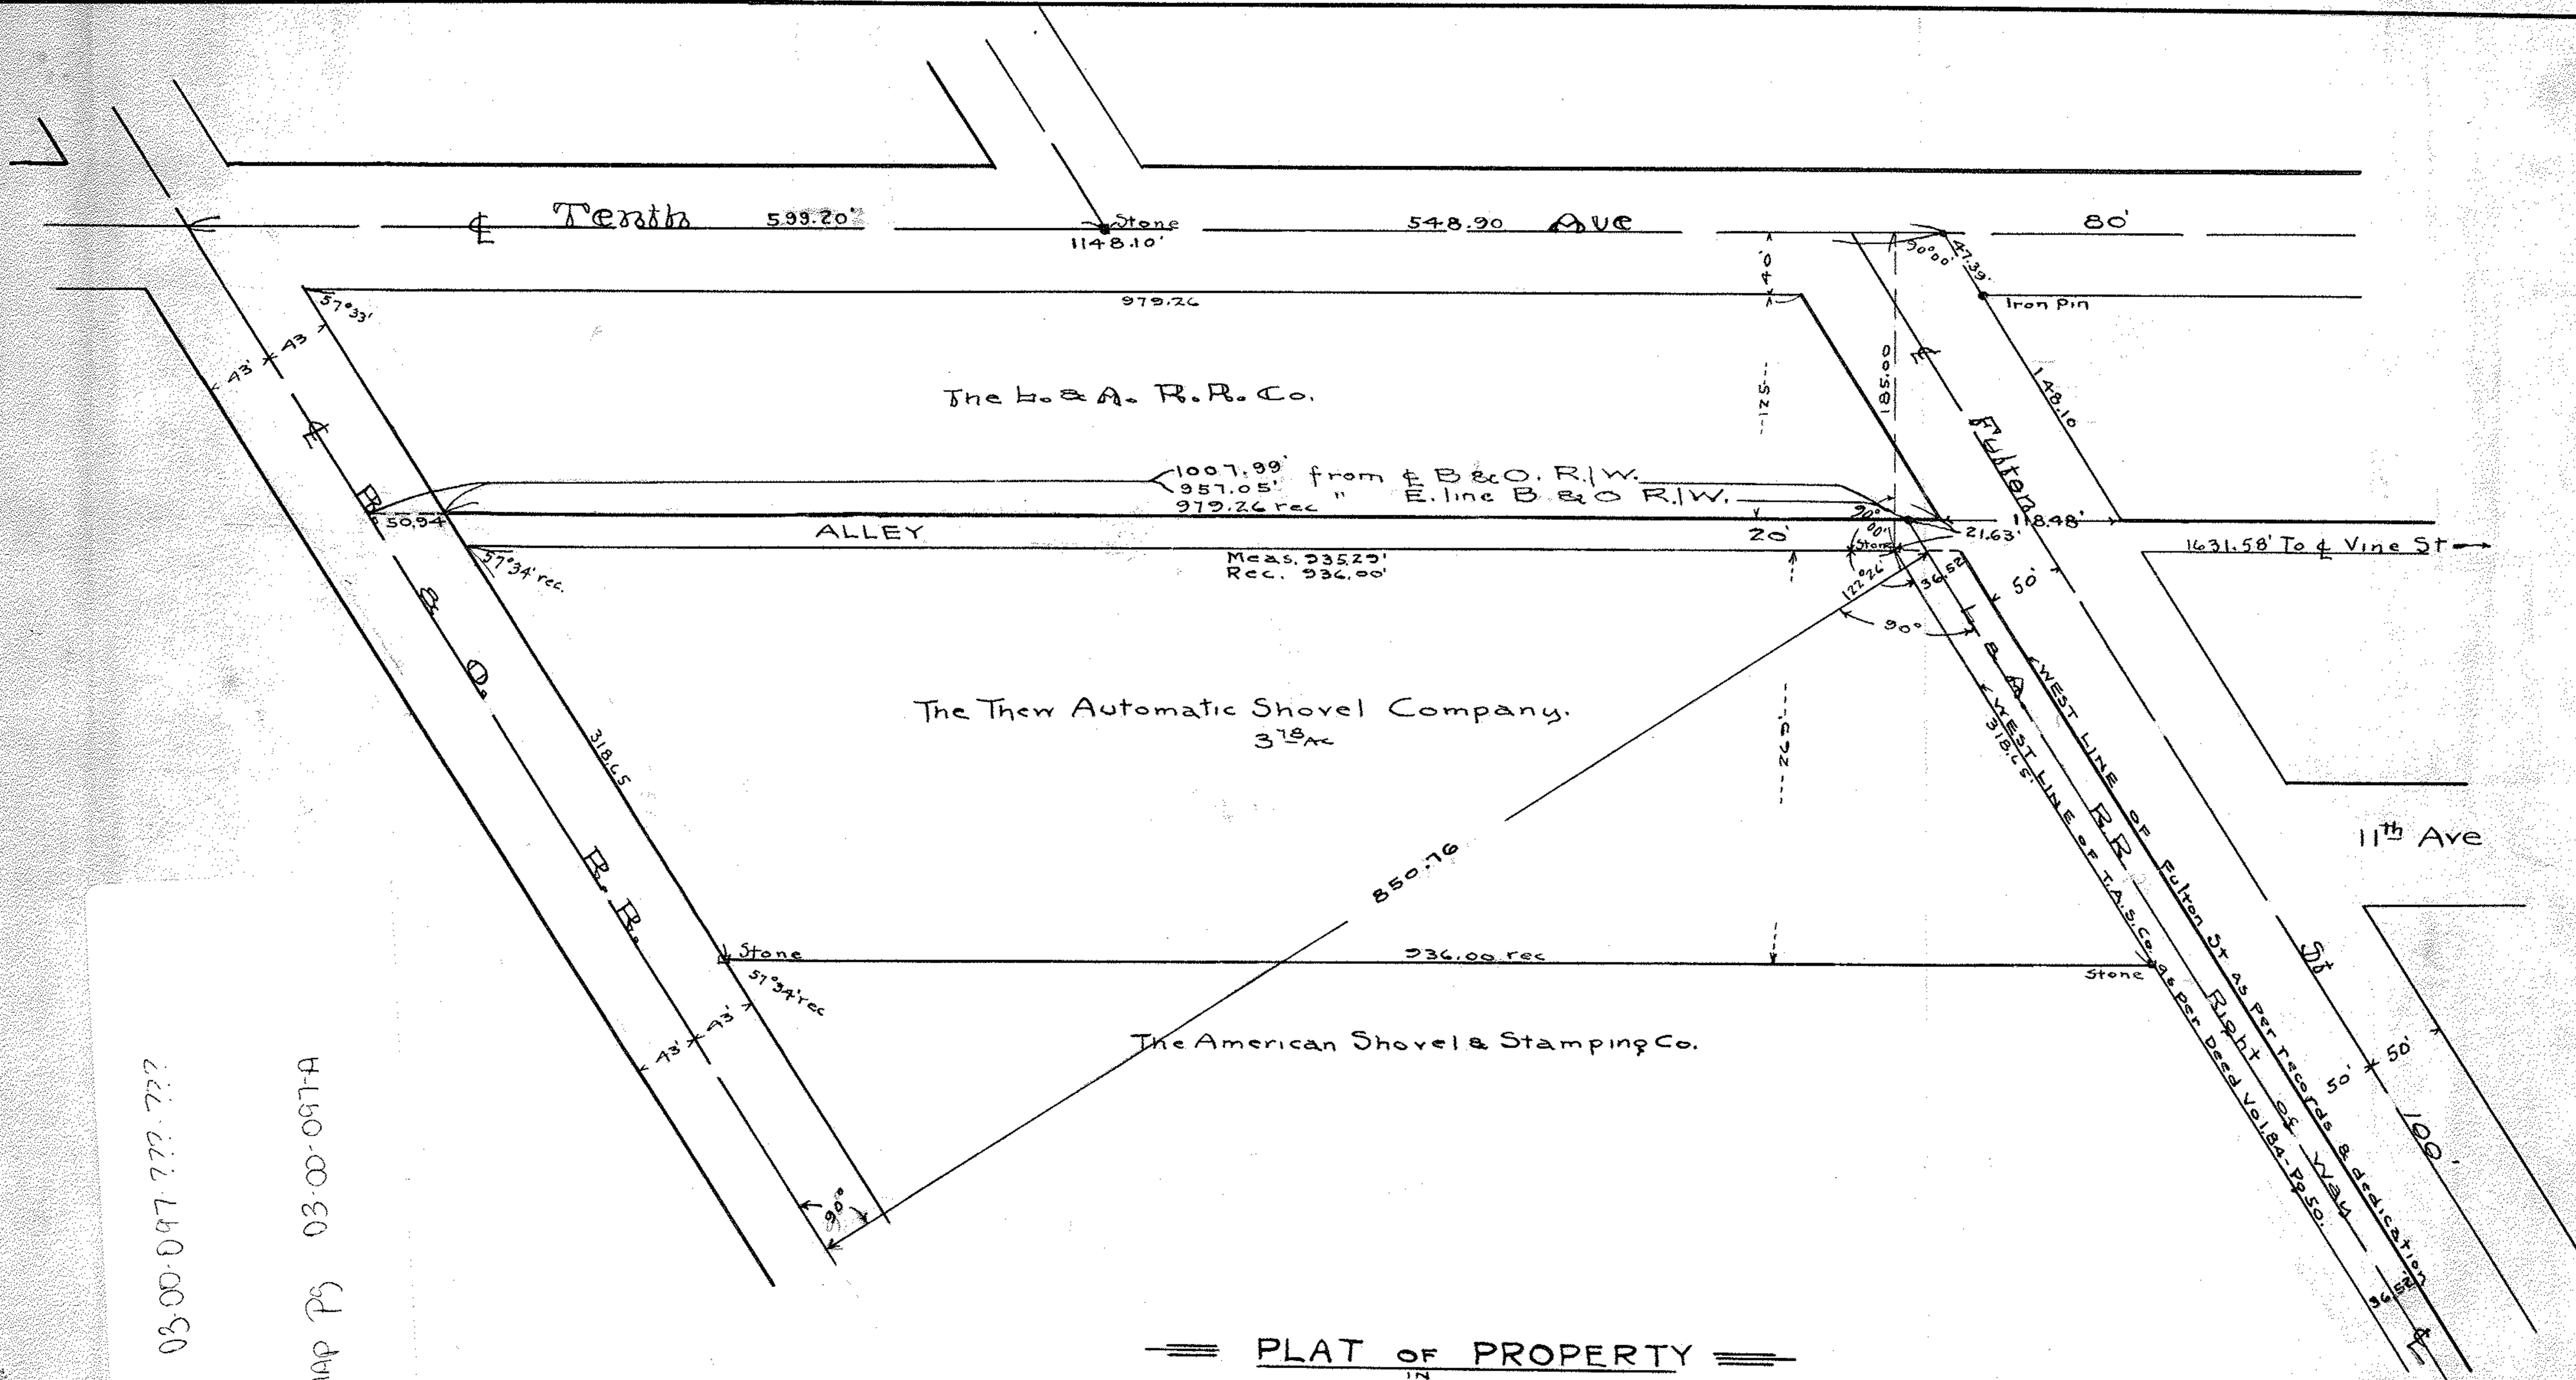


10-0698

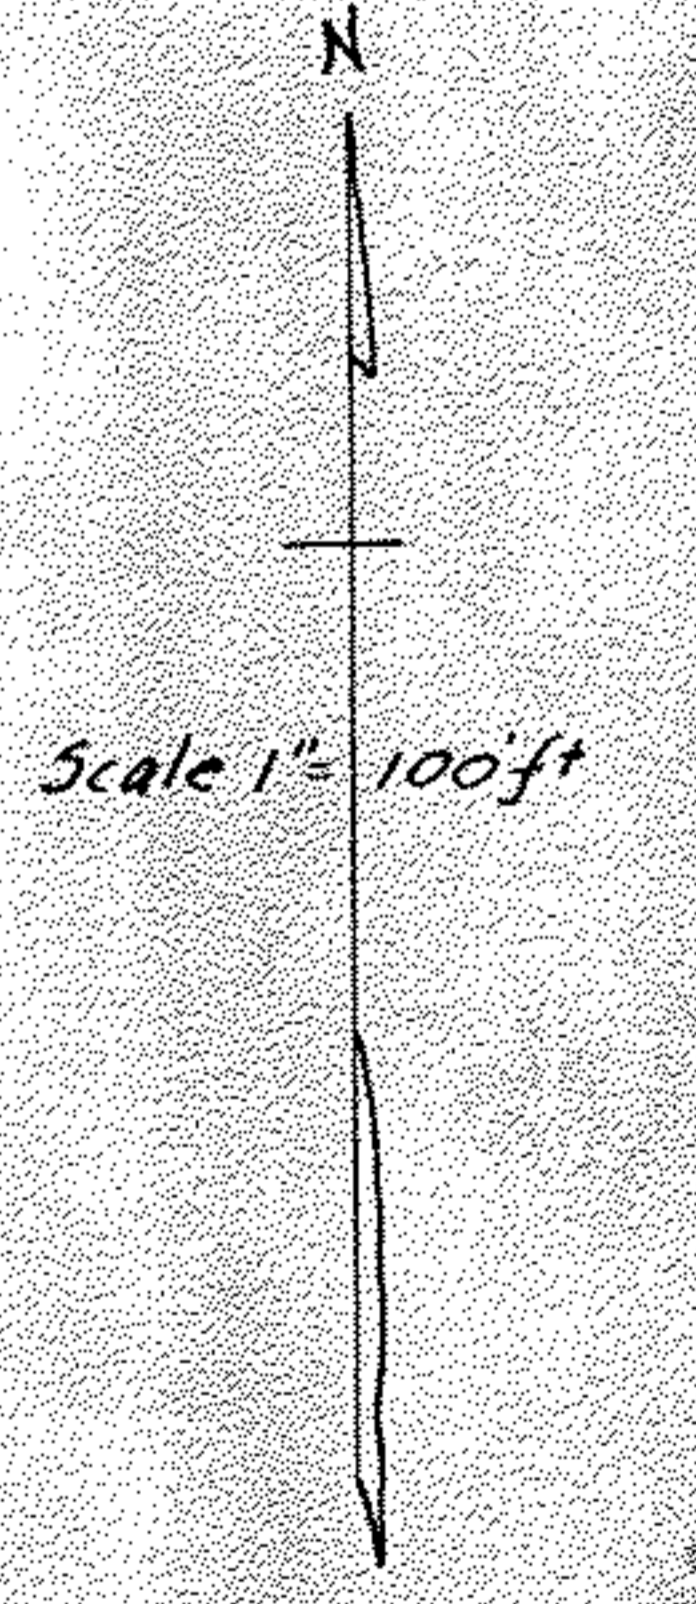

PPN 03-00-097 777-777

MAP P3 03-00-097-A

PLAT OF PROPERTY

Original Lots #97-98  
CITY OF LORAIN - LORAIN Co. OHIO. Sheffield Twp.

Compiled from records & surveys - OCT. 23 - 1905.

10-525