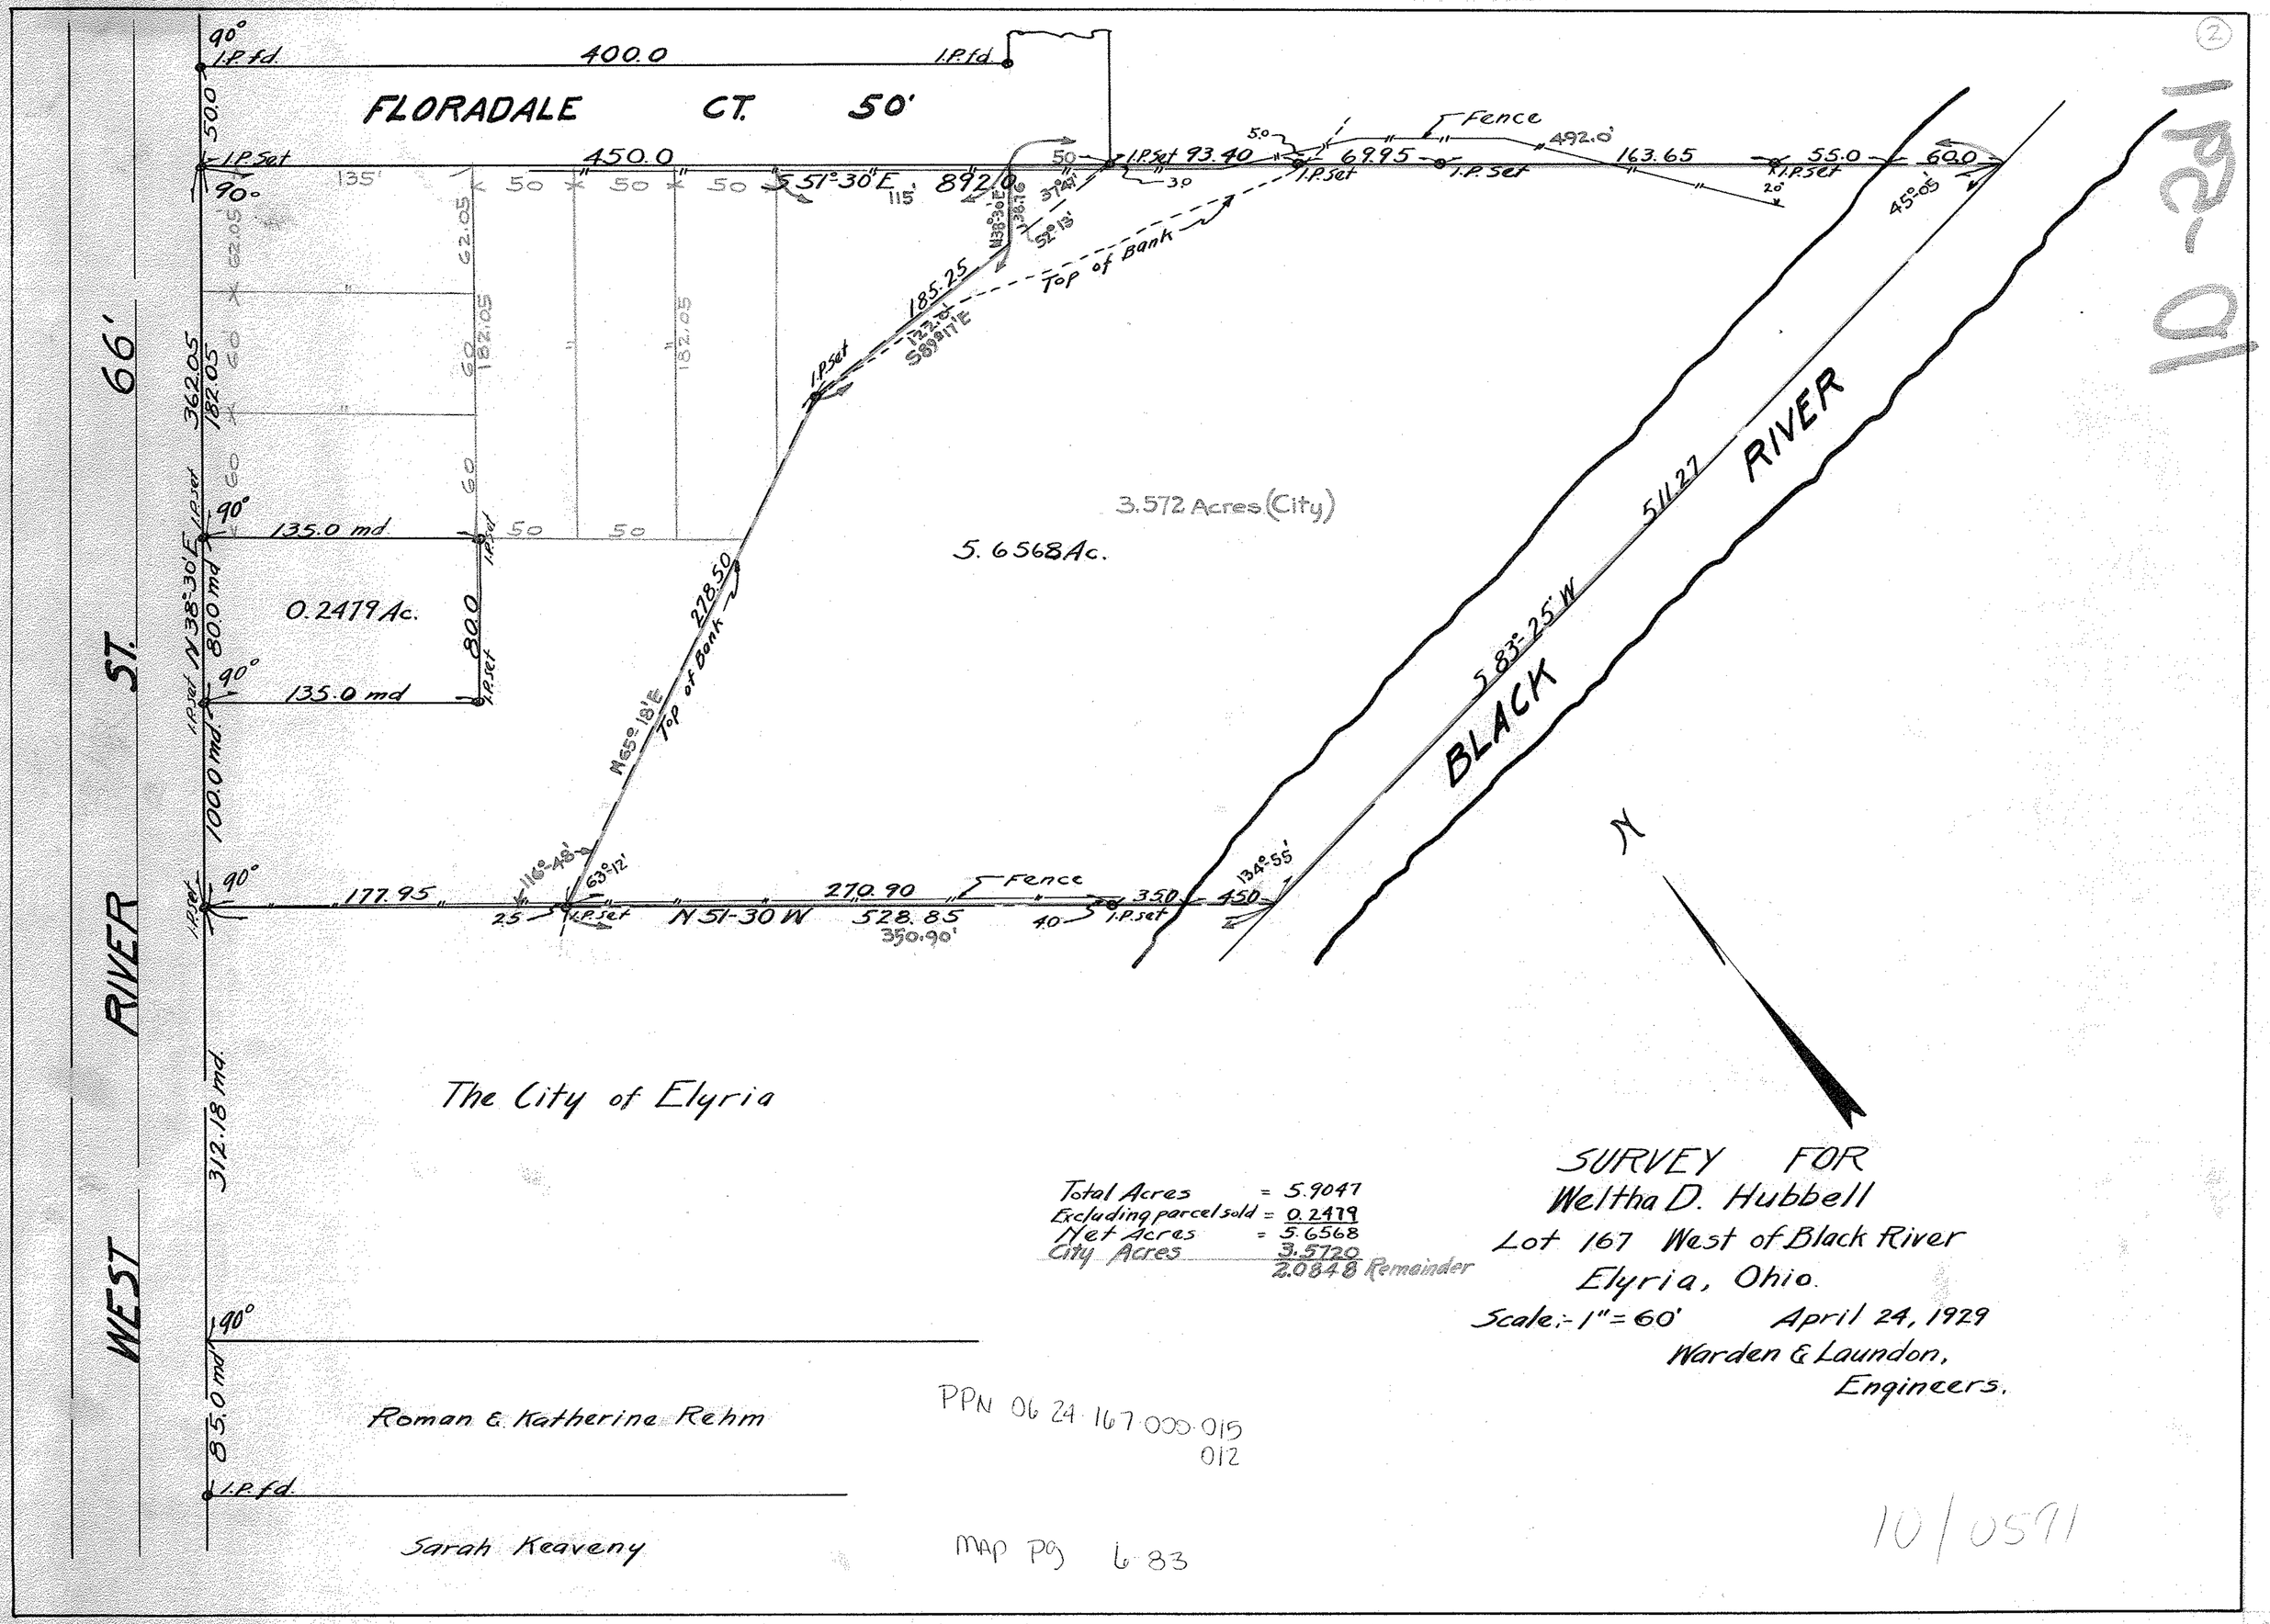

FLORADALE CT. 50'
WEST RIVER ST. 66'
BLACK RIVER
3.572 Acres (City)
5.6568 Ac.
0.2479 Ac.
The City of Elyria
Roman & Katherine Rehm
Sarah Keaveny
Fence
Top of Bank
N 51-30 W
S 83°-25' W
511.27
Total Acres = 5.9047
Excluding parcel sold = 0.2479
Net Acres = 5.6568
City Acres 3.5720
2.0848 Remainder
SURVEY FOR
Weltha D. Hubbell
Lot 167 West of Black River
Elyria, Ohio.
Scale:- 1" = 60'
April 24, 1929
Warden & Laundon,
Engineers.
PPN 06 24 167 000 015
012
MAP Pg 6 83
10/0591