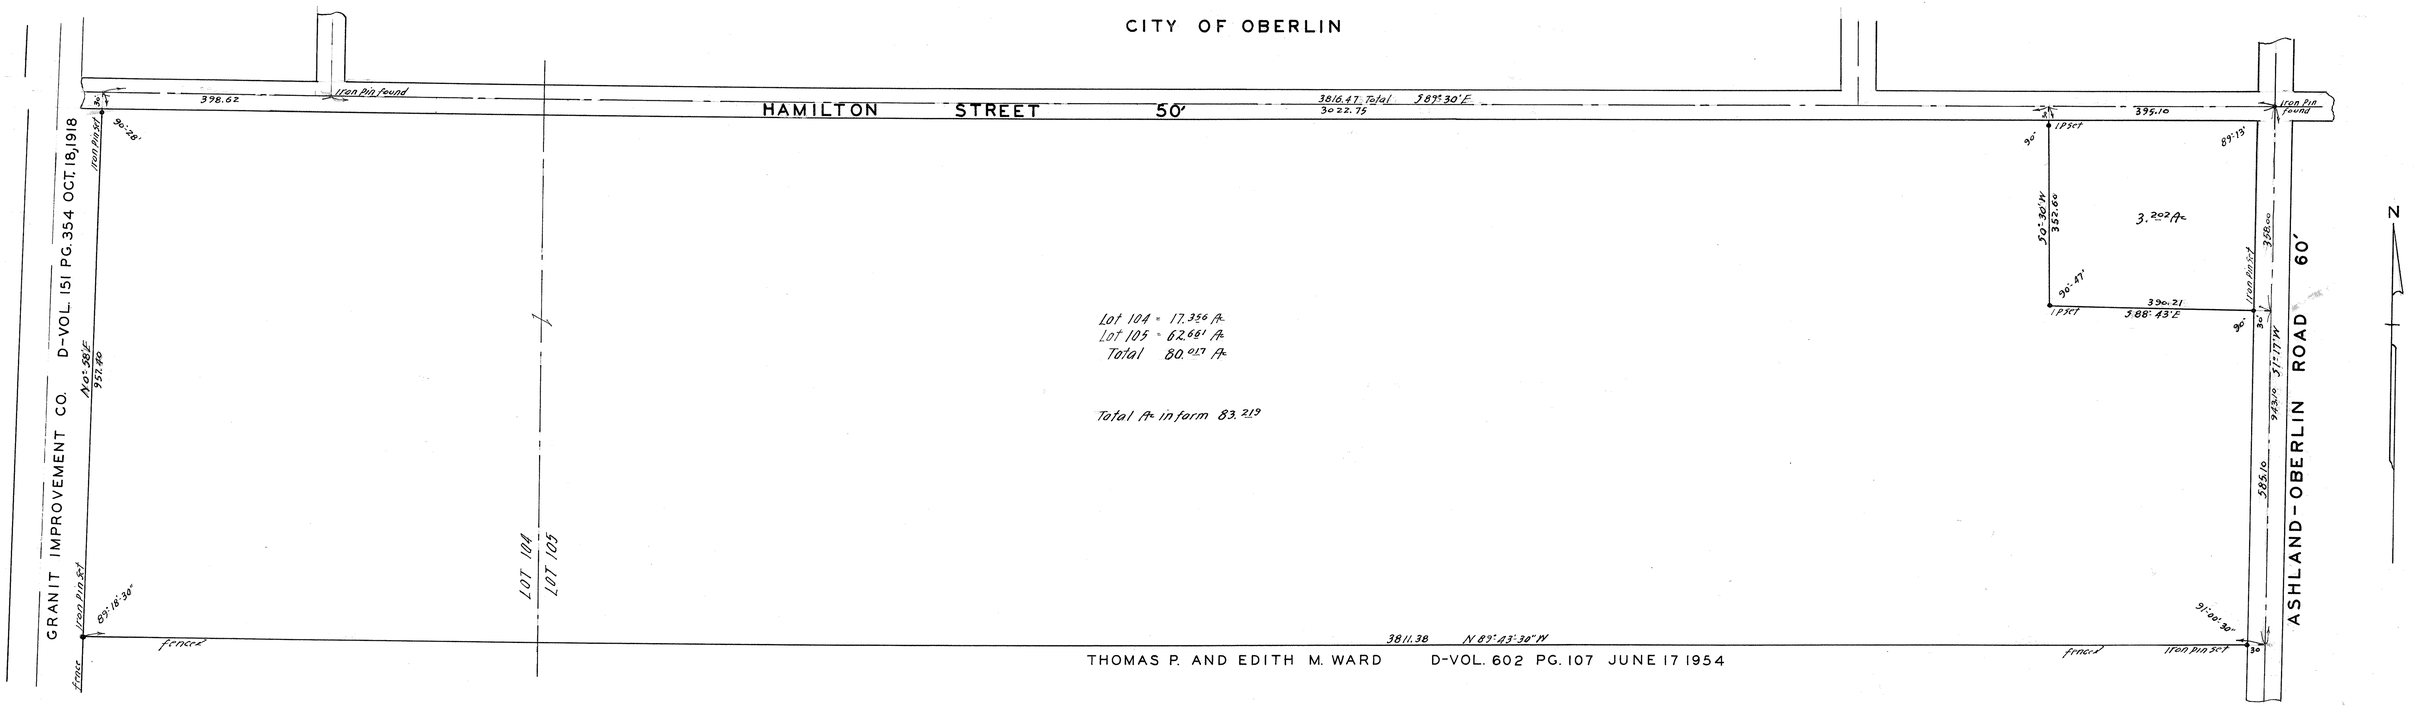

SURVEY FOR

ANDREW R. AND CLARA M. JOHNSTON

ORIGINAL LOTS 104-105 RUSSIA TOWNSHIP
LORAIN COUNTY, OHIO
D-VOL. 303 PG. 273 NOV. 28, 1939
SCALE 1" = 100' MARCH 22, 1956
J. W. WARDEN AND ASSOCIATES REG. SURVEYORS

11-00-063 000-002
007

11-00-062-

MAP PG 11-F South 11-00062-A,B