


10-1270

10-15-10

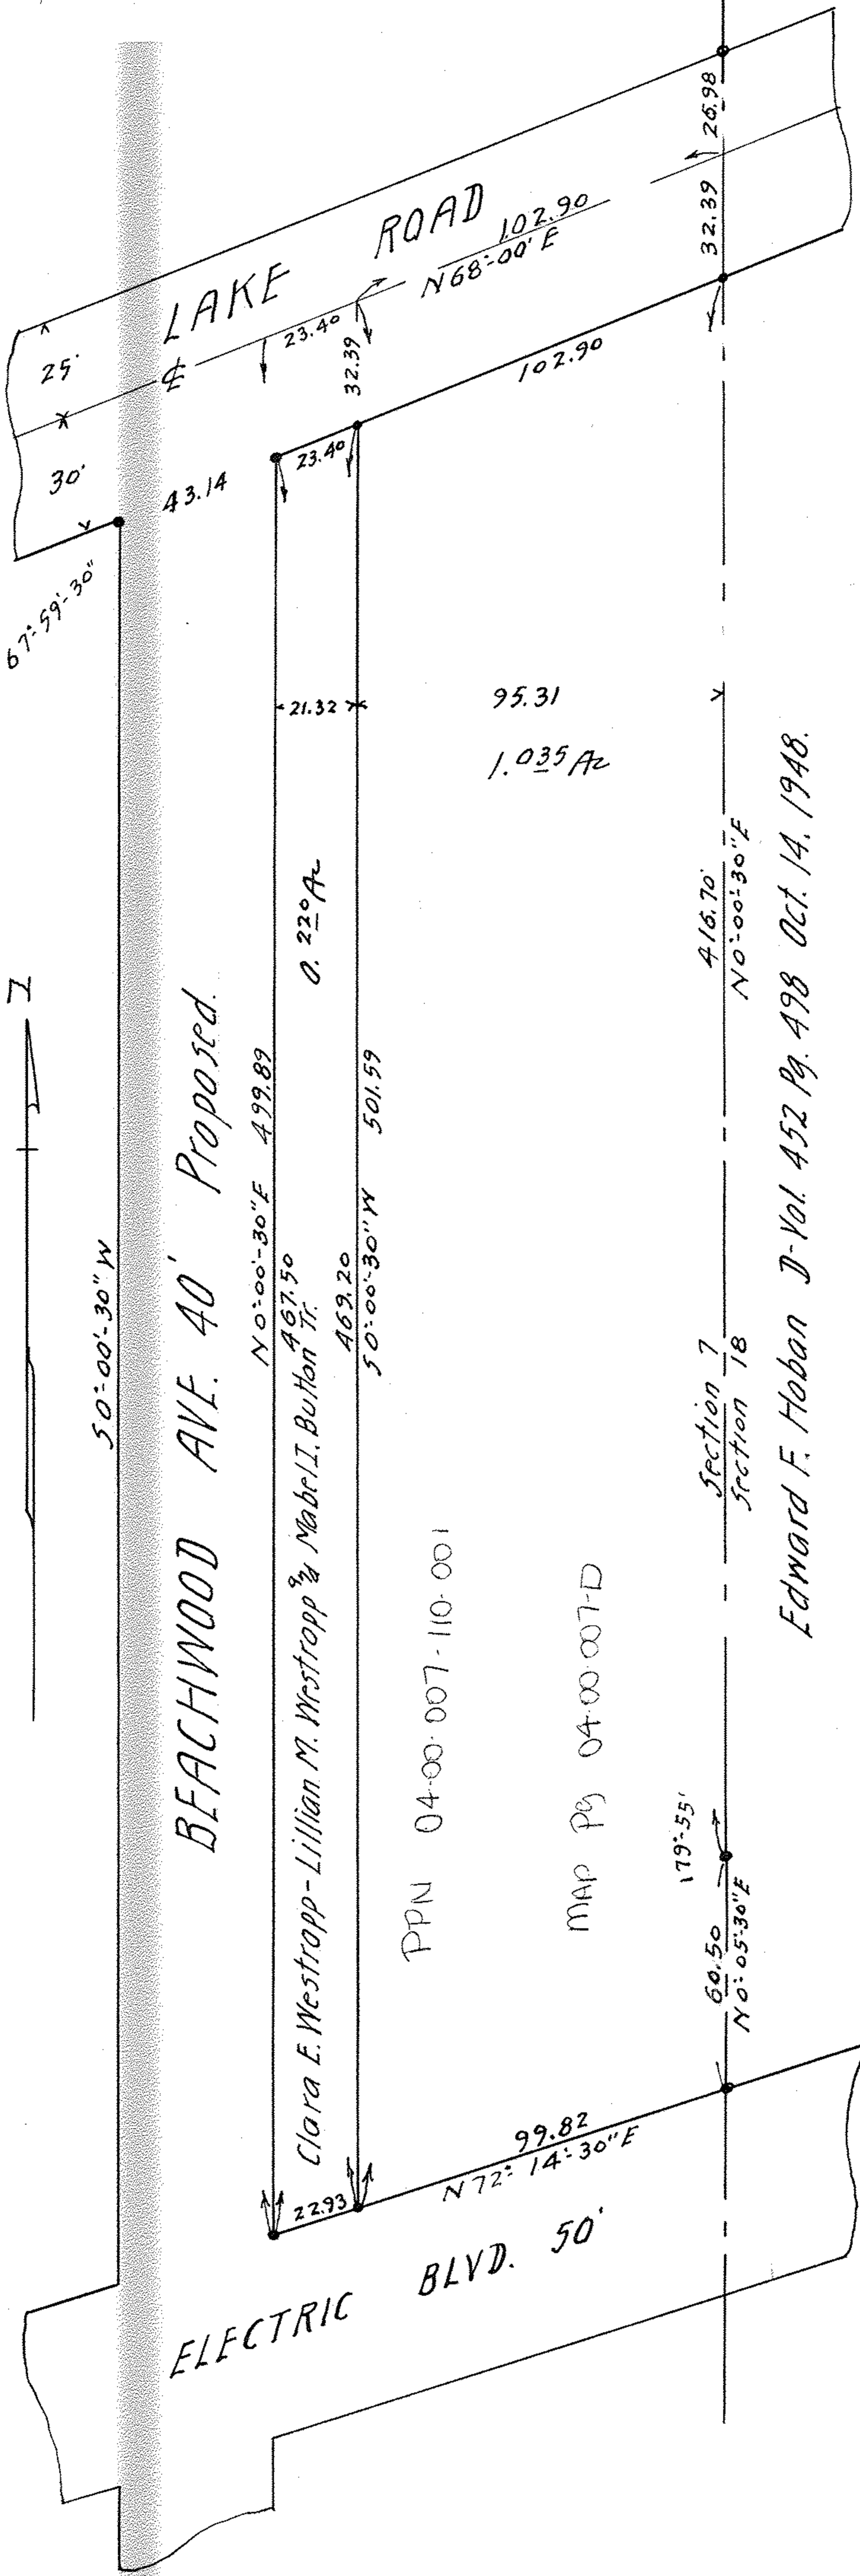

Edward F. Hoban D-Vol. 452 Pg. 498 Oct. 14, 1948.

Survey for
EDWARD F. HOBAN
 D-Vol. 597 Pg. 557 March 8, 1954.
 Saint Joseph Church
 Section 7 Avon Lake Village.
 Lorain County Ohio.
 Scale 1" = 40' Oct. 28, 1954.
 J. W. Warden & Associates, Reg. Surveyors.
 Note: Iron stakes found or set at all points thus •