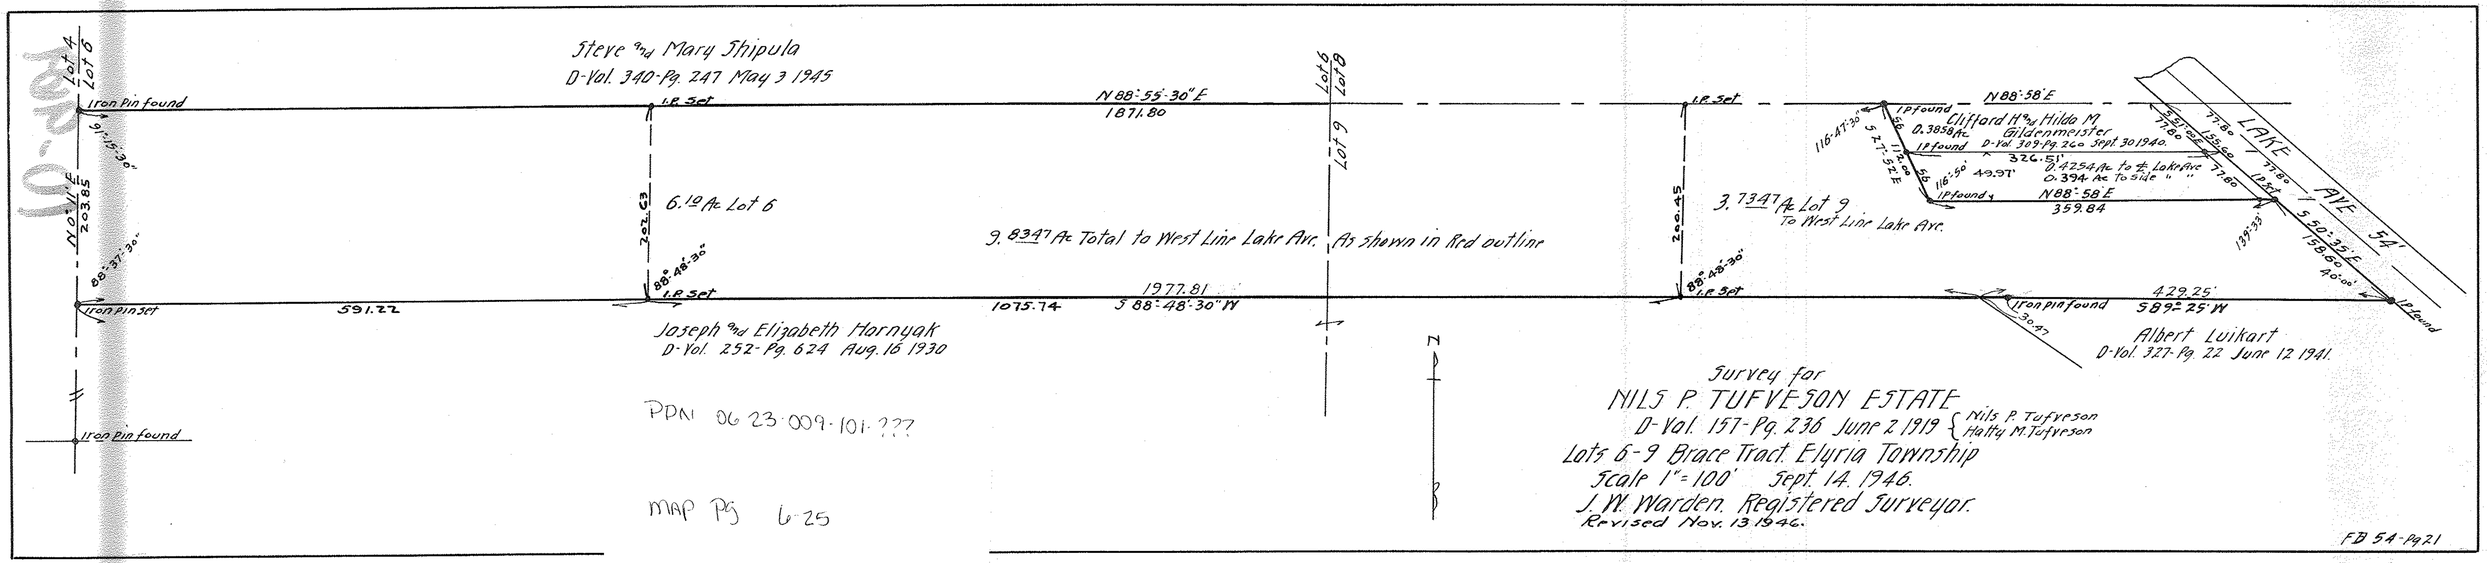

PPN 06 23 009 101 ???

MAP Pg 6-25