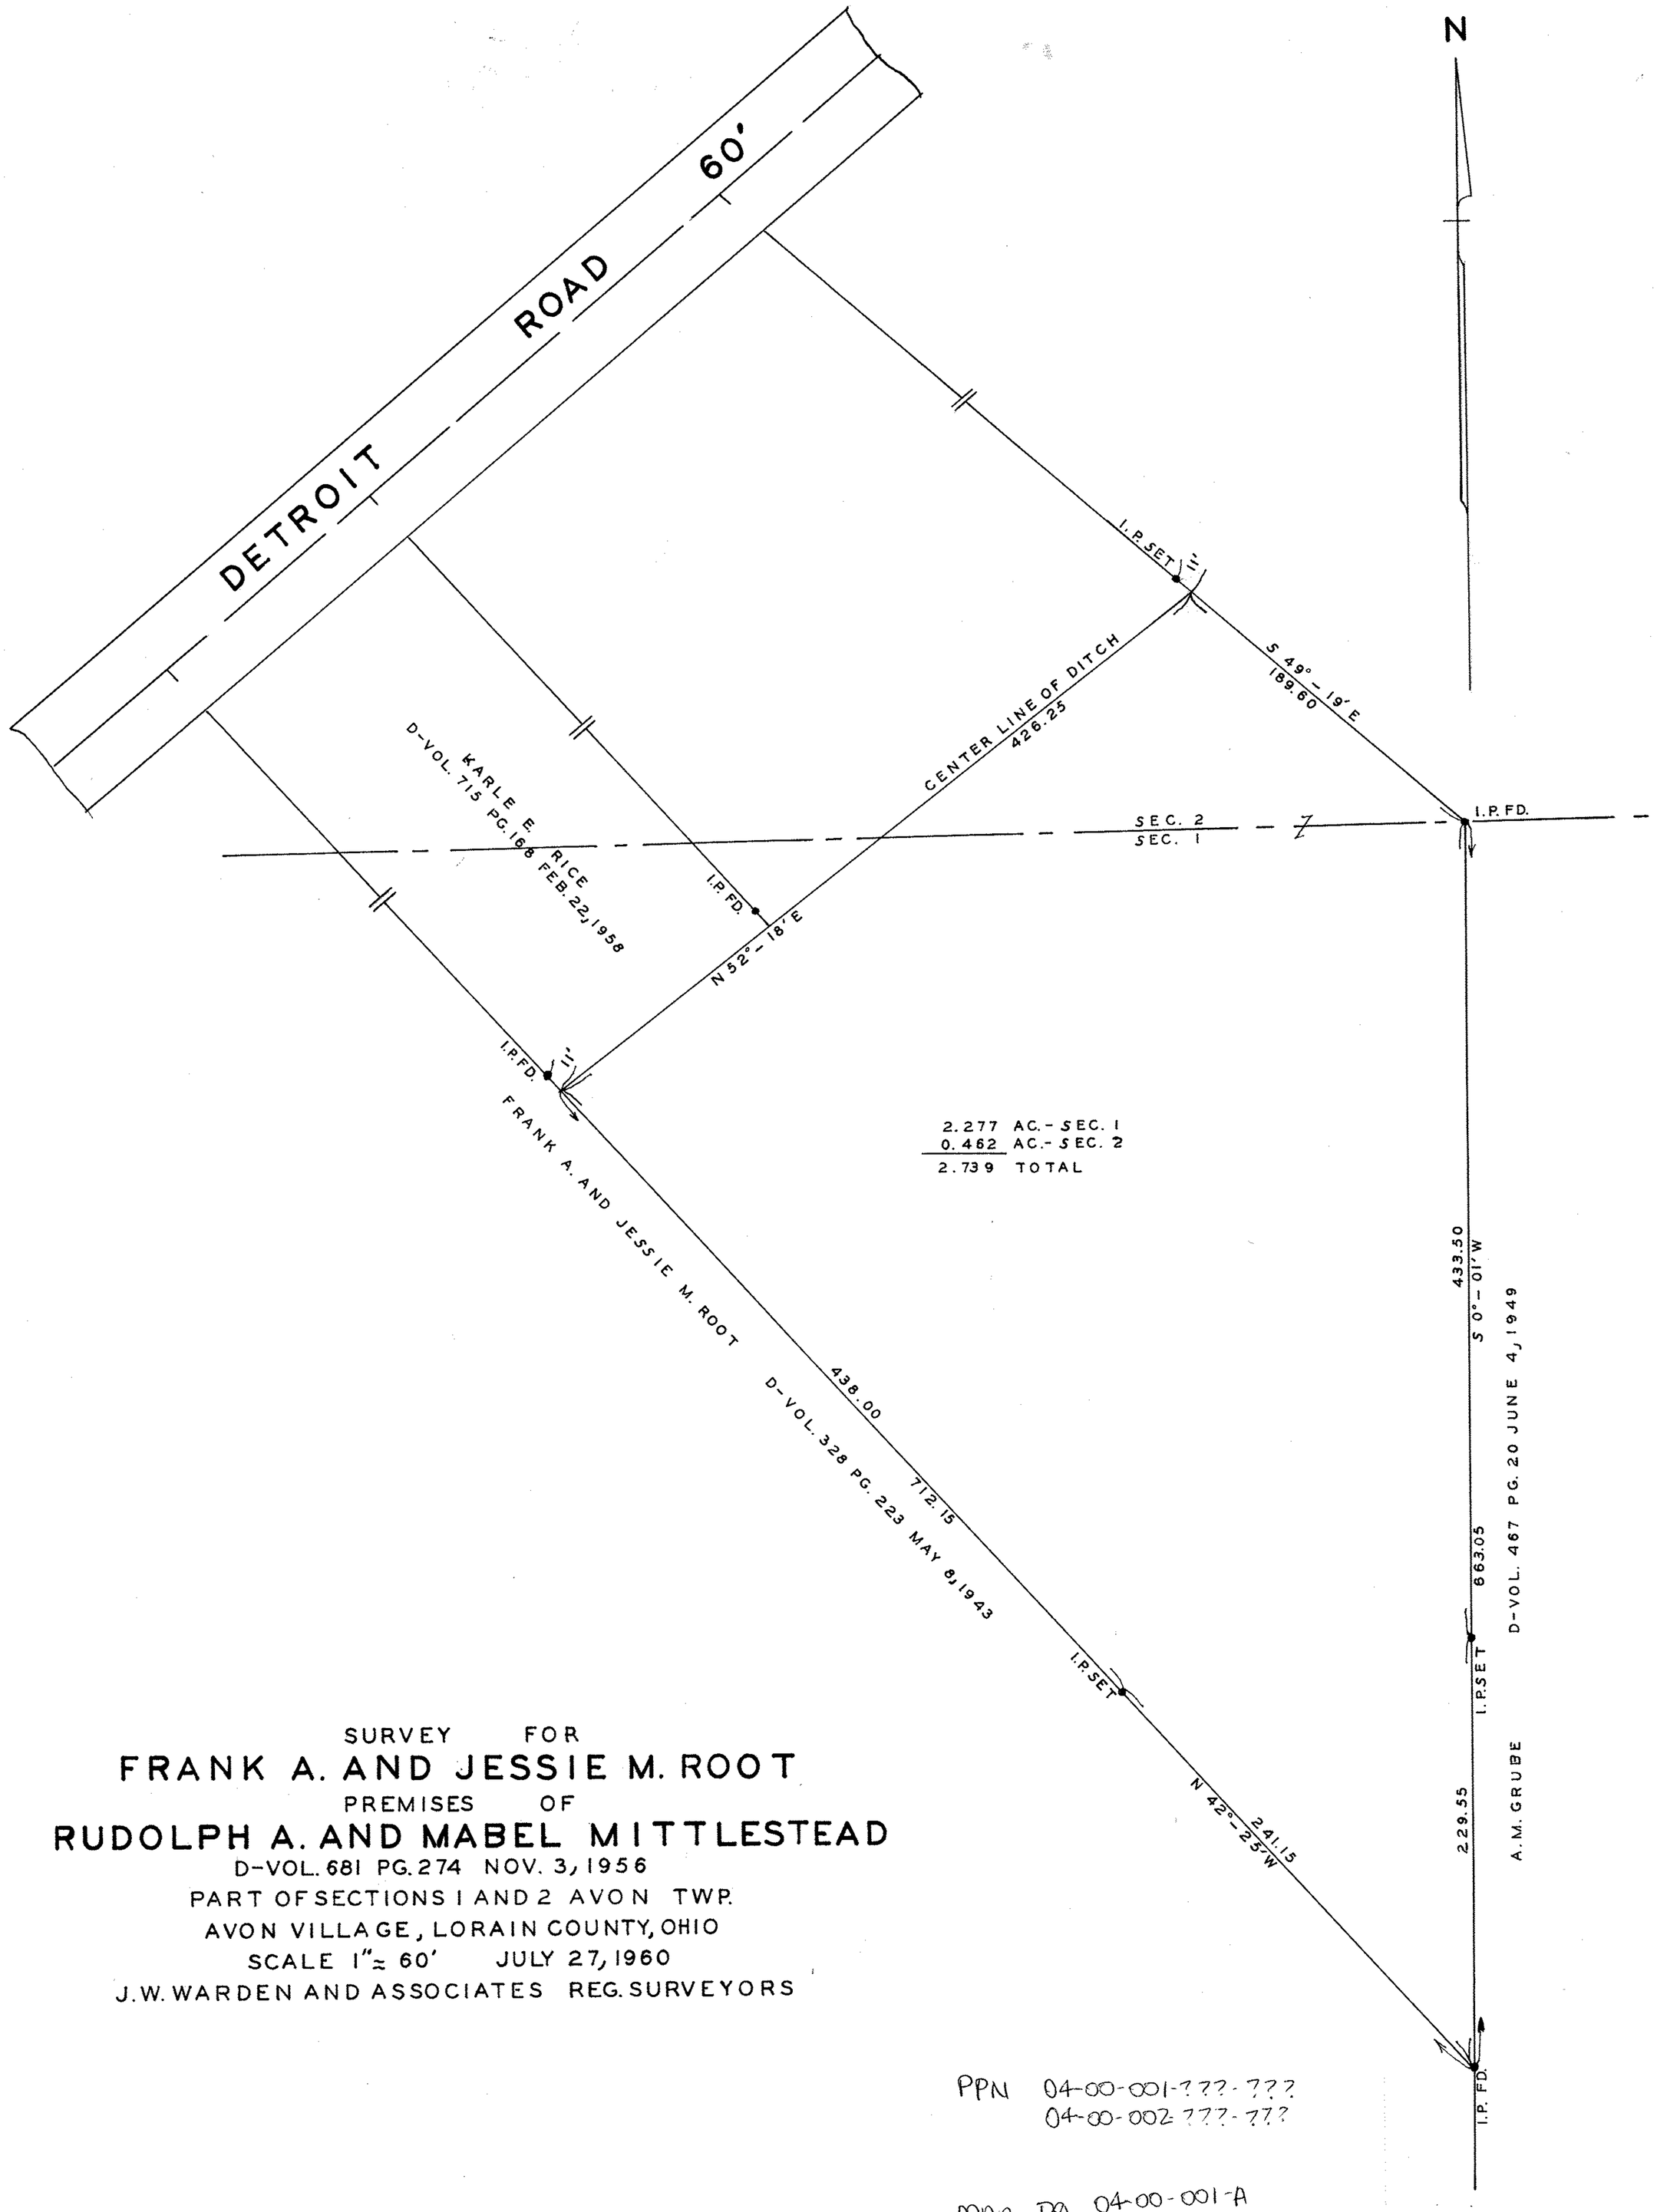


SURVEY FOR

# FRANK A. AND JESSIE M. ROOT

PREMISES OF

# RUDOLPH A. AND MABEL MITTLESTEAD

D-VOL. 681 PG. 274 NOV. 3, 1956

PART OF SECTIONS 1 AND 2 AVON TWP.

AVON VILLAGE, LORAIN COUNTY, OHIO

SCALE 1" = 60' JULY 27, 1960

J.W. WARDEN AND ASSOCIATES REG. SURVEYORS

PPN 04-00-001-???-???
04-00-002-???-???

MAP PG 04-00-001-A
04-00-002-E