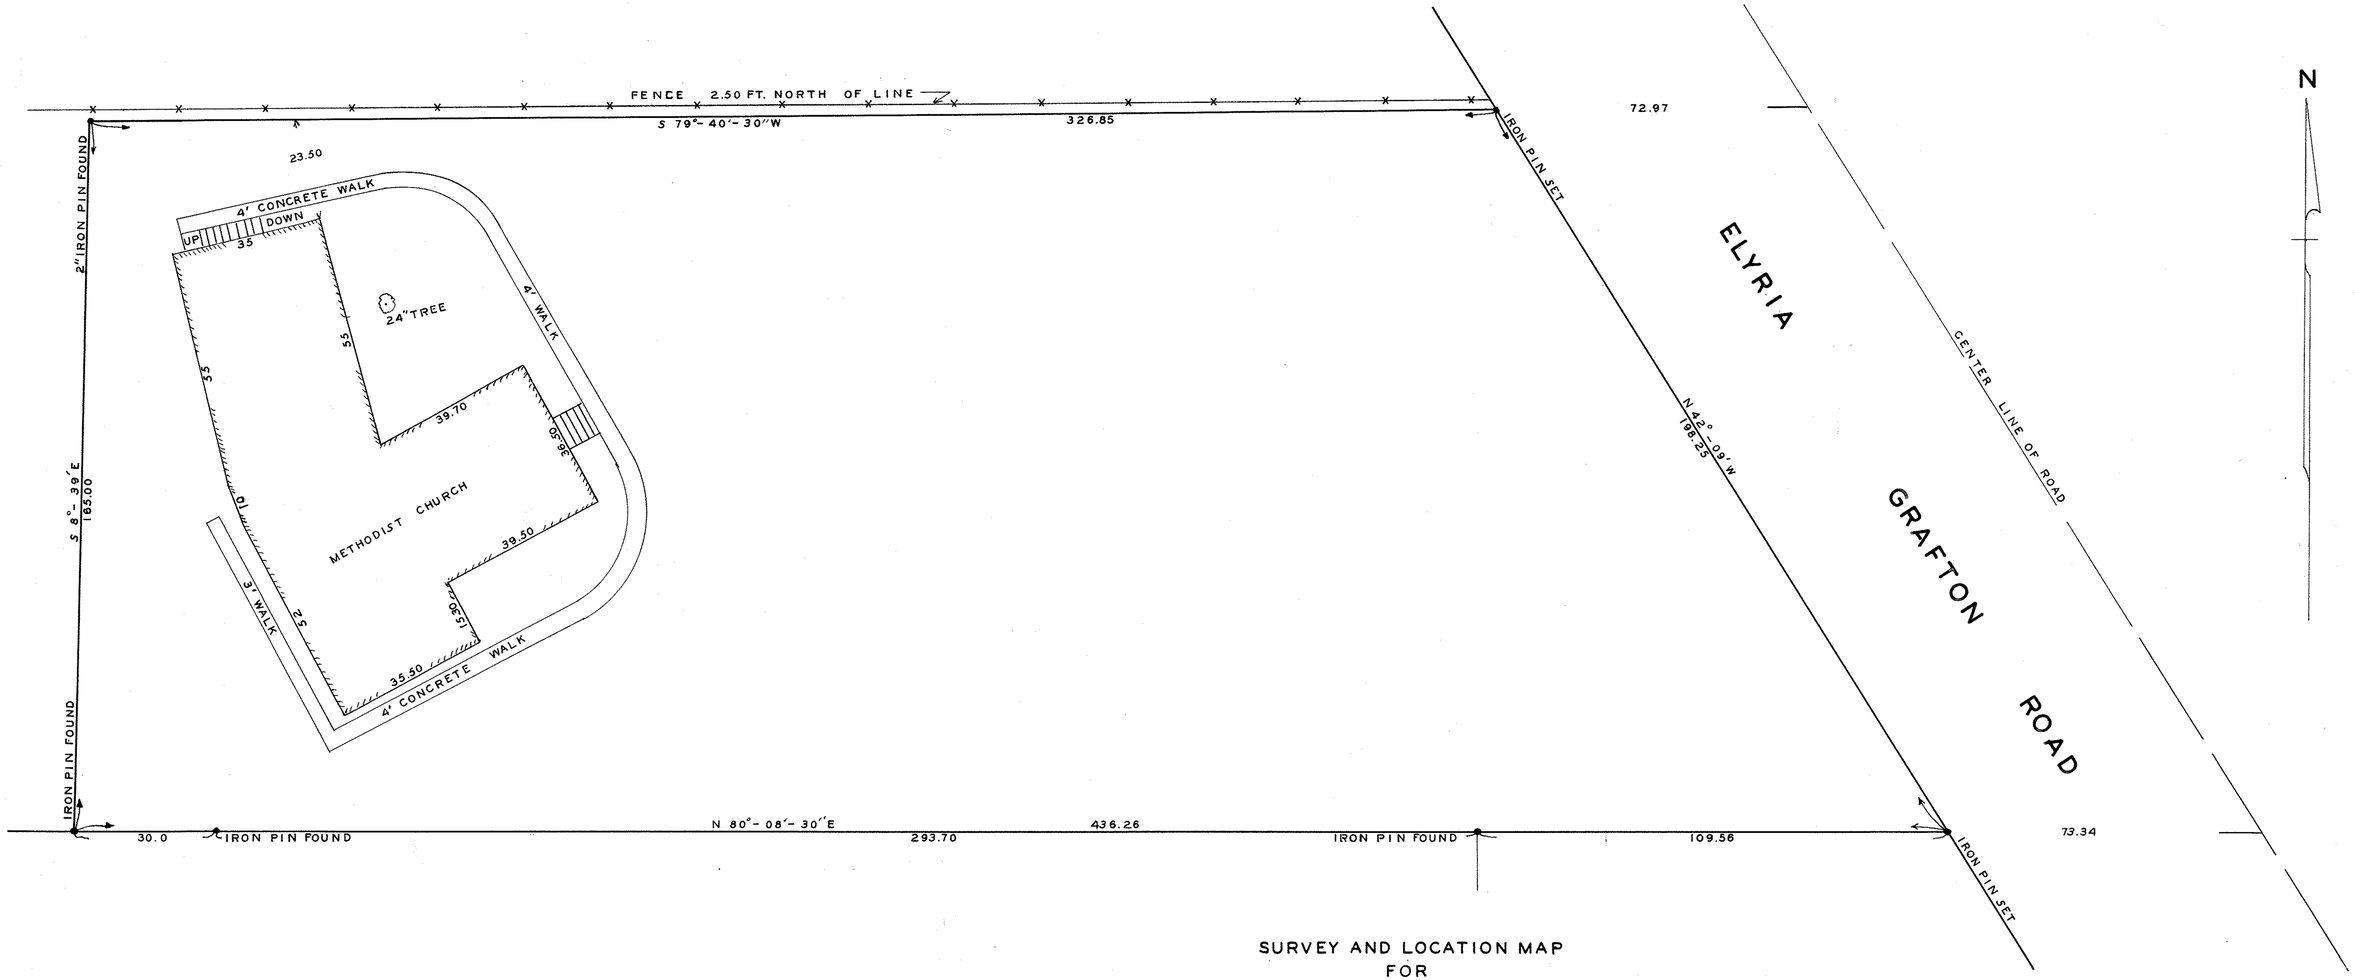

PREMISES ACQUIRED BY - D-VOL. P PG. 90 NOV. 29, 1842
442 551 JUNE 8, 1948
685 514 SEPT. 11, 1956
726 320 JULY 31, 1958

SURVEY AND LOCATION MAP
FOR
LAPORTE METHODIST CHURCH
LOTS 4-5-6-53-54 AND PARK BLOCK I
TOWN PLAT OF LAPORTE
SECTION 6 CARLISLE TOWNSHIP
LORAIN COUNTY, OHIO
SCALE 1" = 20' OCT. 14, 1960
J.W. WARDEN AND ASSOCIATES
REG. SURVEYORS

PPN 10-00-006-101-???

MAP PG 10-00-006-A