MUNICIPAL ENGINEERING | SUBDIVISIONS | CITY AND FARM SURVEYS

JOHN W. WARDEN

CIVIL ENGINEER AND SURVEYOR

405 ELYRIA BLOCK

ELYRIA, OHIO

STATE OF OHIO

REGISTERED { PROFESSIONAL ENG. / SURVEYOR

PHONES

BUSINESS 3211

RESIDENCE 38633

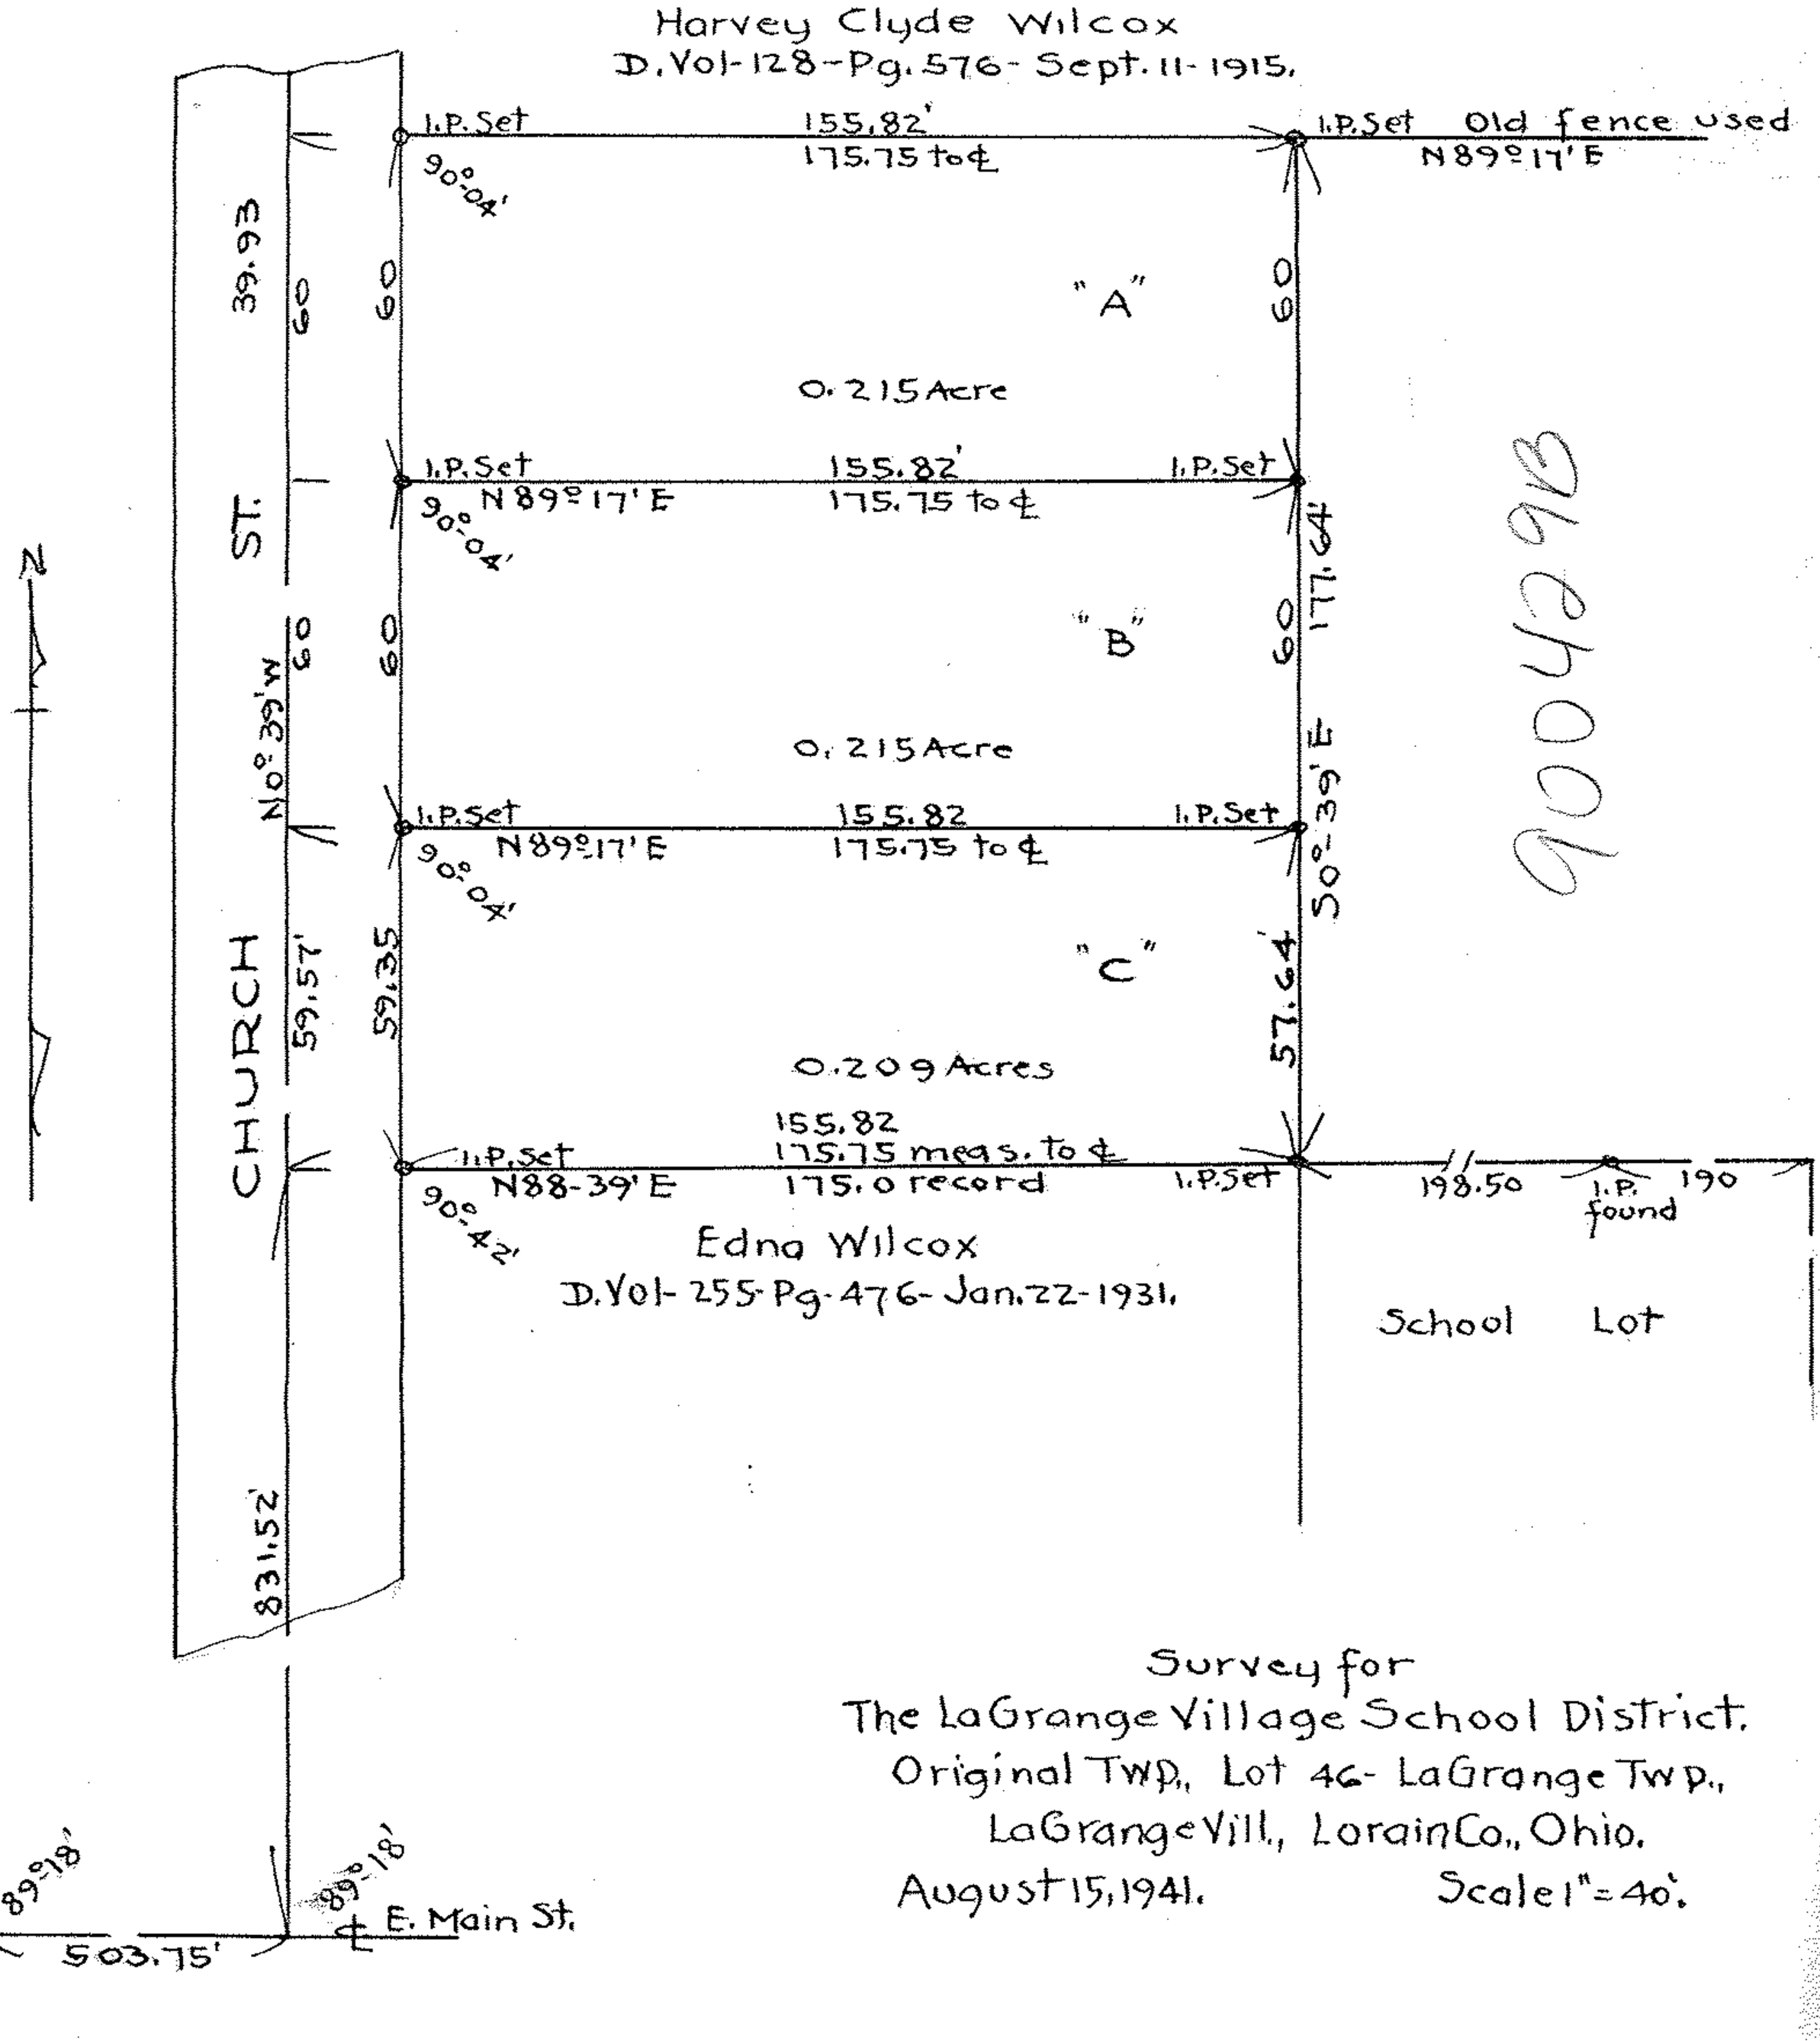

Survey for
The LaGrange Village School District.
Original Twp., Lot 46- LaGrange Twp.,
LaGrange Vill., Lorain Co., Ohio.
August 15, 1941. Scale 1" = 40'.