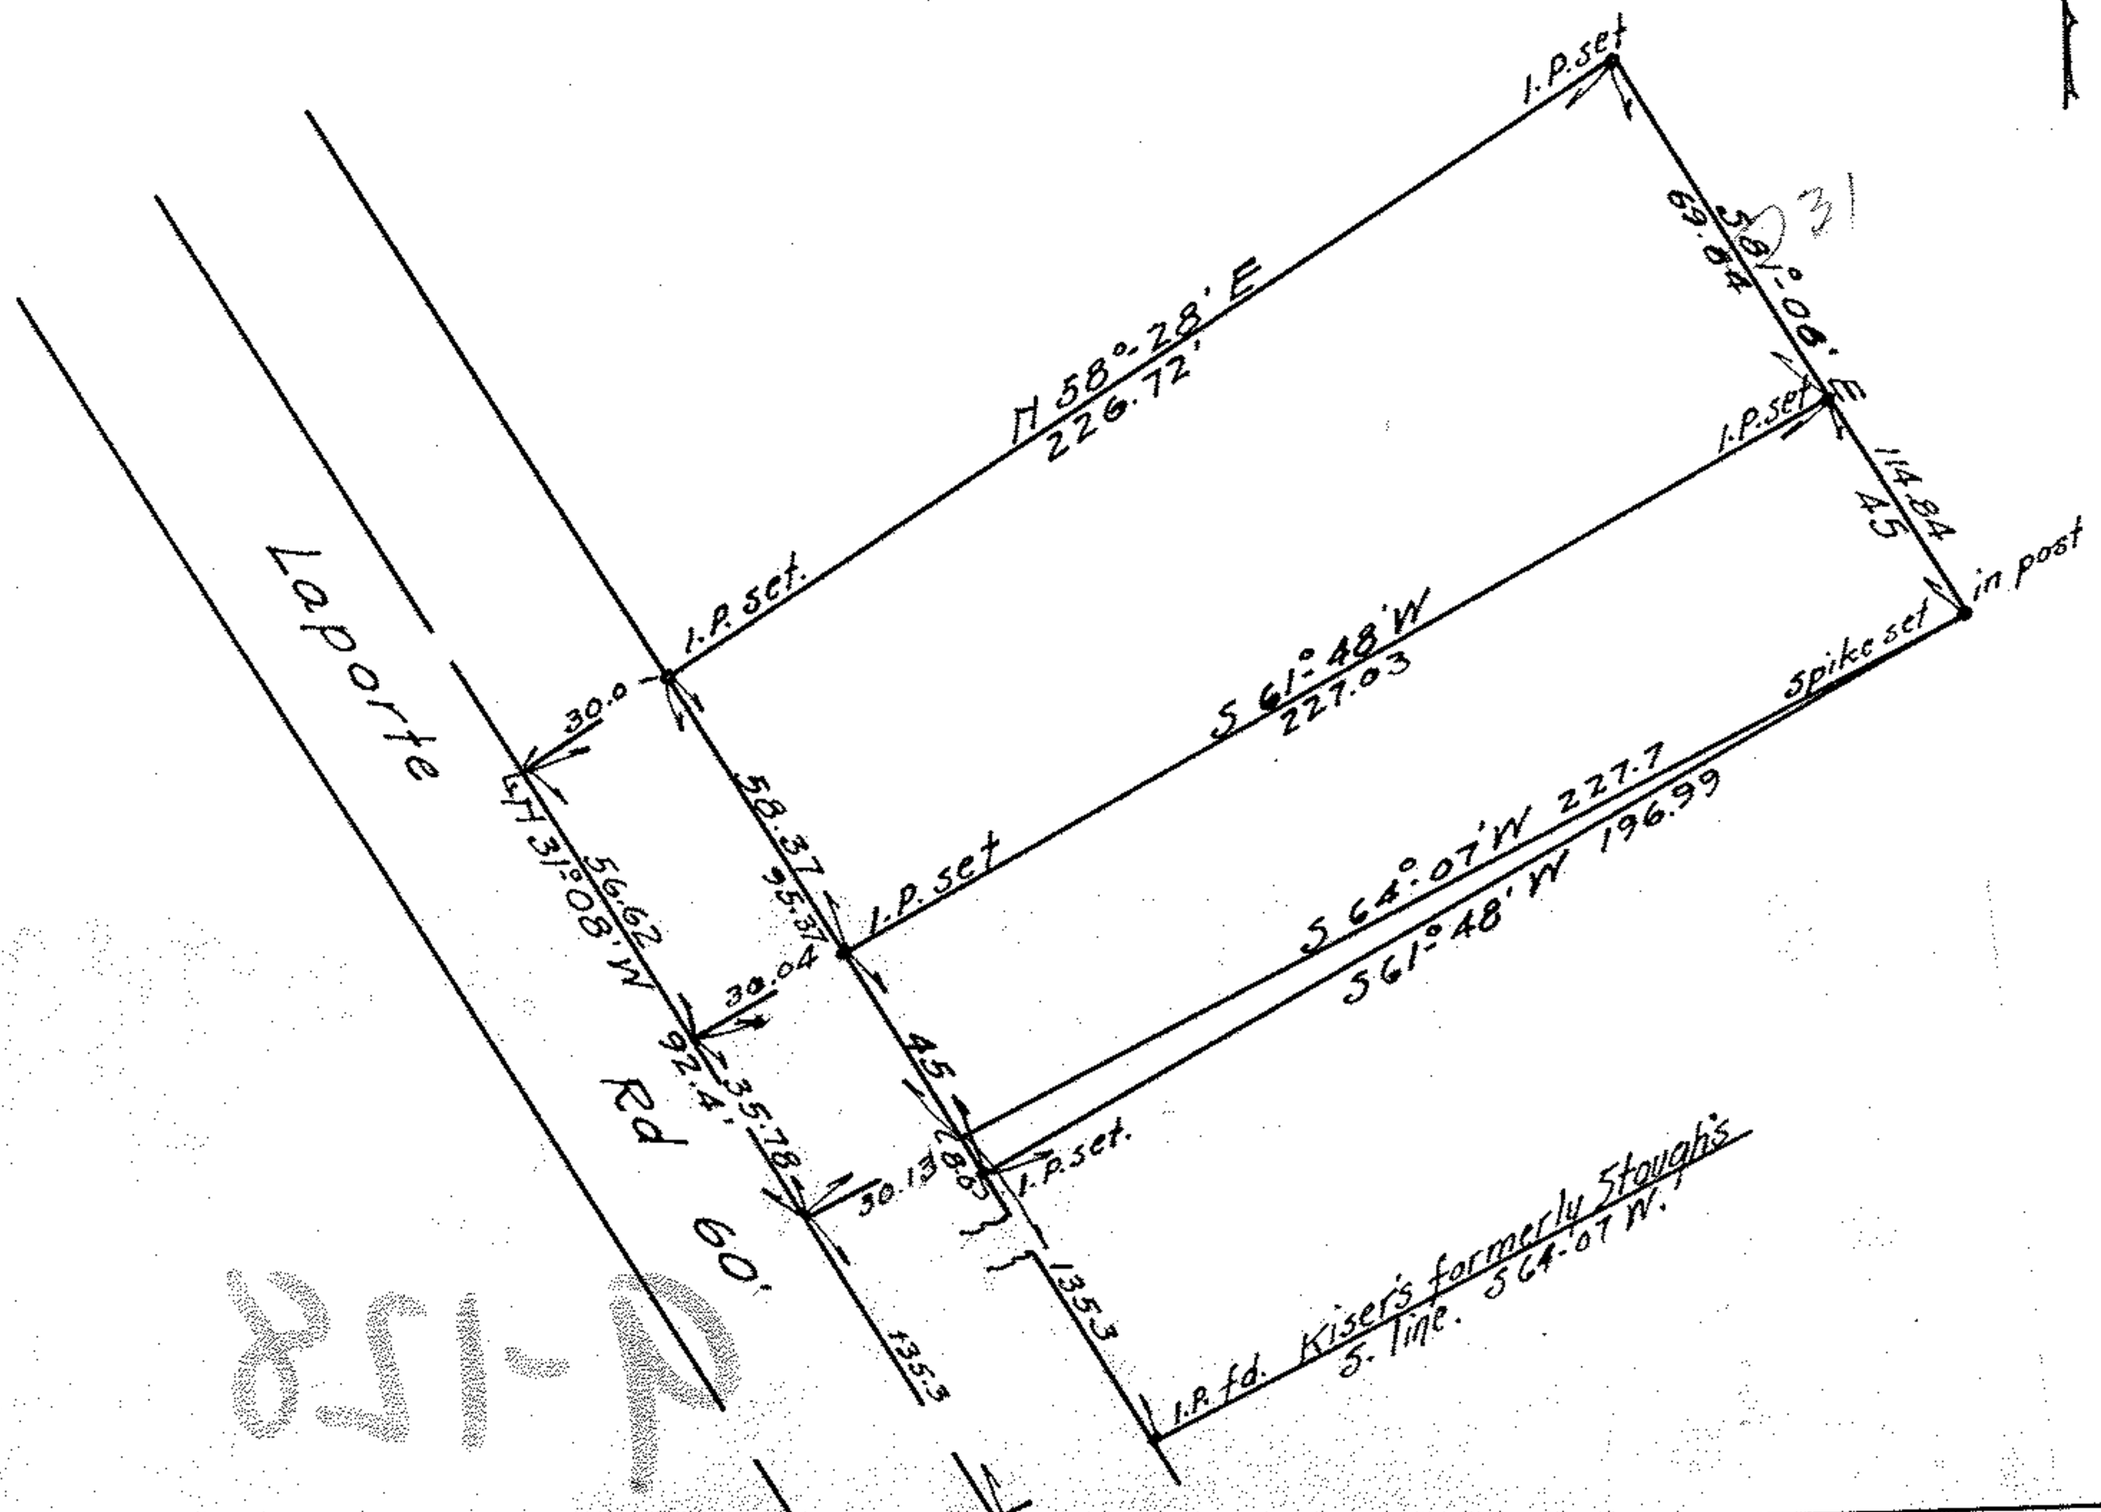Survey for Elmer Dimick
Sec 4 Carlisle Twp. Lorain Co. Ohio
Scale 1" = 50' Apr 23, 1919.
Warden & Saunders - Engineers