SECOND STREET 66'

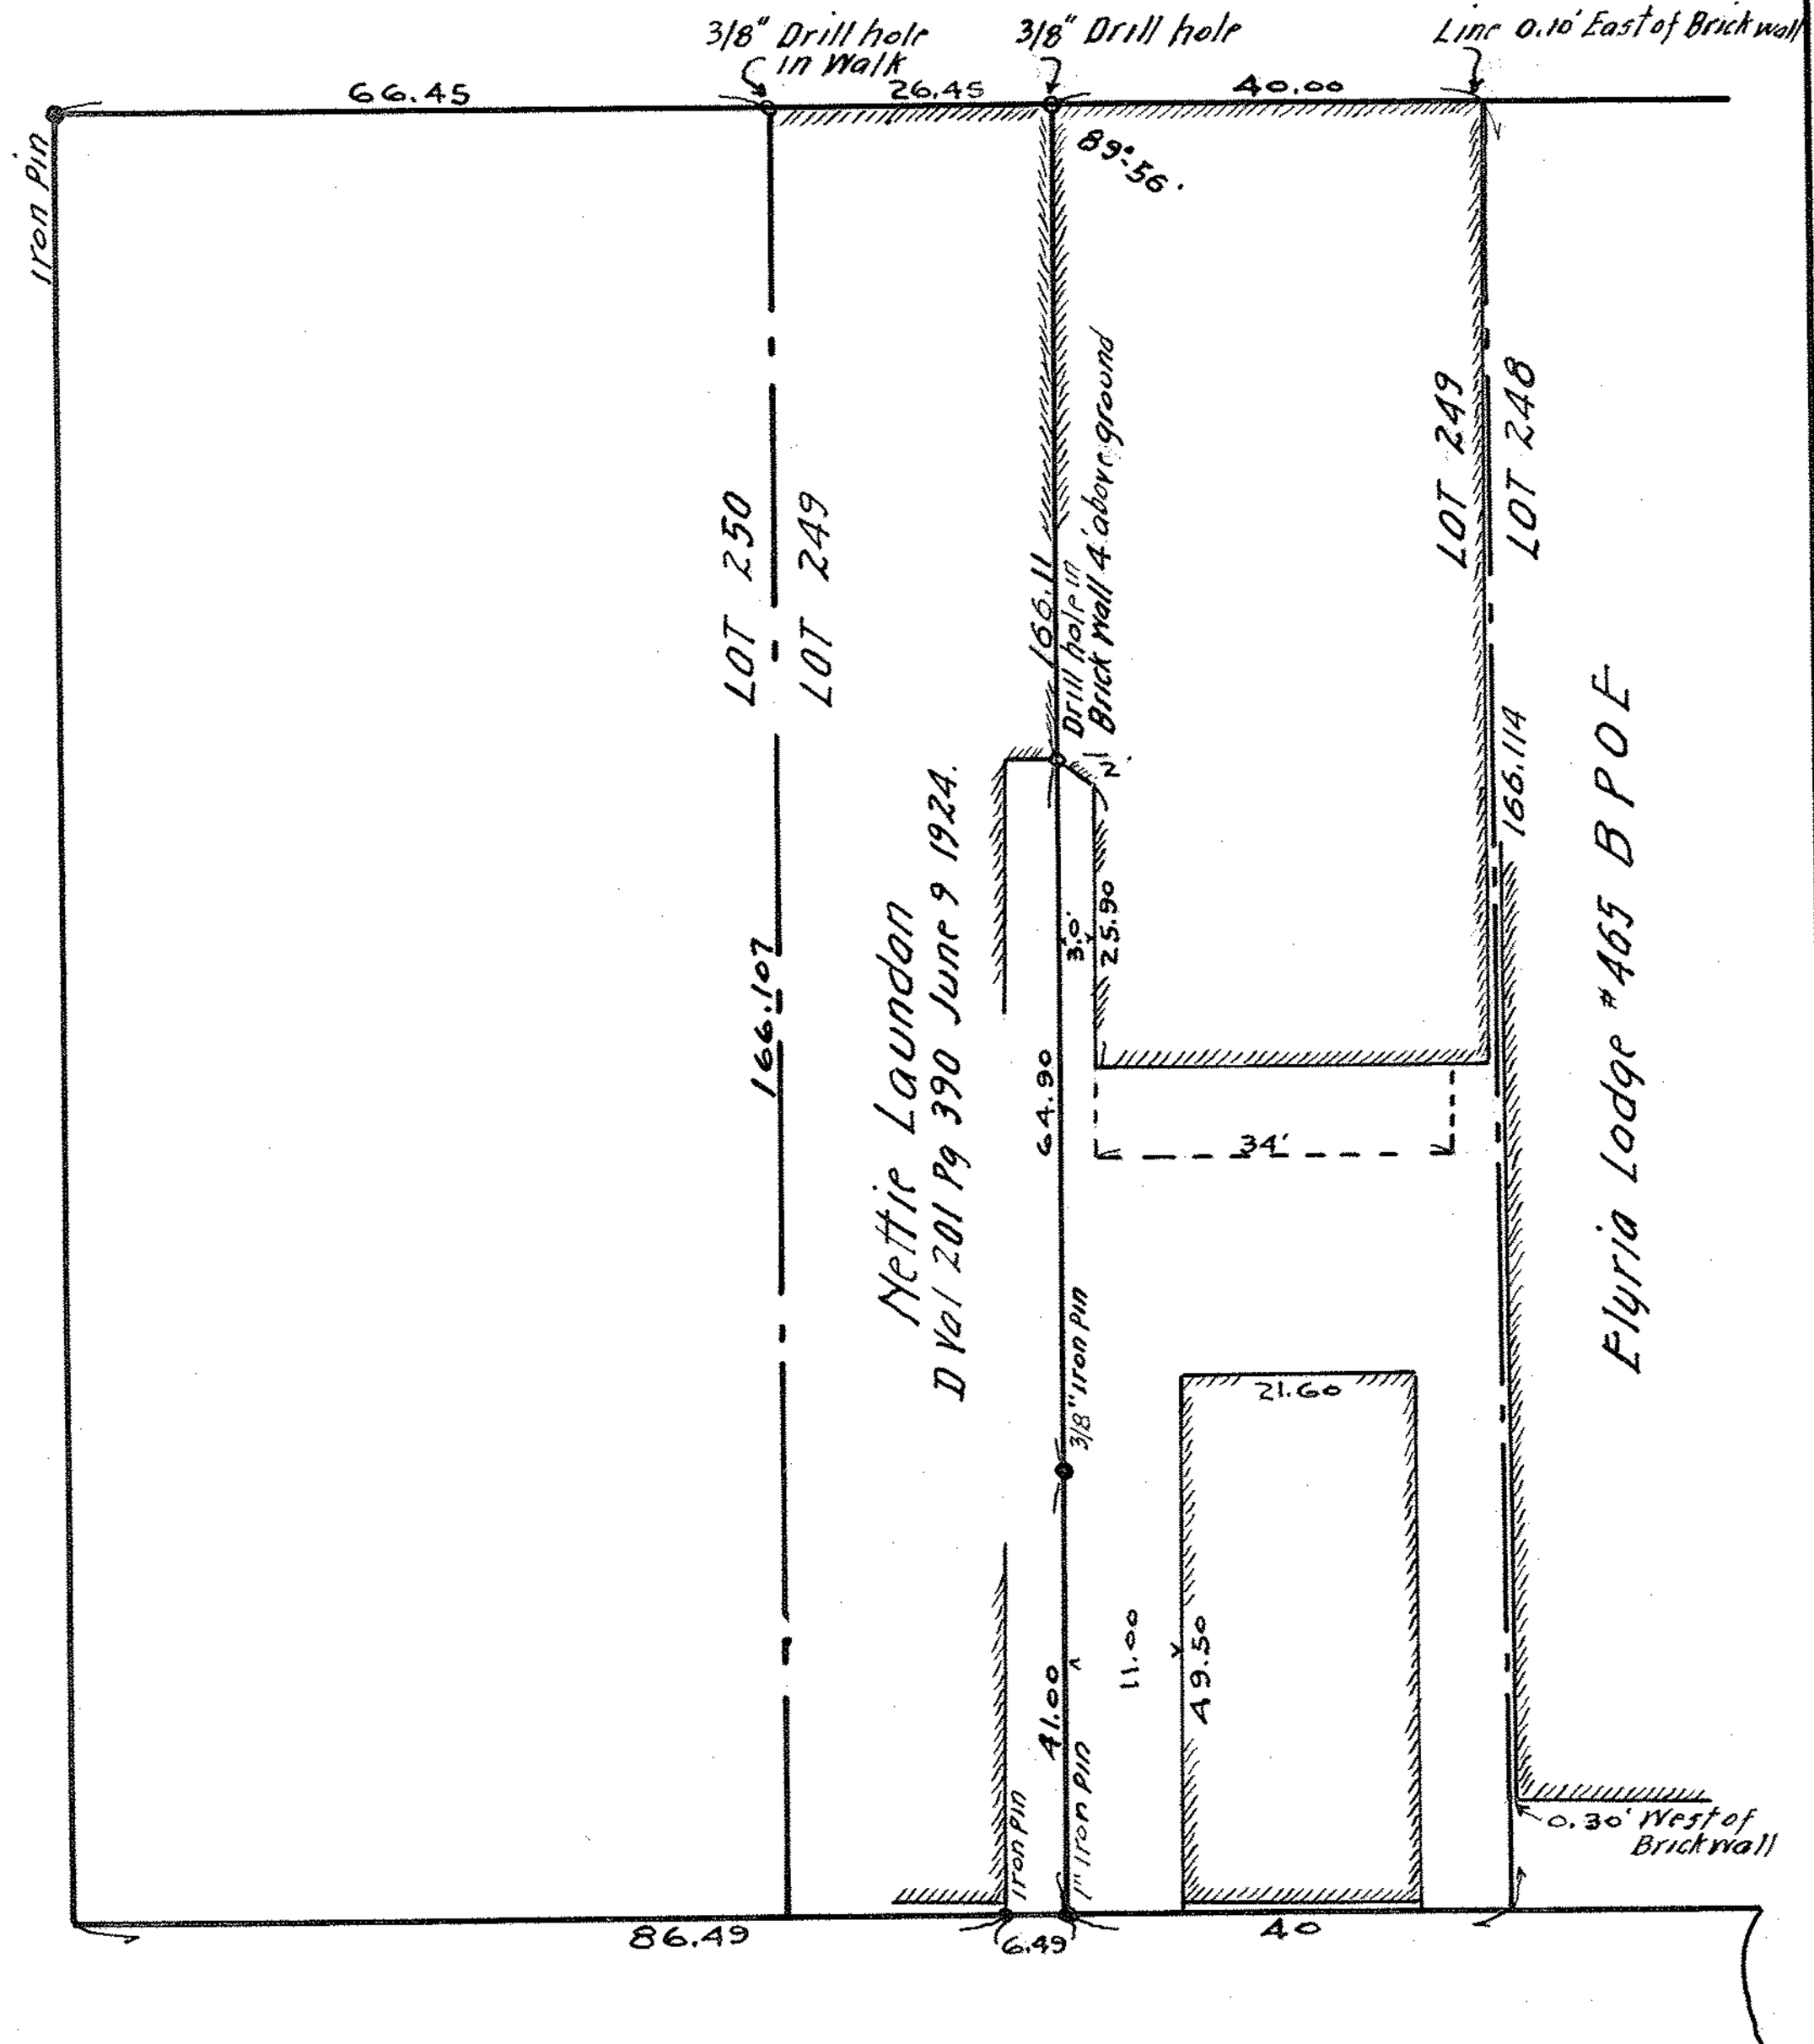

TEMPLE COURT 33'

Survey For
BERTHA SCHER
Part of Lot 249 Block 60 Orig. Vill. Plat
Elyria City Lorain County Ohio
Deed Vol. 331 Pg 444 Nov. 16 1943.
Scale 1" = 20' Aug. 16 1944.
J. W. Warden. Registered Surveyor.

40891

D.A.