Survey for the Elyria National Bank.
in
Lots 94-87 Eaton Township Lorain Co Ohio

Scale 1 inch = 300 feet. July 20 1907

C.H. Lawrence. C.E.
Wm Peters Asst.

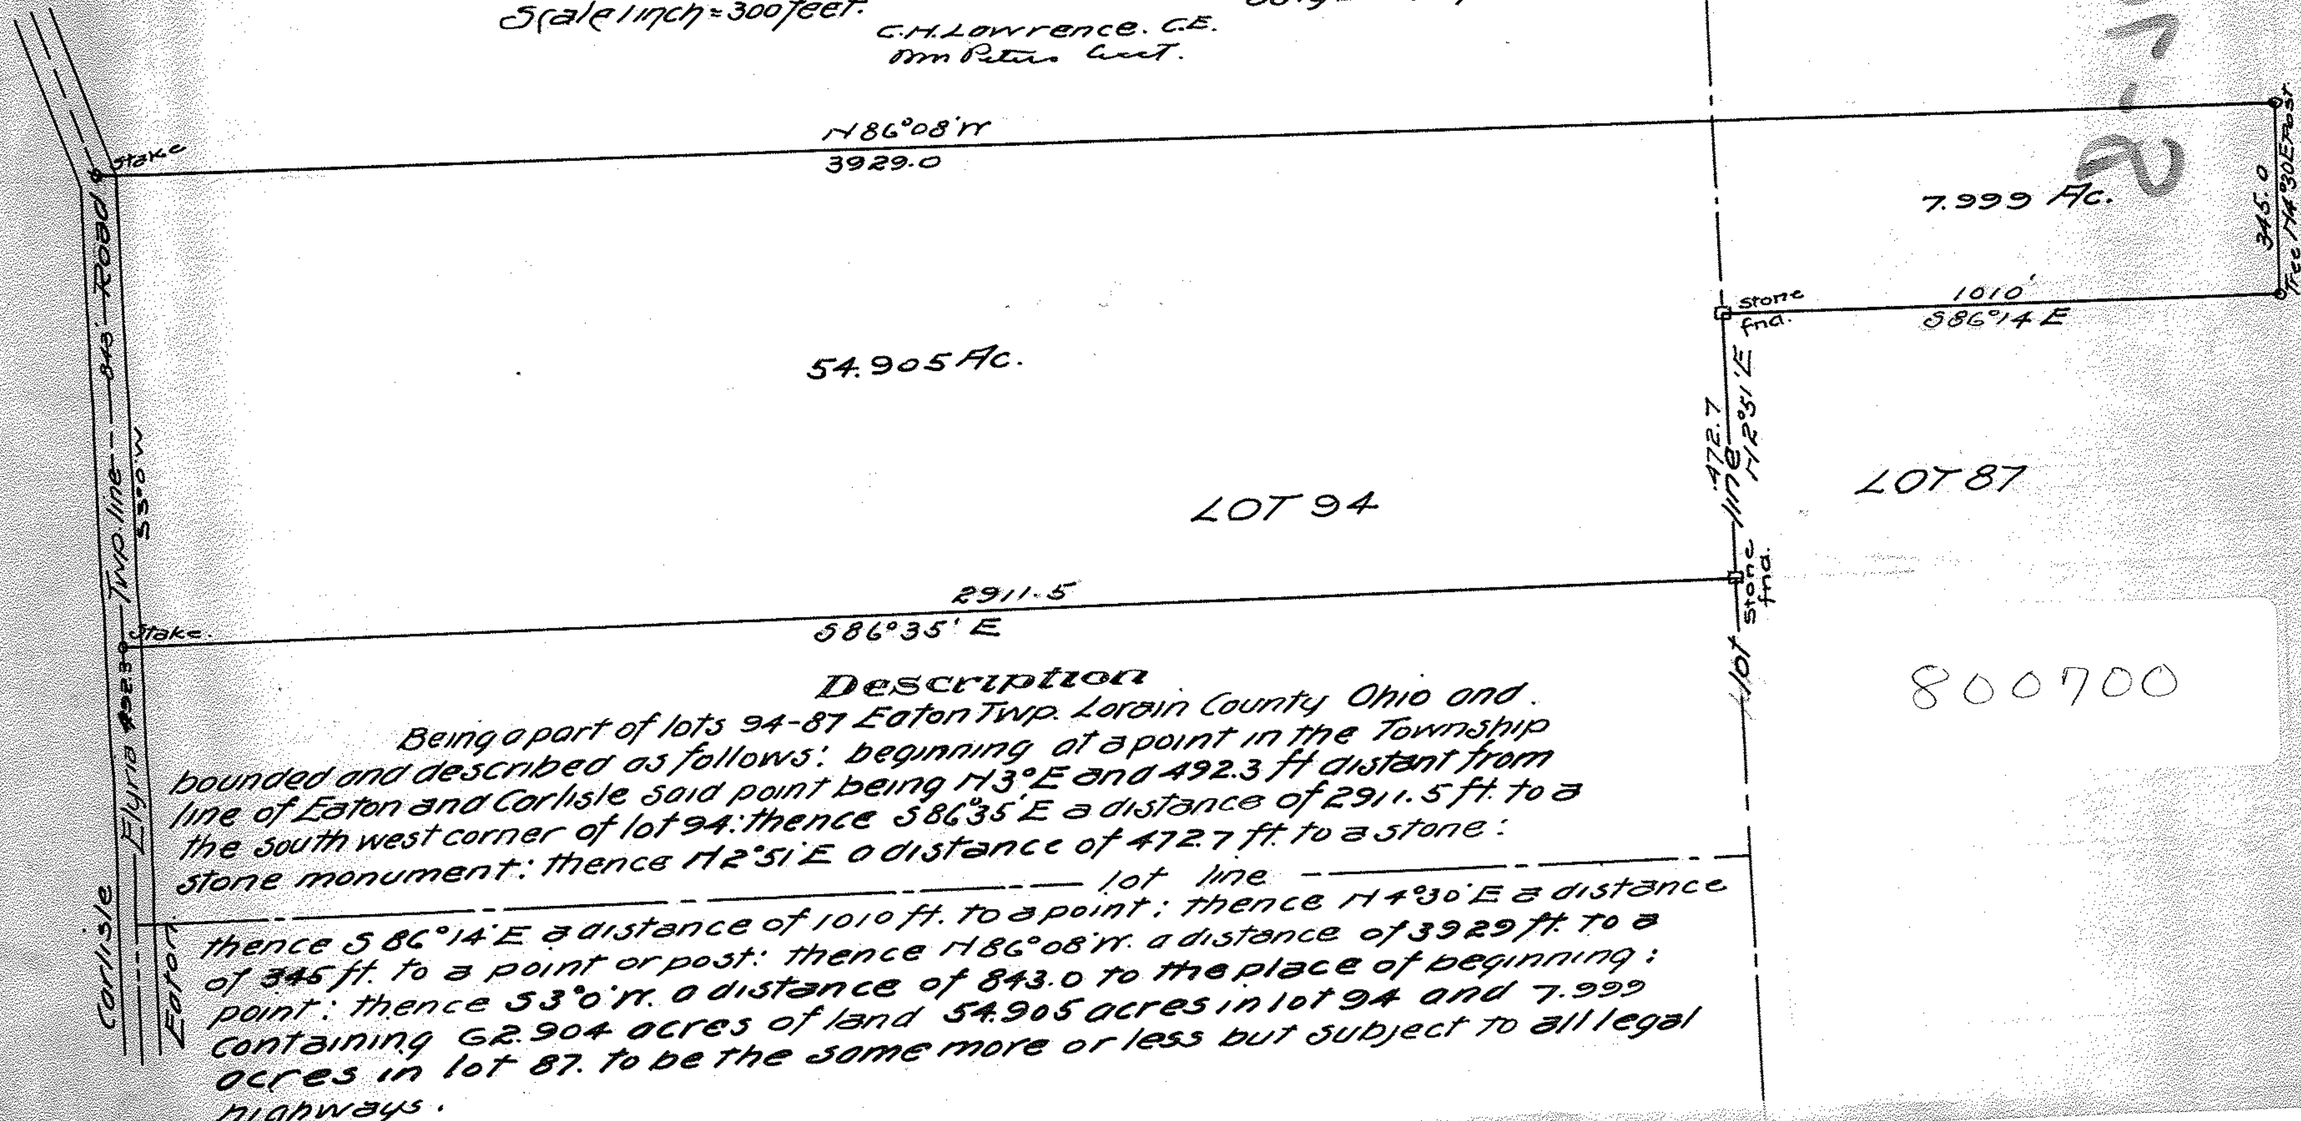

800700

Description

Being a part of lots 94-87 Eaton Twp. Lorain County Ohio and bounded and described as follows: beginning at a point in the Township line of Eaton and Carlisle said point being N3°E and 492.3 ft distant from the south west corner of lot 94: thence S86°35'E a distance of 2911.5 ft. to a stone monument: thence N2°51'E a distance of 472.7 ft. to a stone: lot line thence S86°14'E a distance of 1010 ft. to a point: thence N4°30'E a distance of 345 ft. to a point or post: thence N86°08'W. a distance of 3929 ft. to a point: thence S3°0'W. a distance of 843.0 to the place of beginning: containing 62.904 acres of land 54.905 acres in lot 94 and 7.999 acres in lot 87. to be the same more or less but subject to all legal highways.