111-8

800 111 A

Survey of farm owned by the Wm. T. Wilder Estate

O.L. #11-12 Sheffield Twp.

Lorain Co., Ohio

Feb 9, 1915 T.L. Gibson C.E.

Scale 1" = 300 ft.

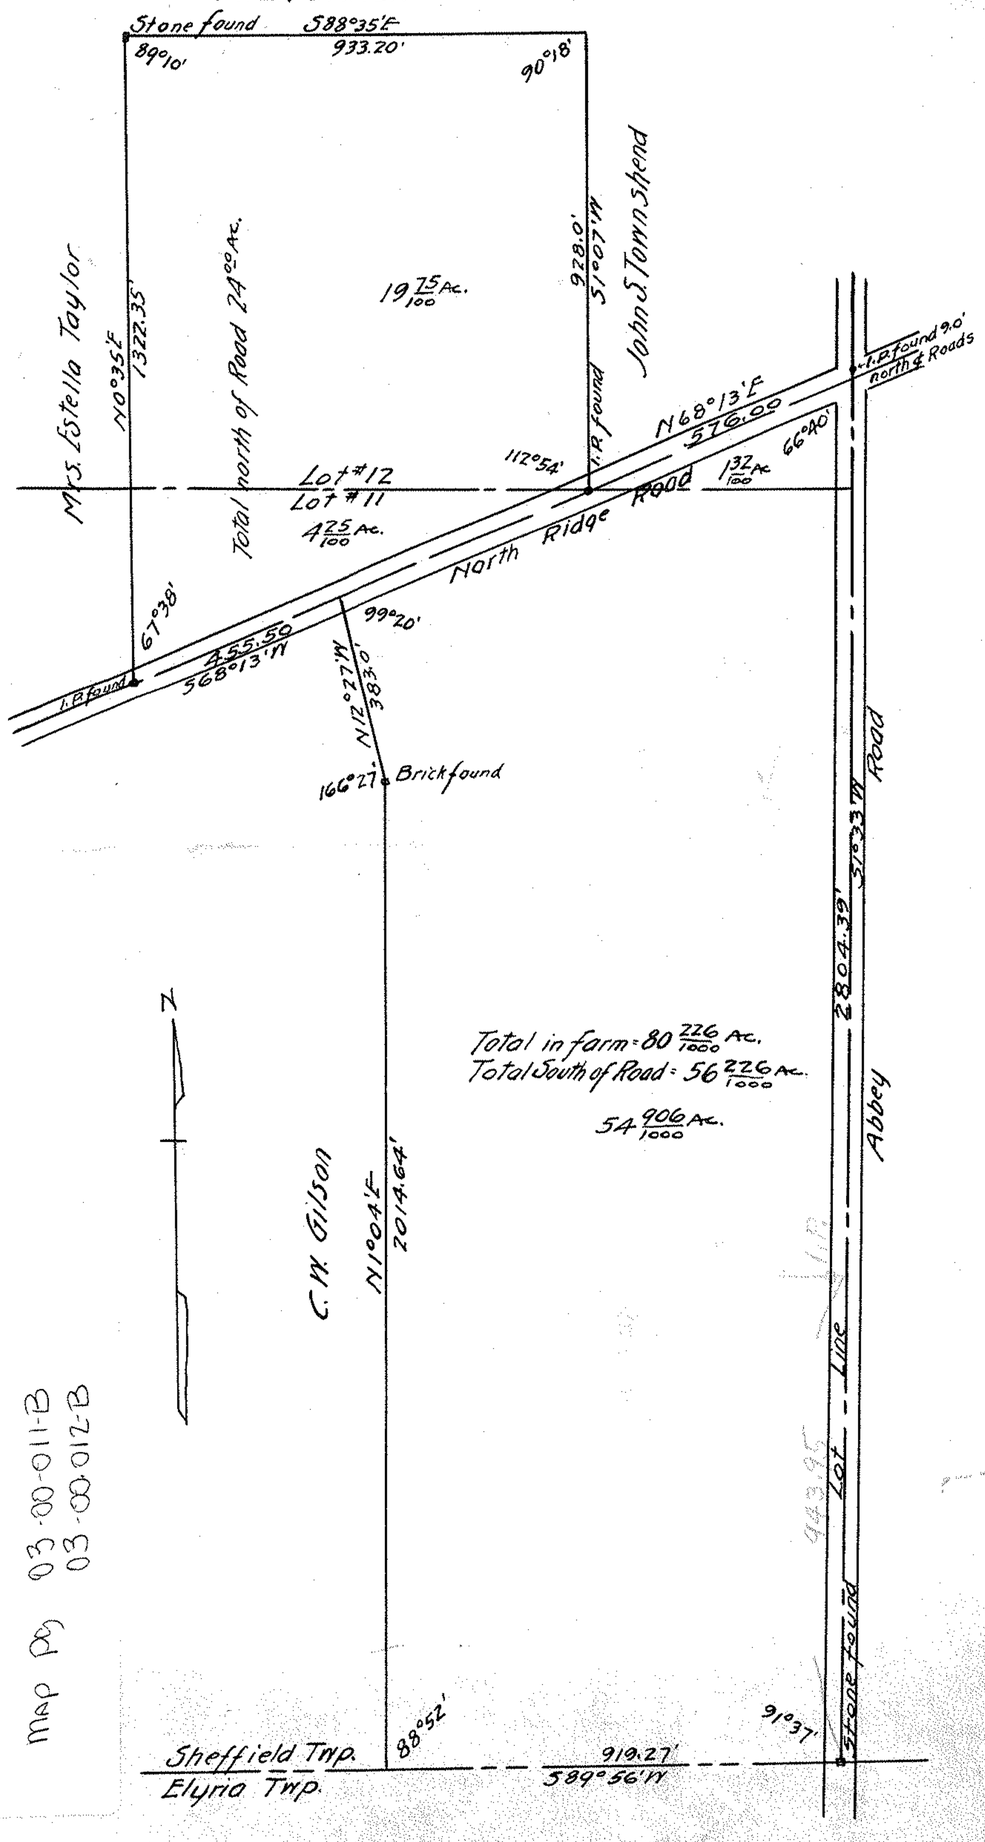

PPN 03-00-011-101-???
03-00-012-000-???

Map #s 03-00-011-B
03-00-012-B