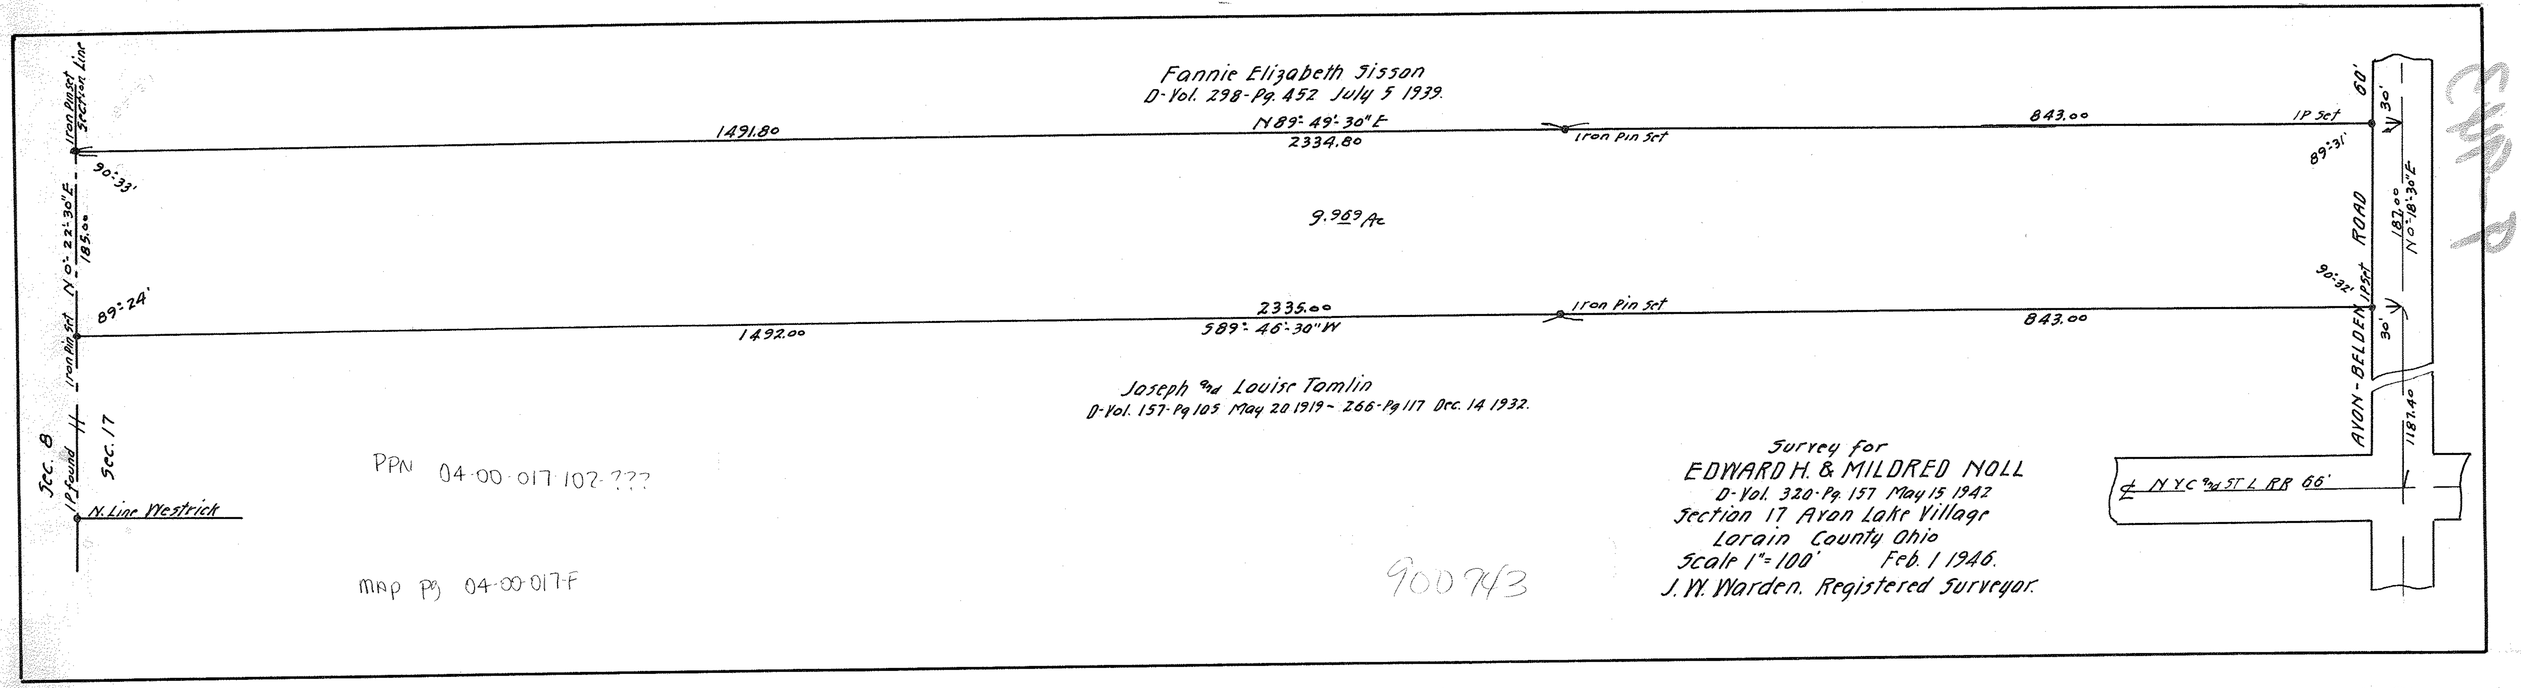
Fannie Elizabeth Sisson
D-Vol. 298-Pg. 452 July 5 1939.
Iron Pin Set
Section Line
1491.80
N89°-49'-30"E
2334.80
Iron Pin Set
843.00
IP Set
60'
30'
90°-33'
89°-31'
N0°-22'-30"E
185.00
9.989 Ac
N0°-18'-30"E
187.00
AVON-BELDEN ROAD
89°-24'
90°-32'
IPSet
2335.00
S89°-46'-30"W
Iron Pin Set
1492.00
843.00
30'
Joseph and Louise Tomlin
D-Vol. 157-Pg 105 May 20 1919 - 266-Pg 117 Dec. 14 1932.
1187.40
Sec. 8
Sec. 17
IP found
N. Line Westrick
PPN 04-00-017-102-???
Map Pg 04-00-017-F
Survey for
EDWARD H. & MILDRED NOLL
D-Vol. 320-Pg. 157 May 15 1942
Section 17 Avon Lake Village
Lorain County Ohio
Scale 1"=100' Feb. 1 1946.
J. W. Warden. Registered Surveyor.
℄ NYC and ST L RR 66'

900743