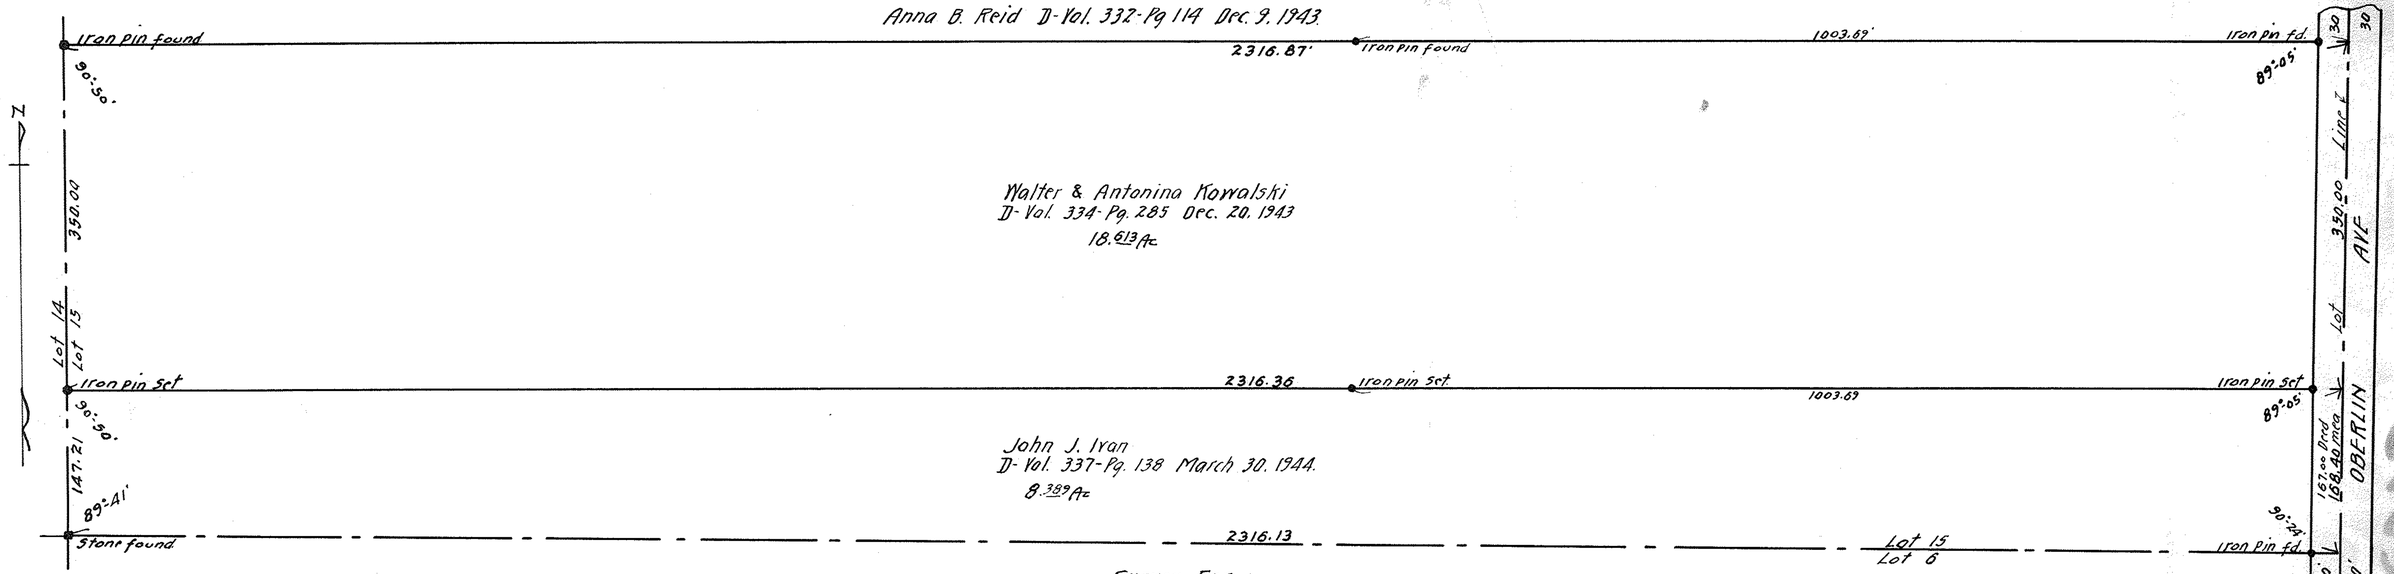

Survey For
DORA LERTZMAN
Lot 15 Tract 2 Black River Township
Lorain County O.
Scale 1" = 100' May 10, 1944
J. W. Warden, Registered Surveyor.

700890

6886