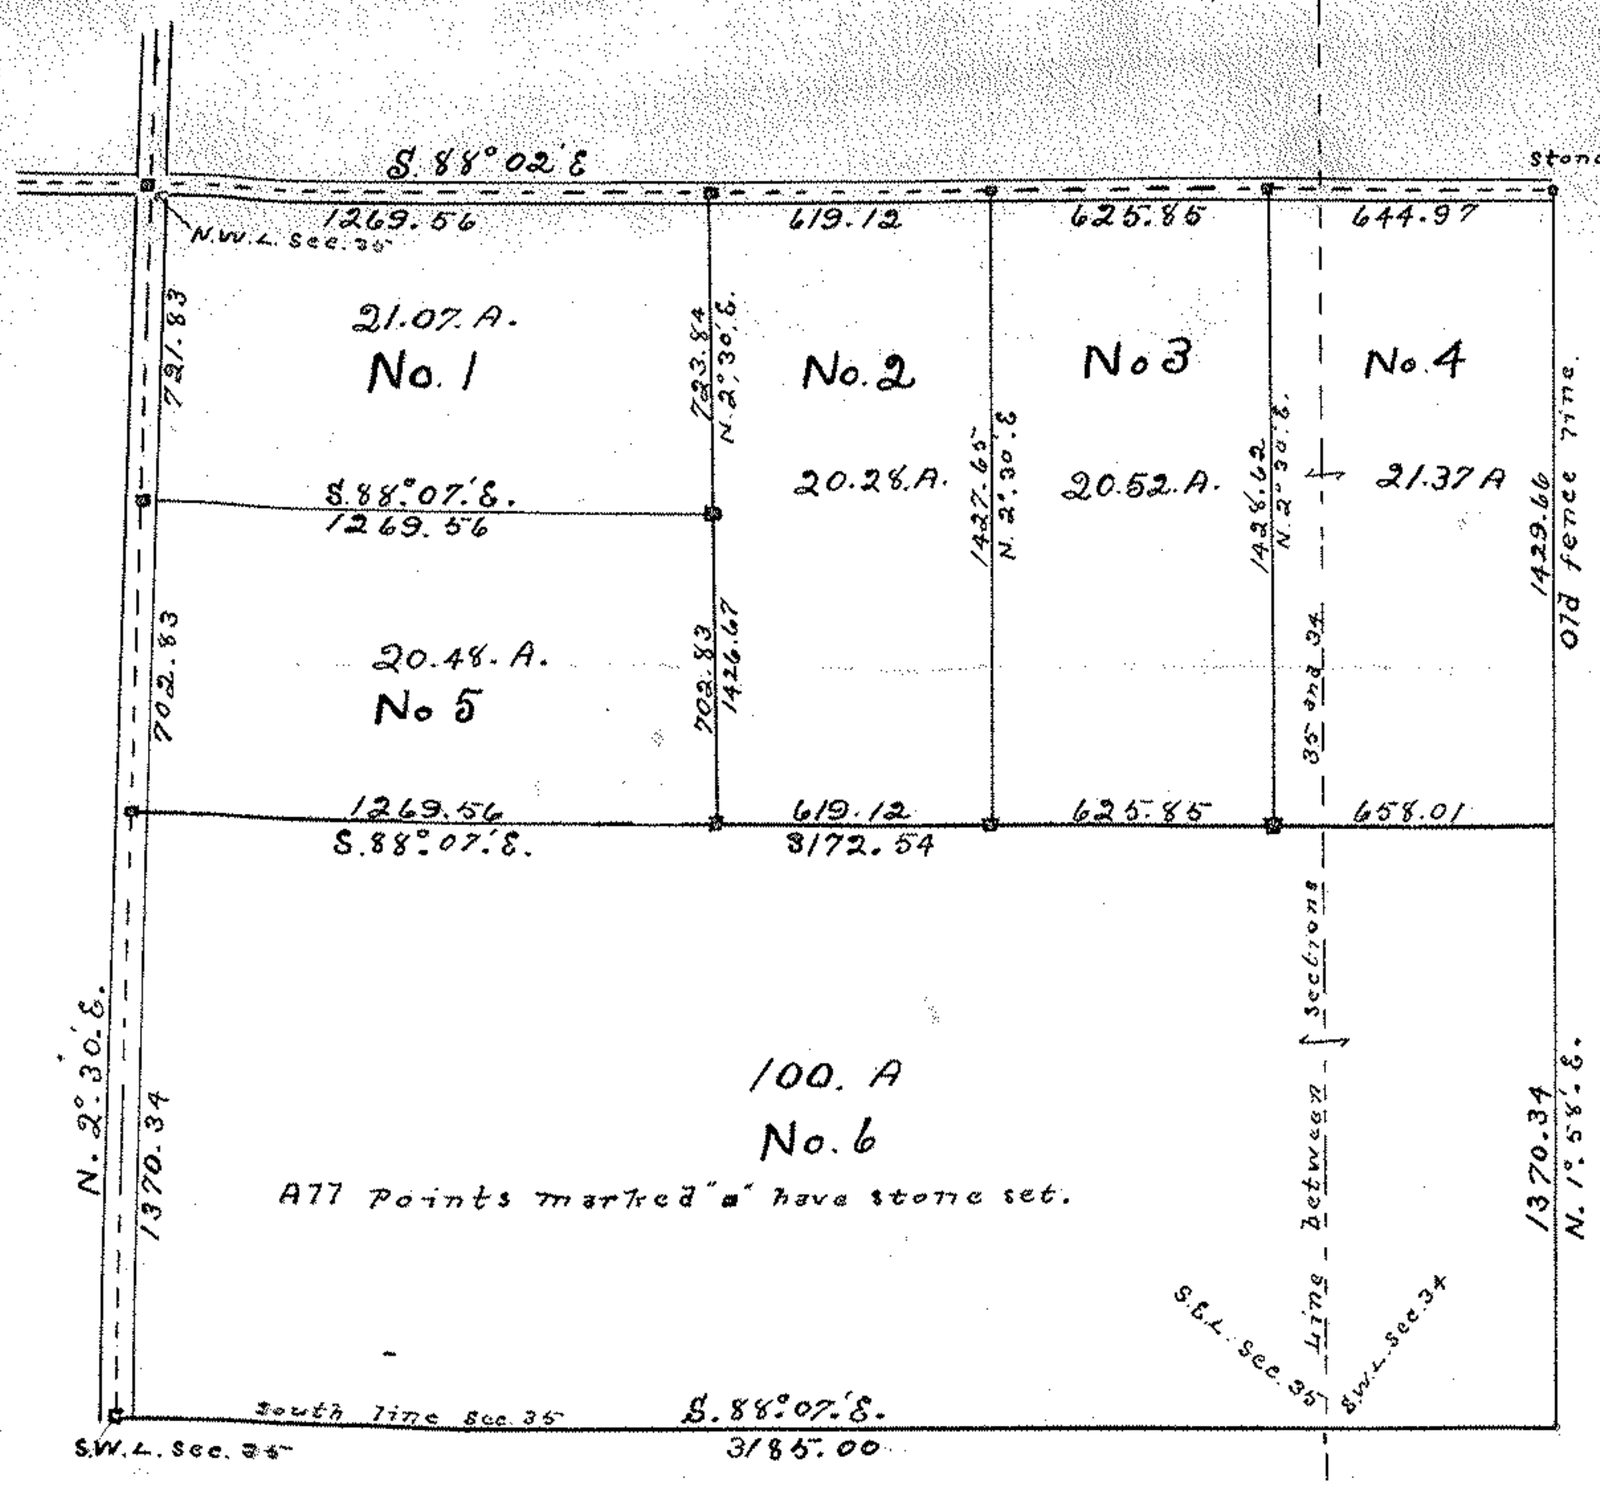


Surveyed on the 2nd & 3rd days of May 1904 and divided as instructed by the Adm. of said Estate

H. W. Mowery Sur.

PPN 15-00-034-000.???
15-00-035-000.???

Map Pg 15-00-034-A
035-B

A-695

800