


872-18

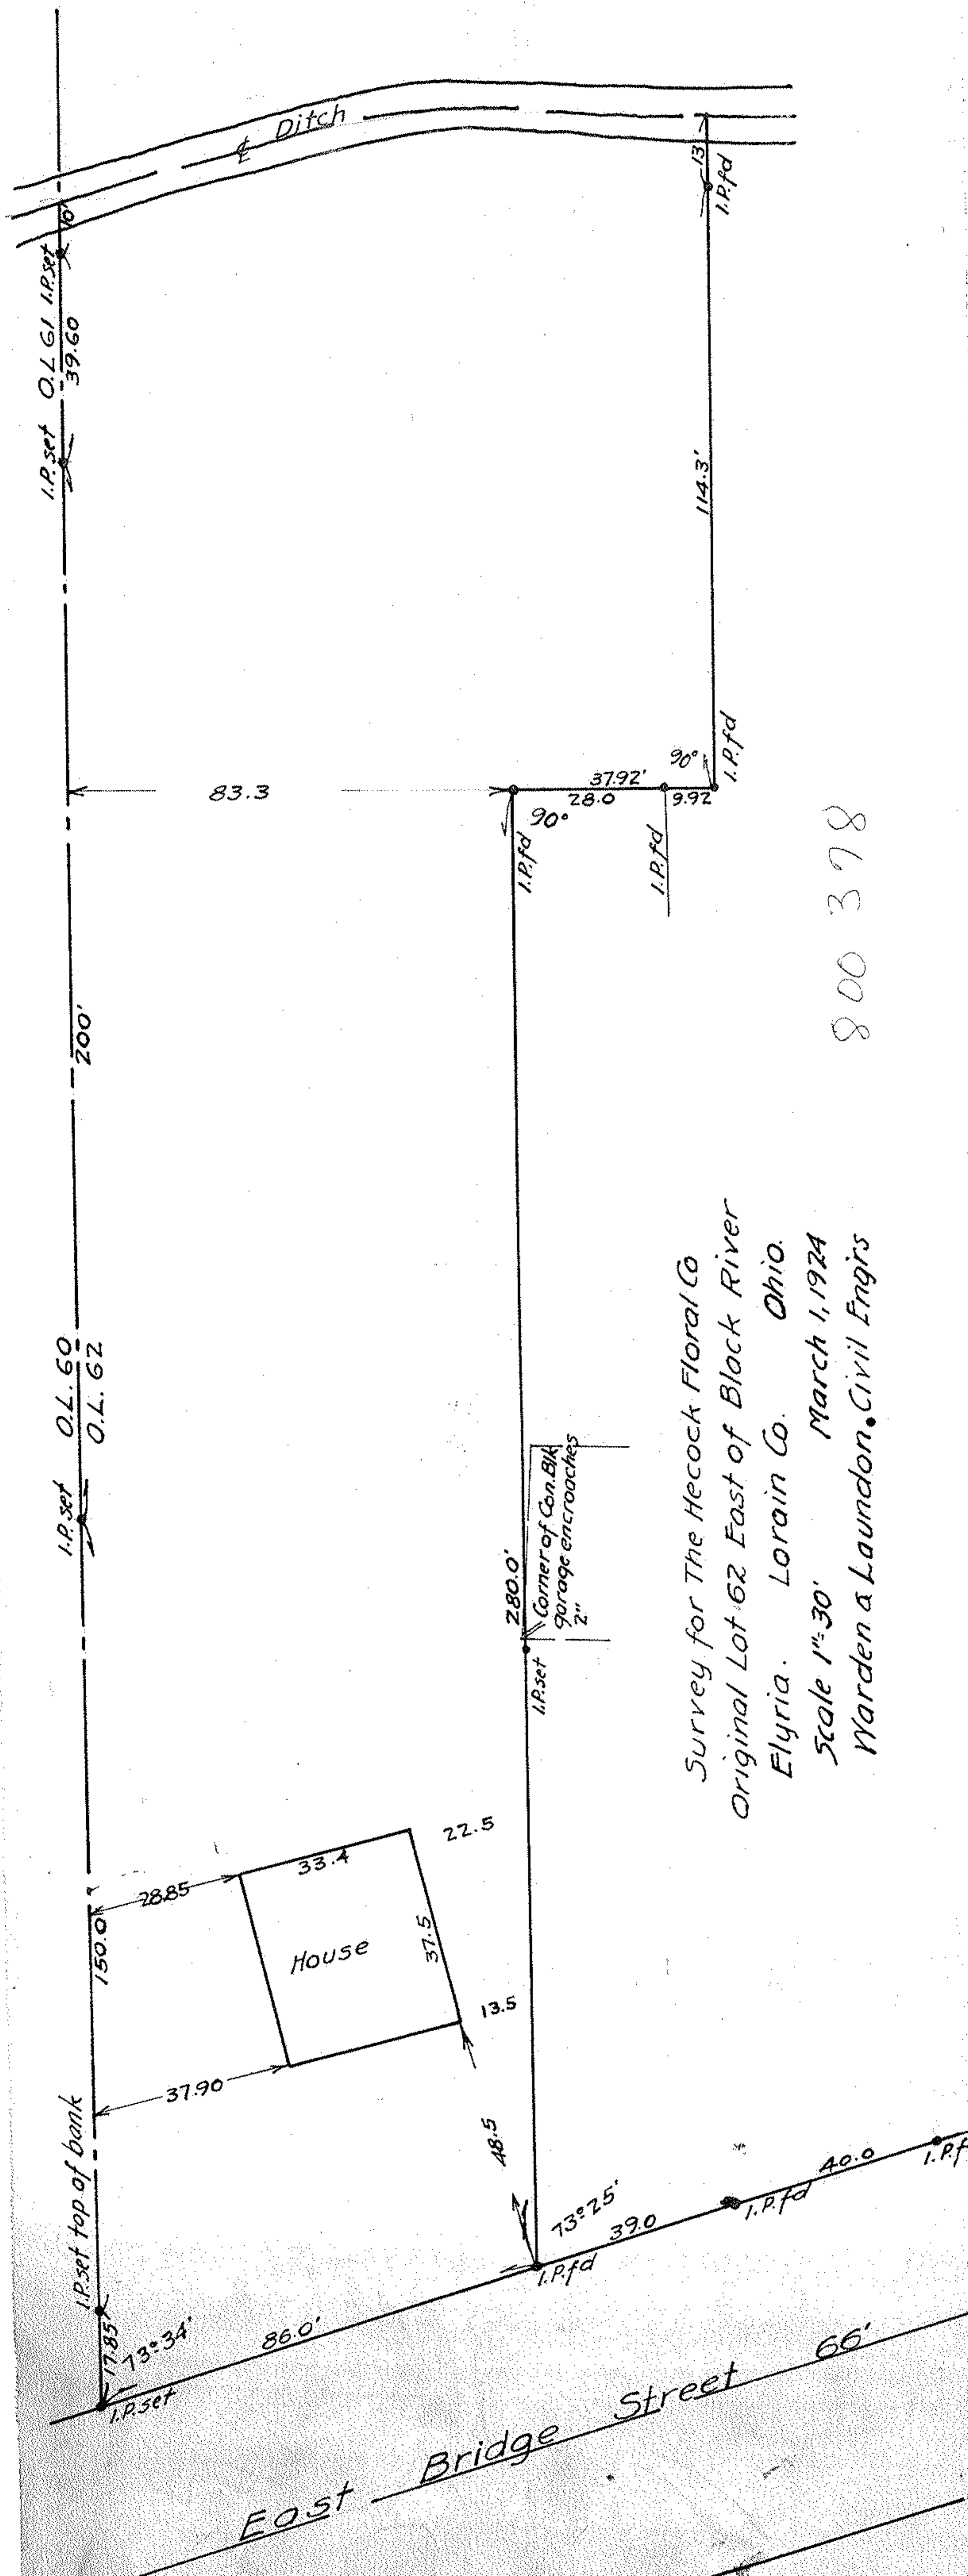

Survey for The Hecock Floral Co  
 Original Lot 62 East of Black River  
 Elyria. Lorain Co. Ohio.  
 Scale 1"=30' March 1, 1924  
 Warden & Laundon, Civil Engrs

800 378