Survey for

RICHARD ZEROLL

Lots 178-179-180 Origonal Lot 24

Harris Heirs Addn

Village of Amherst Lorain, Co. Ohio

Jan. 11, 1918. Warden & Laundon Surveyors.

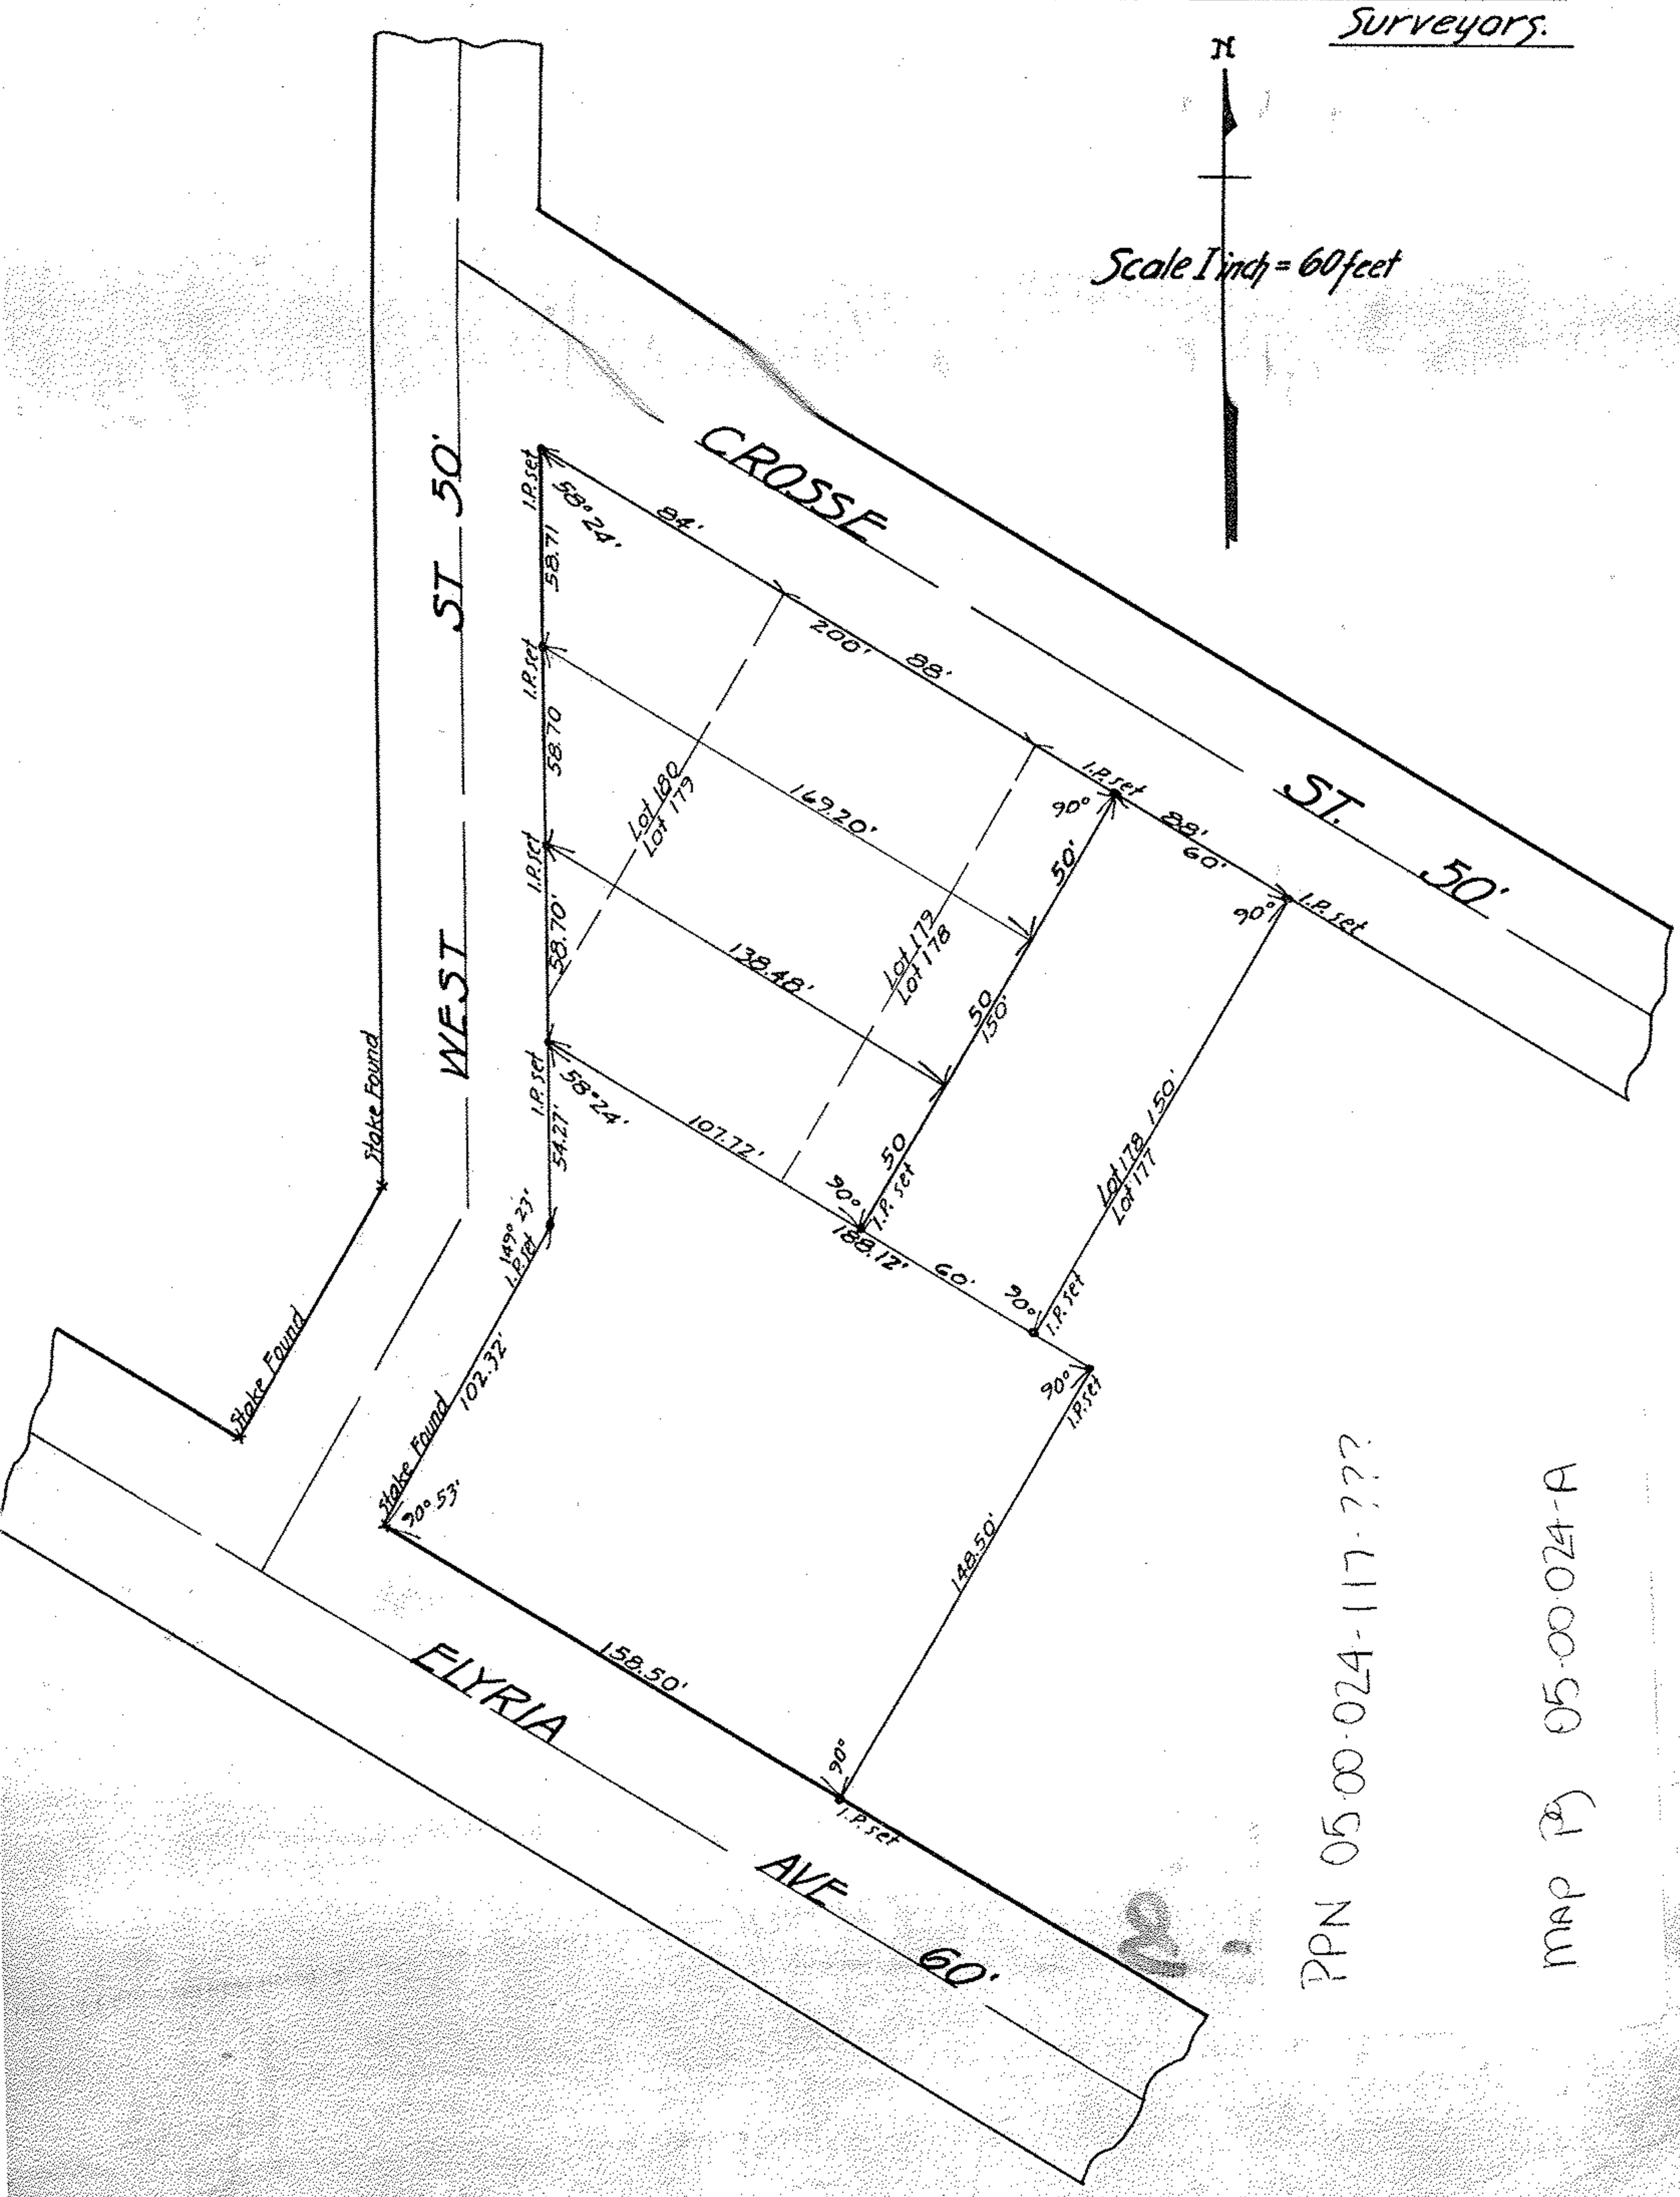

PPN 05-00-024-117.222

Map (2) 05-00-024-A