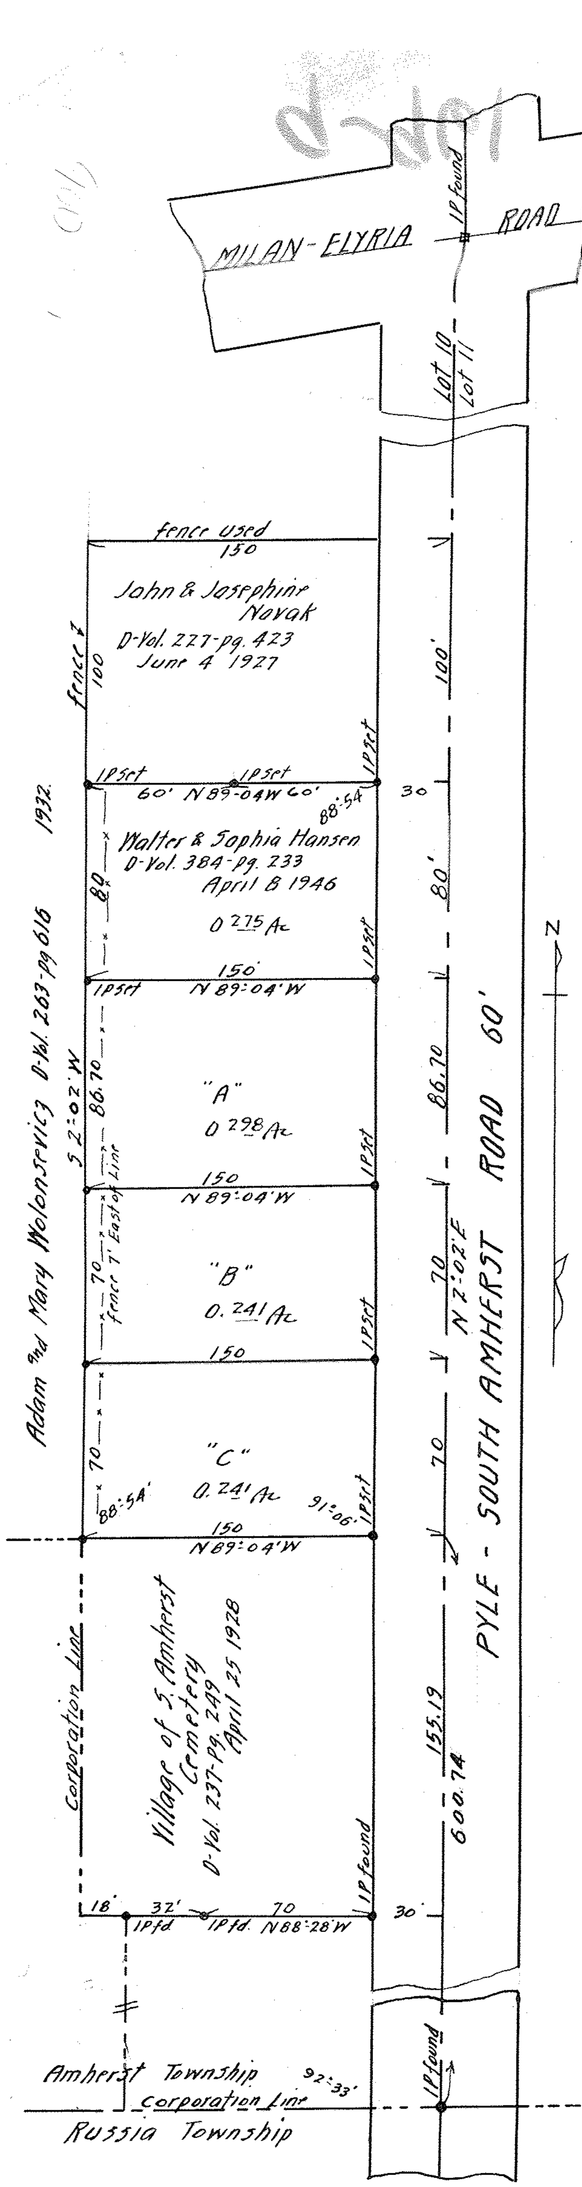

Survey For
JOHN & DOROTHY BOZICEVICH
D-Vol 382-Pg. 524 March 14 1946
Lot 10 South Amherst Village
Lorain County Ohio
Scale 1" = 50' July 29 1946
J. M. Warden, Registered Surveyor