


112606

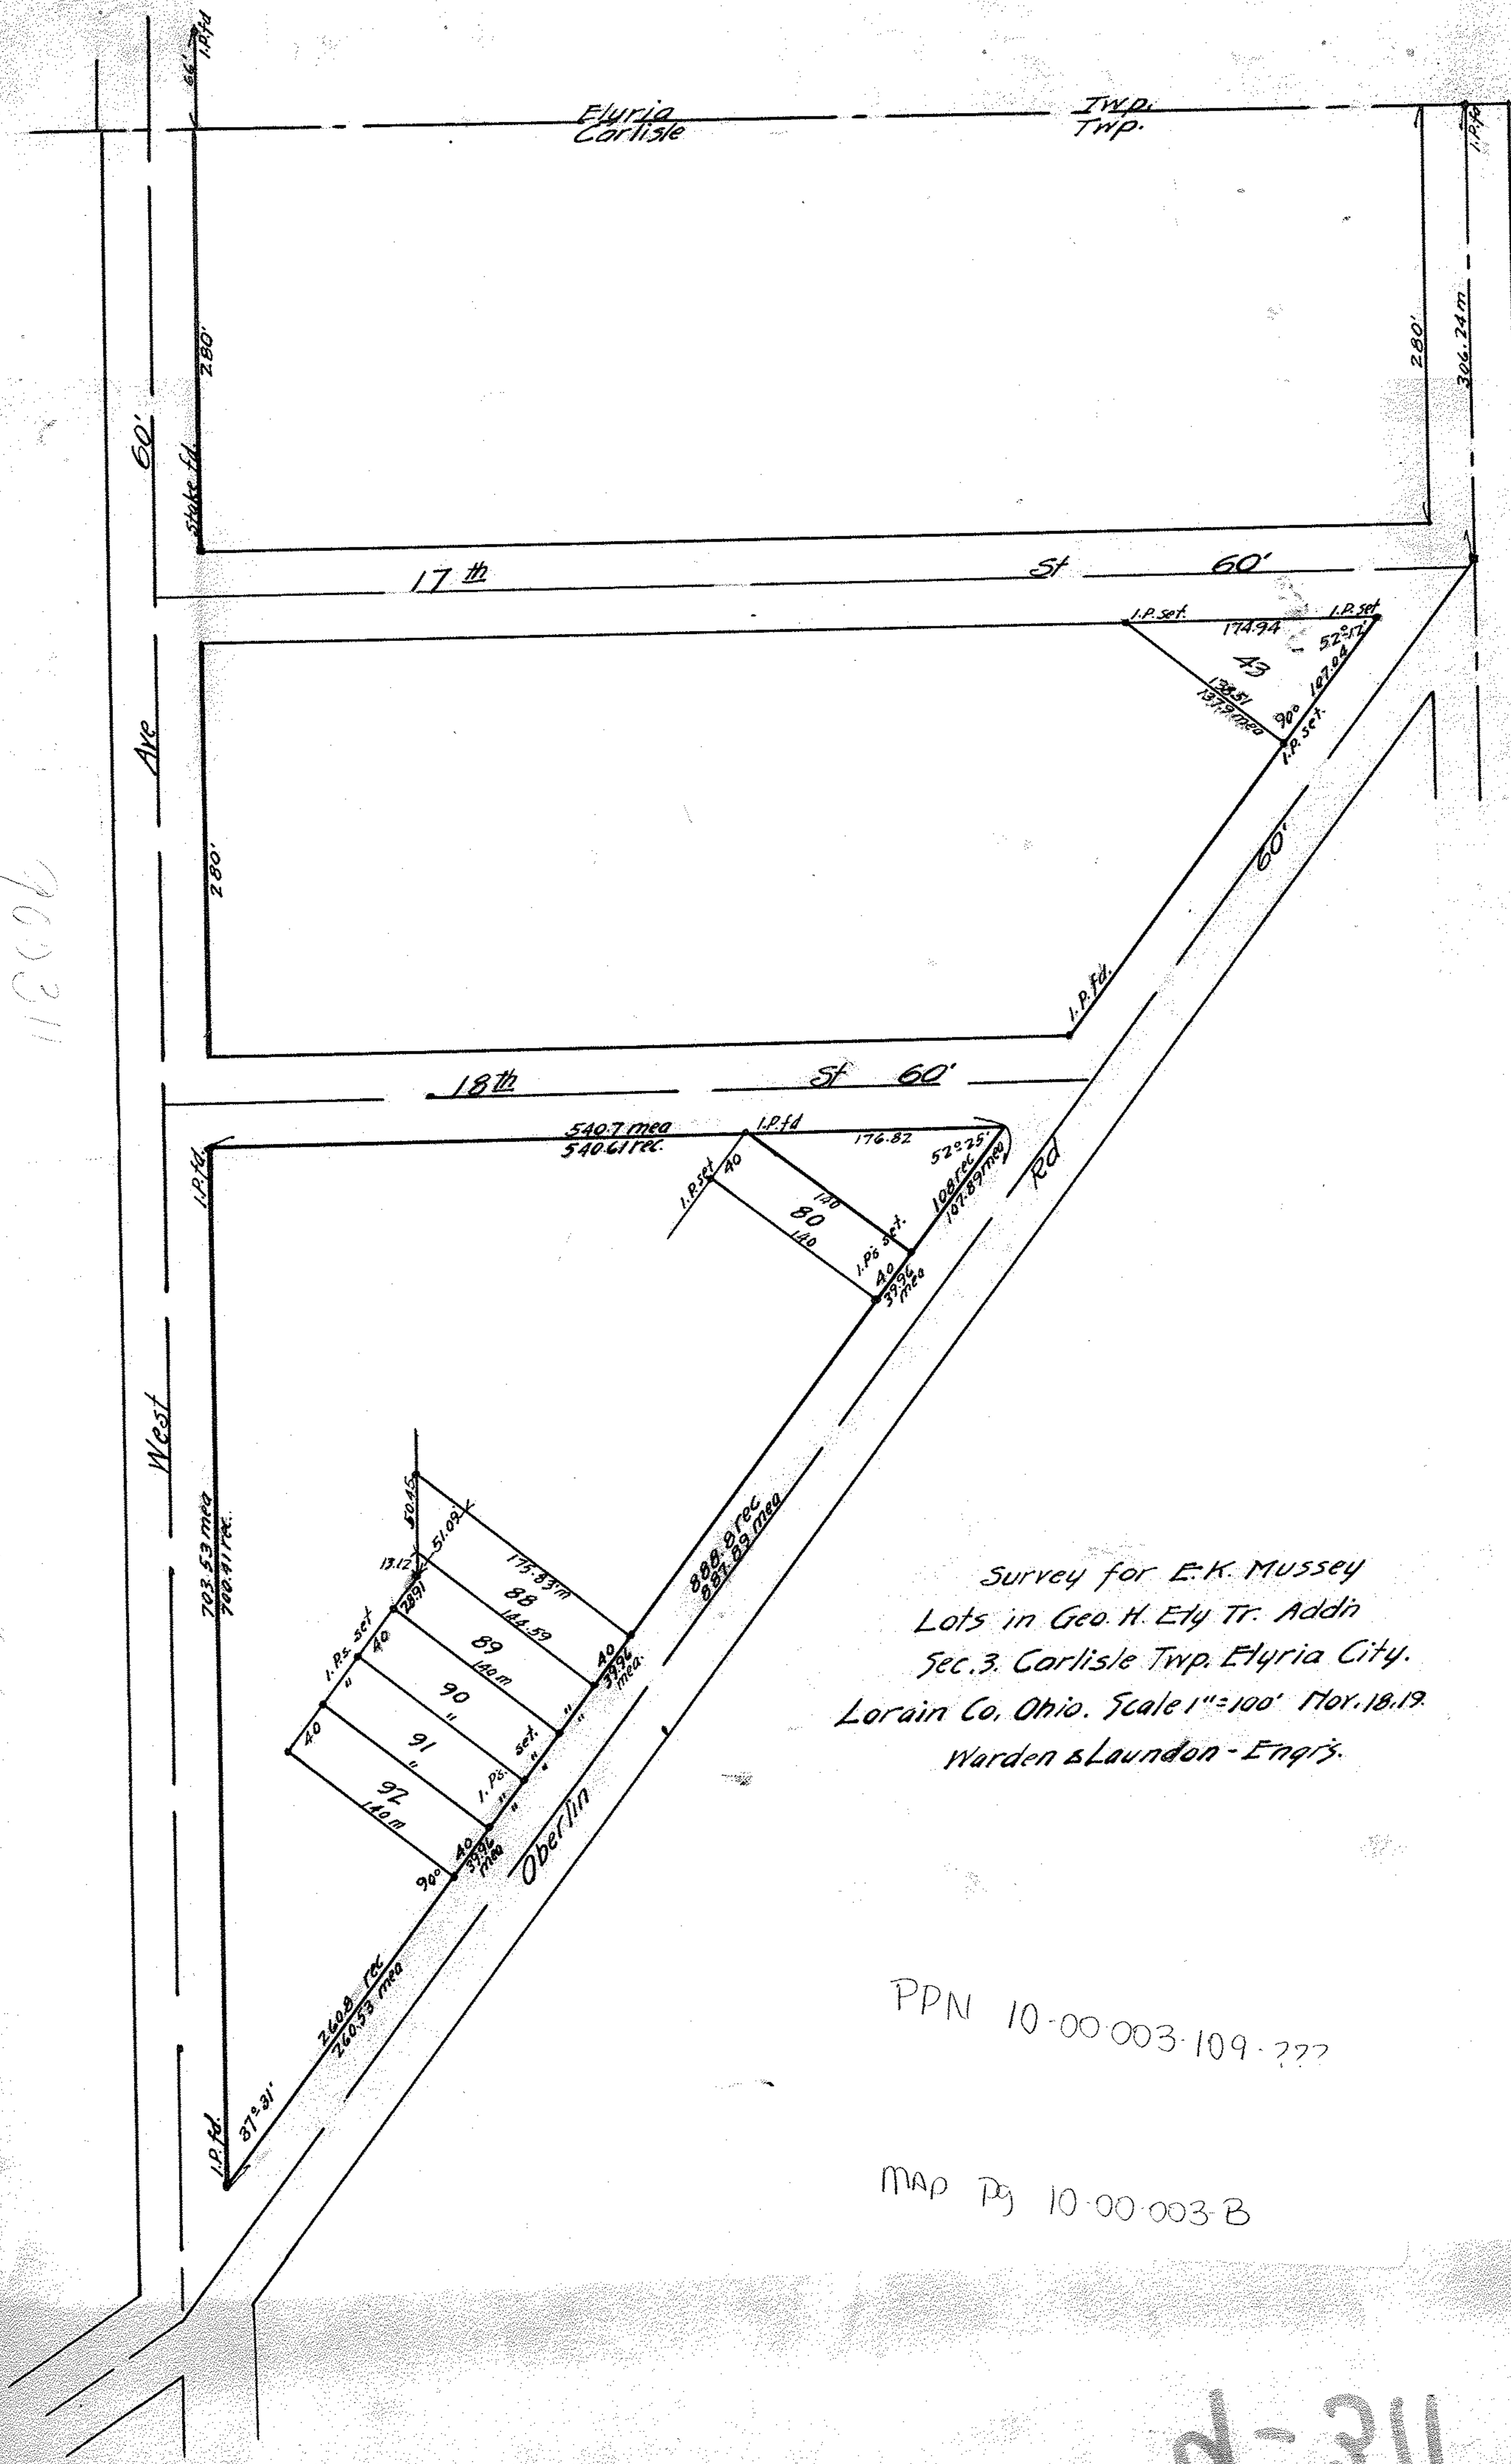

Survey for E. K. Mussey
 Lots in Geo. H. Ely Tr. Addn
 Sec. 3, Carlisle Twp. Elyria City,
 Lorain Co, Ohio. Scale 1"=100' Nov. 18, 19.
 Warden & Laundon - Engr's.

PPN 10-00-003-109-???

MAP Pg 10-00-003-B

d-311