800 406

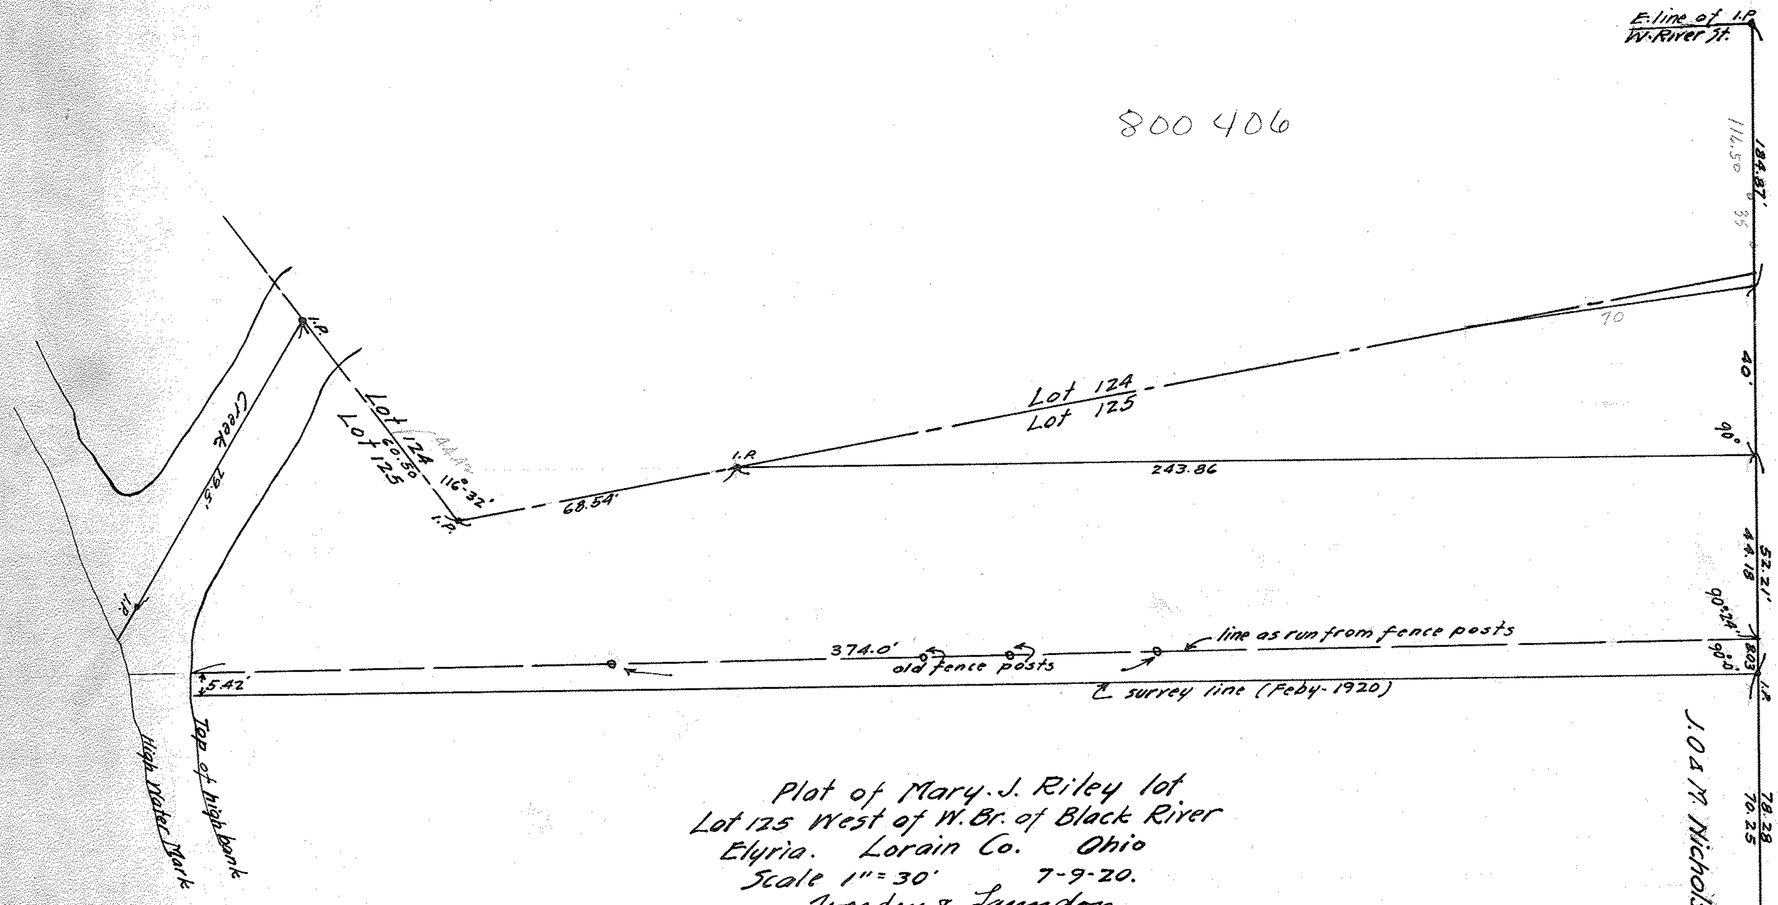

Plat of Mary J. Riley lot
Lot 125 West of W. Br. of Black River
Elyria. Lorain Co. Ohio
Scale 1" = 30' 7-9-20.
Warden & Saunders
Civil Engrs.

PPN 06-26-125-000-001
006

MAP PG 6-100

LODI ST 66'

114.50
35
70

902-2