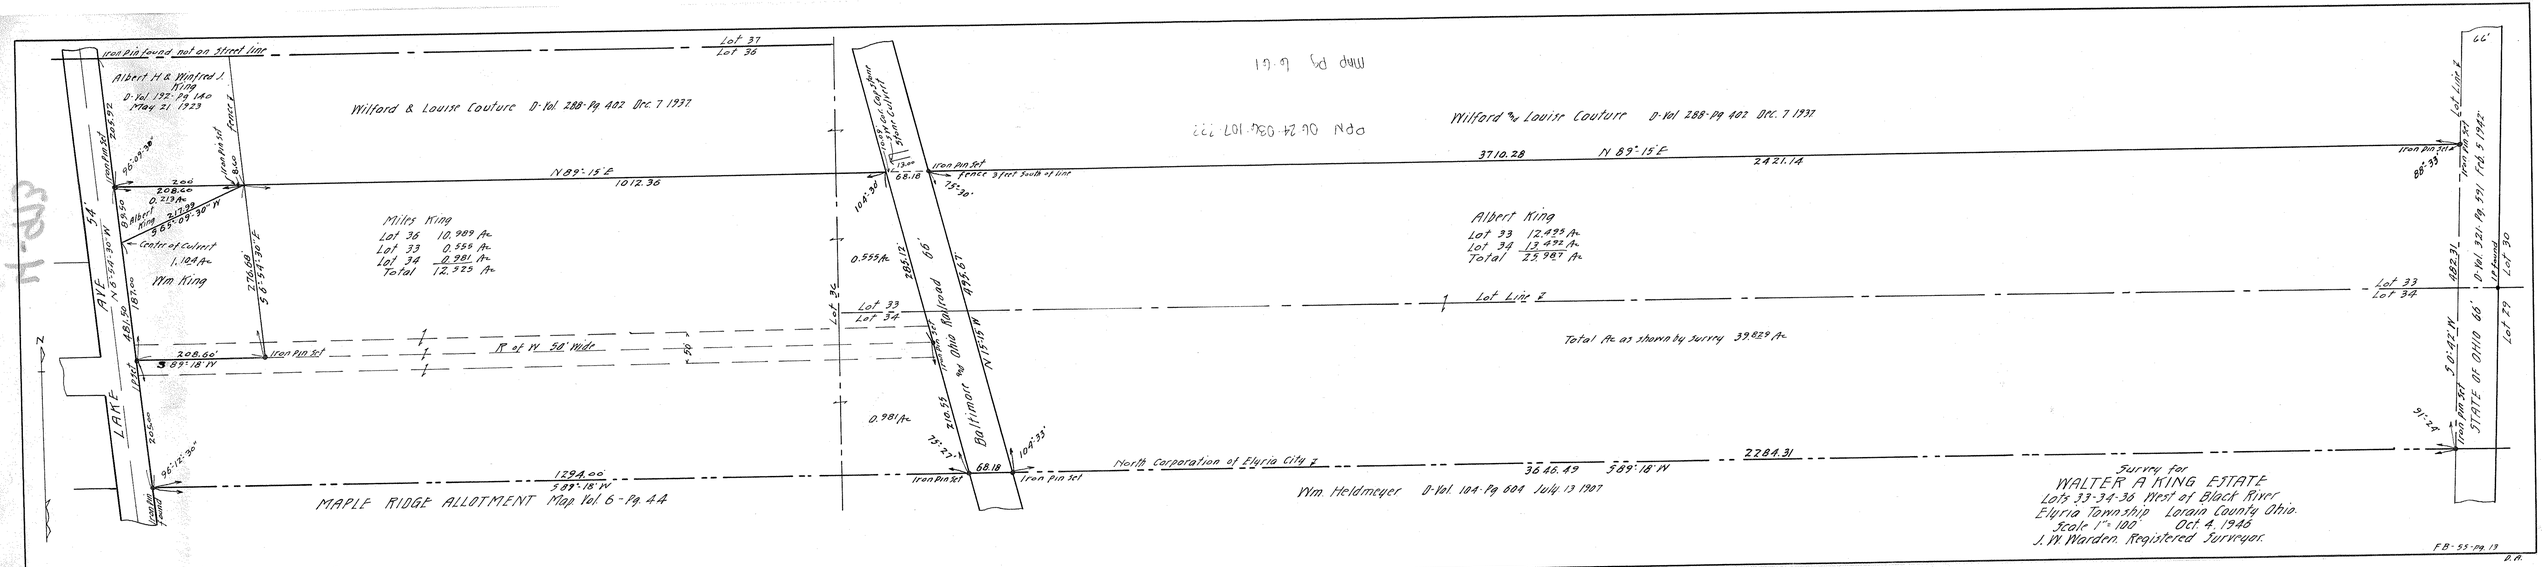
Iron Pin found not on Street line
Lot 37
Lot 36
Albert H & Winfred J. King
D-Vol 192-Pg 140
May 21 1923
Wilford & Louise Couture D-Vol 288-Pg 402 Dec. 7 1937
Fence 1
Iron Pin Set
N 89°-15' E
1012.36
Center of Culvert
1.104 Ac
Wm King
Miles King
Lot 36 10.989 Ac
Lot 33 0.555 Ac
Lot 34 0.981 Ac
Total 12.525 Ac
Lot 36
Lot 33
Lot 34
R of W 50' Wide
S 89°-18' W
LANE
MAPLE RIDGE ALLOTMENT Map Vol 6-Pg 44
Baltimore & Ohio Railroad
Wilford & Louise Couture D-Vol 288-Pg 402 Dec. 7 1937
3710.28
N 89°-15' E
2421.14
Fence 3 feet South of line
Albert King
Lot 33 12.495 Ac
Lot 34 13.492 Ac
Total 25.987 Ac
Lot Line Z
Total Ac as shown by Survey 39.829 Ac
North Corporation of Elyria City Z
3646.49
S 89°-18' W
2284.31
Wm Heldmeyer D-Vol 104-Pg 604 July 13 1907
Survey for
WALTER A KING ESTATE
Lots 33-34-36 West of Black River
Elyria Township Lorain County Ohio.
Scale 1" = 100' Oct. 4. 1946
J. W. Warden. Registered Surveyor.
FB-55-Pg 13
D.R.
STATE OF OHIO 66'
D-Vol 321-Pg 591 Feb 5 1942
Lot 29
Lot 30
Lot 33
Lot 34
Lot Line Z
Iron Pin Set
Iron Pin Found
N