


400433D

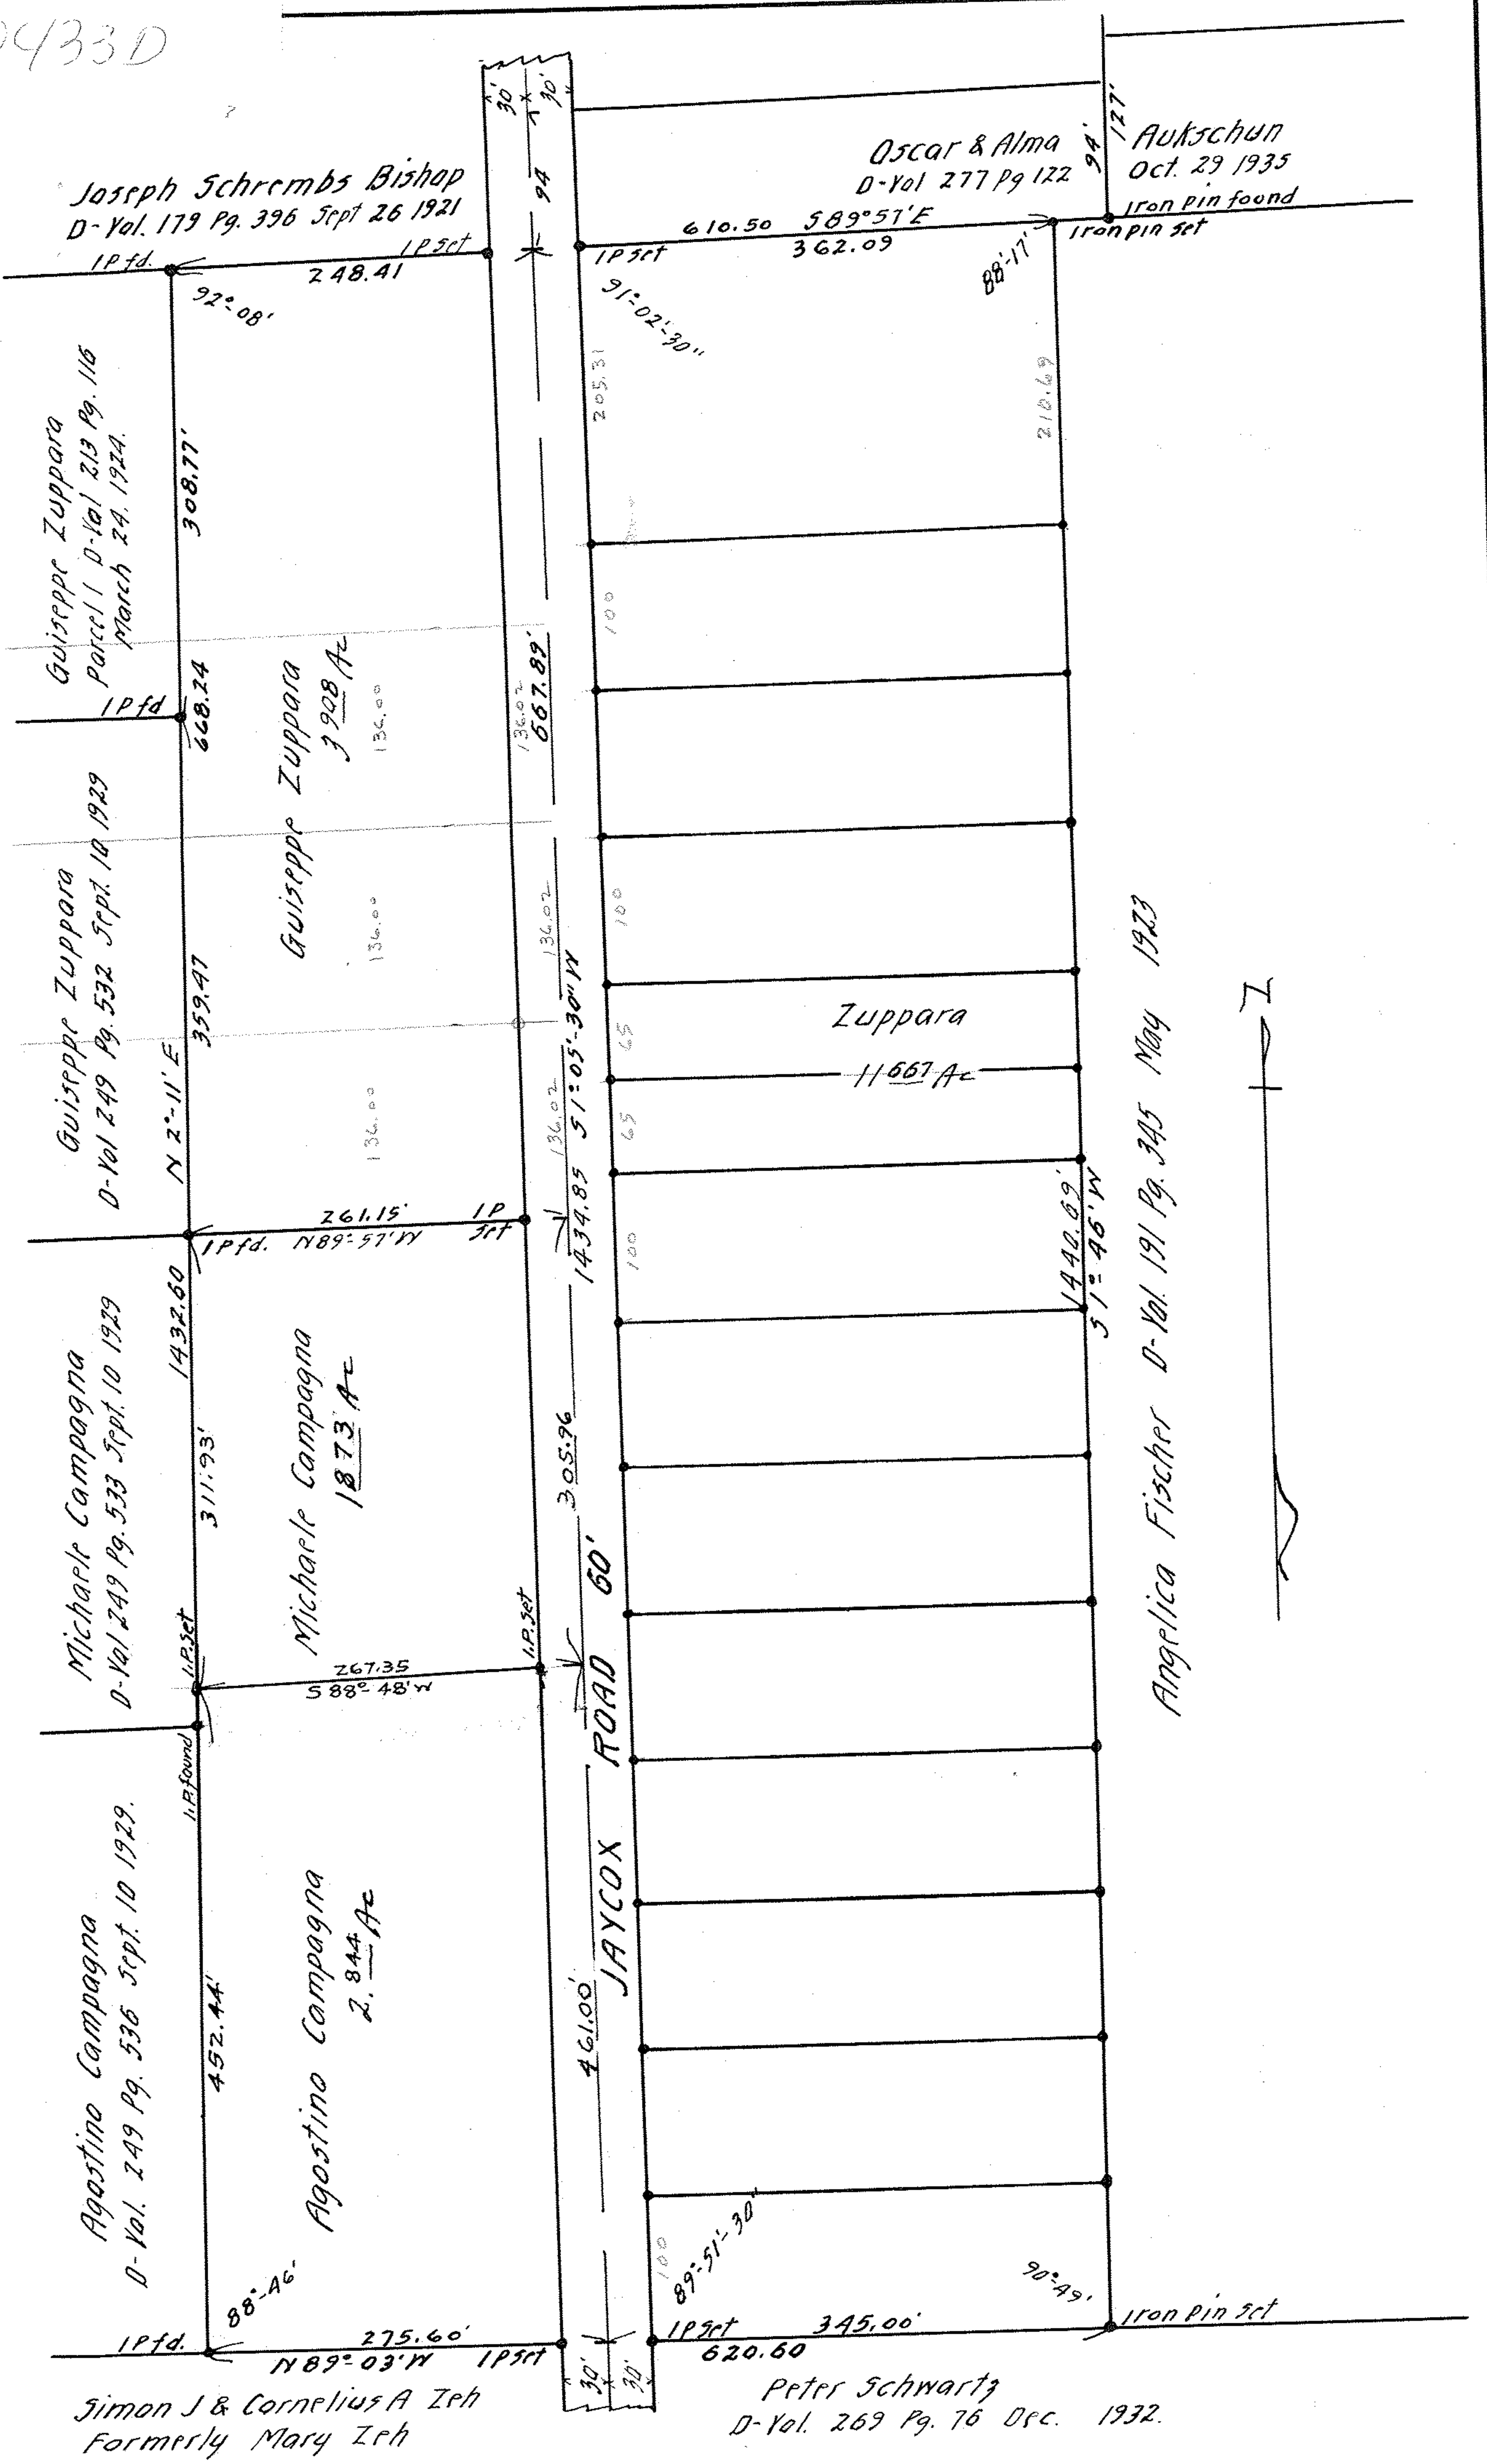

PPN 04-00-023-000-???

Map Pg 04-00-023-B

Book 50 Pg. 39